

© 2013 la terra studio, inc. All Rights Reserved FILE: C:\Users\rcunningham\Documents\12024-Downtown Rockwall PS&E - Rockwall\CAD\Sheet\12024-Strt_Details_10.dwg


submittals / revisions

no.	date	detail
1	07/31/14	LASI #10

la terra studio, inc.


12024
 its project number
 02.26.2014
 date
 rac; bhm
 drawn by
 mtb
 checked by

registration

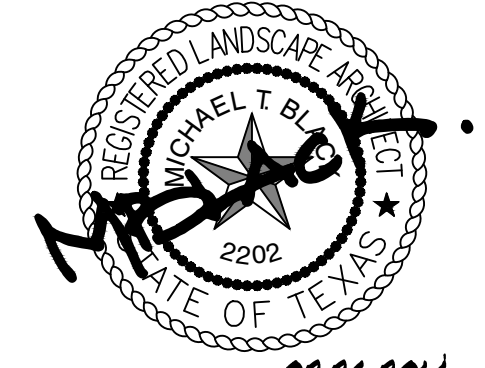


02.26.2014
 sheet title


Site Details
 sheet number
SD-10

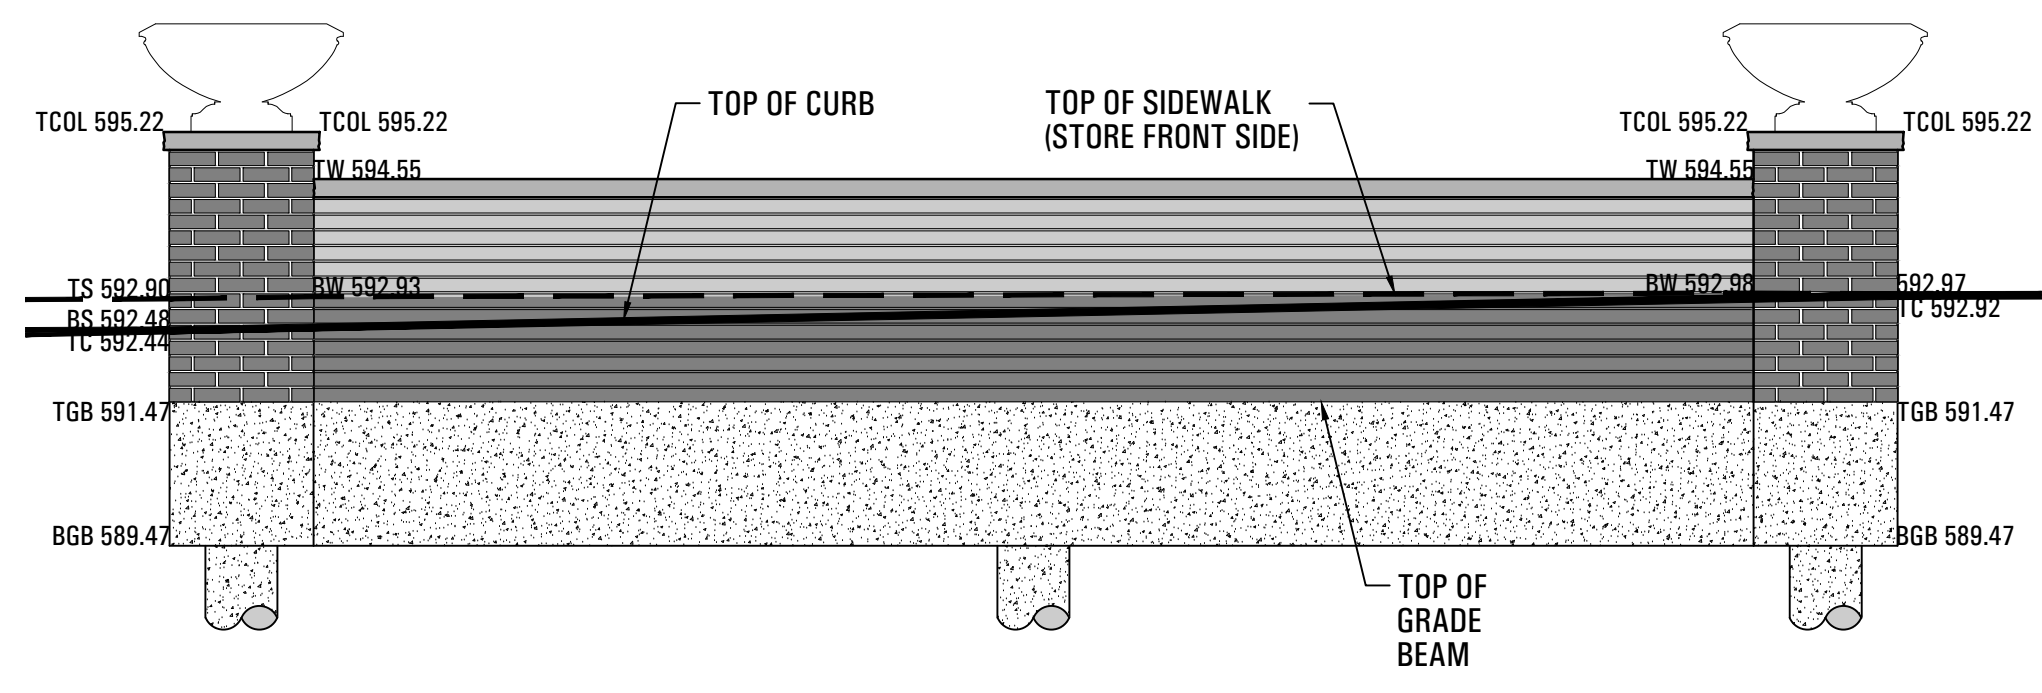


1 WALL ELEVATION - 114 E. RUSK ST.
 SCALE: 3/8" = 1'-0"

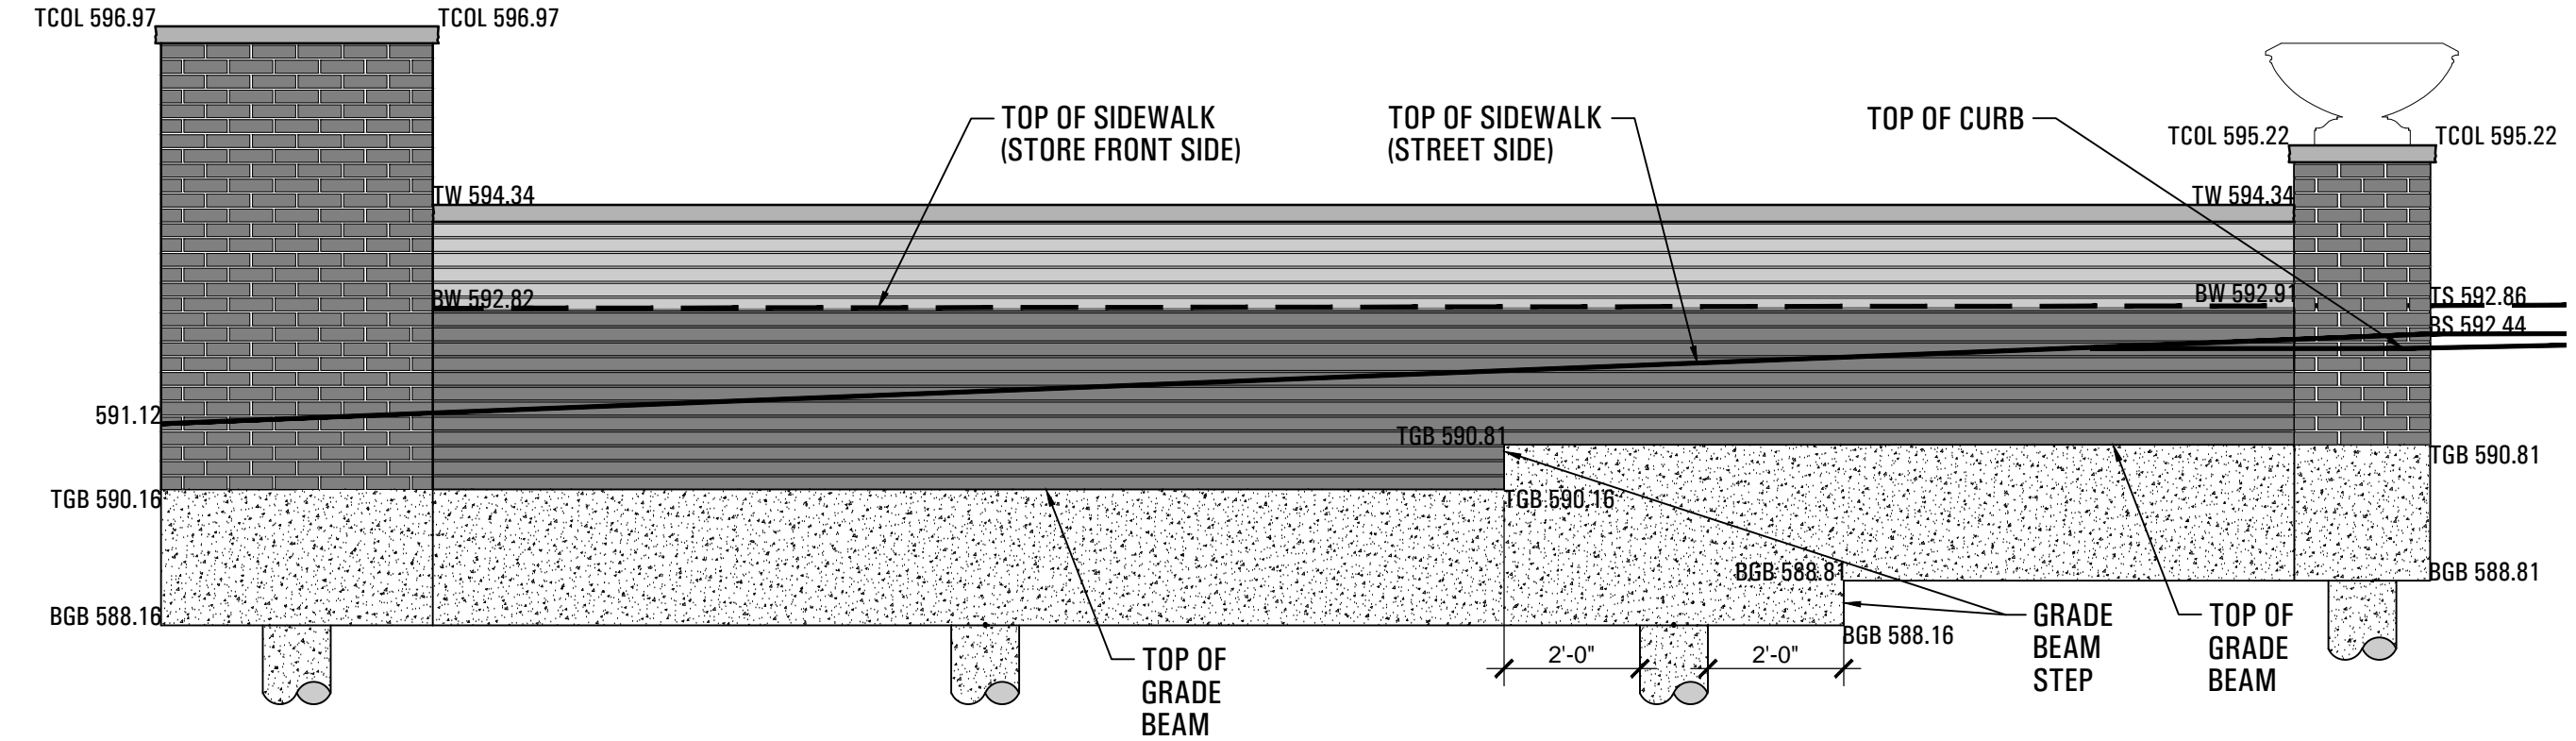


2 WALL ELEVATION - 116 E. RUSK ST.
 SCALE: 3/8" = 1'-0"

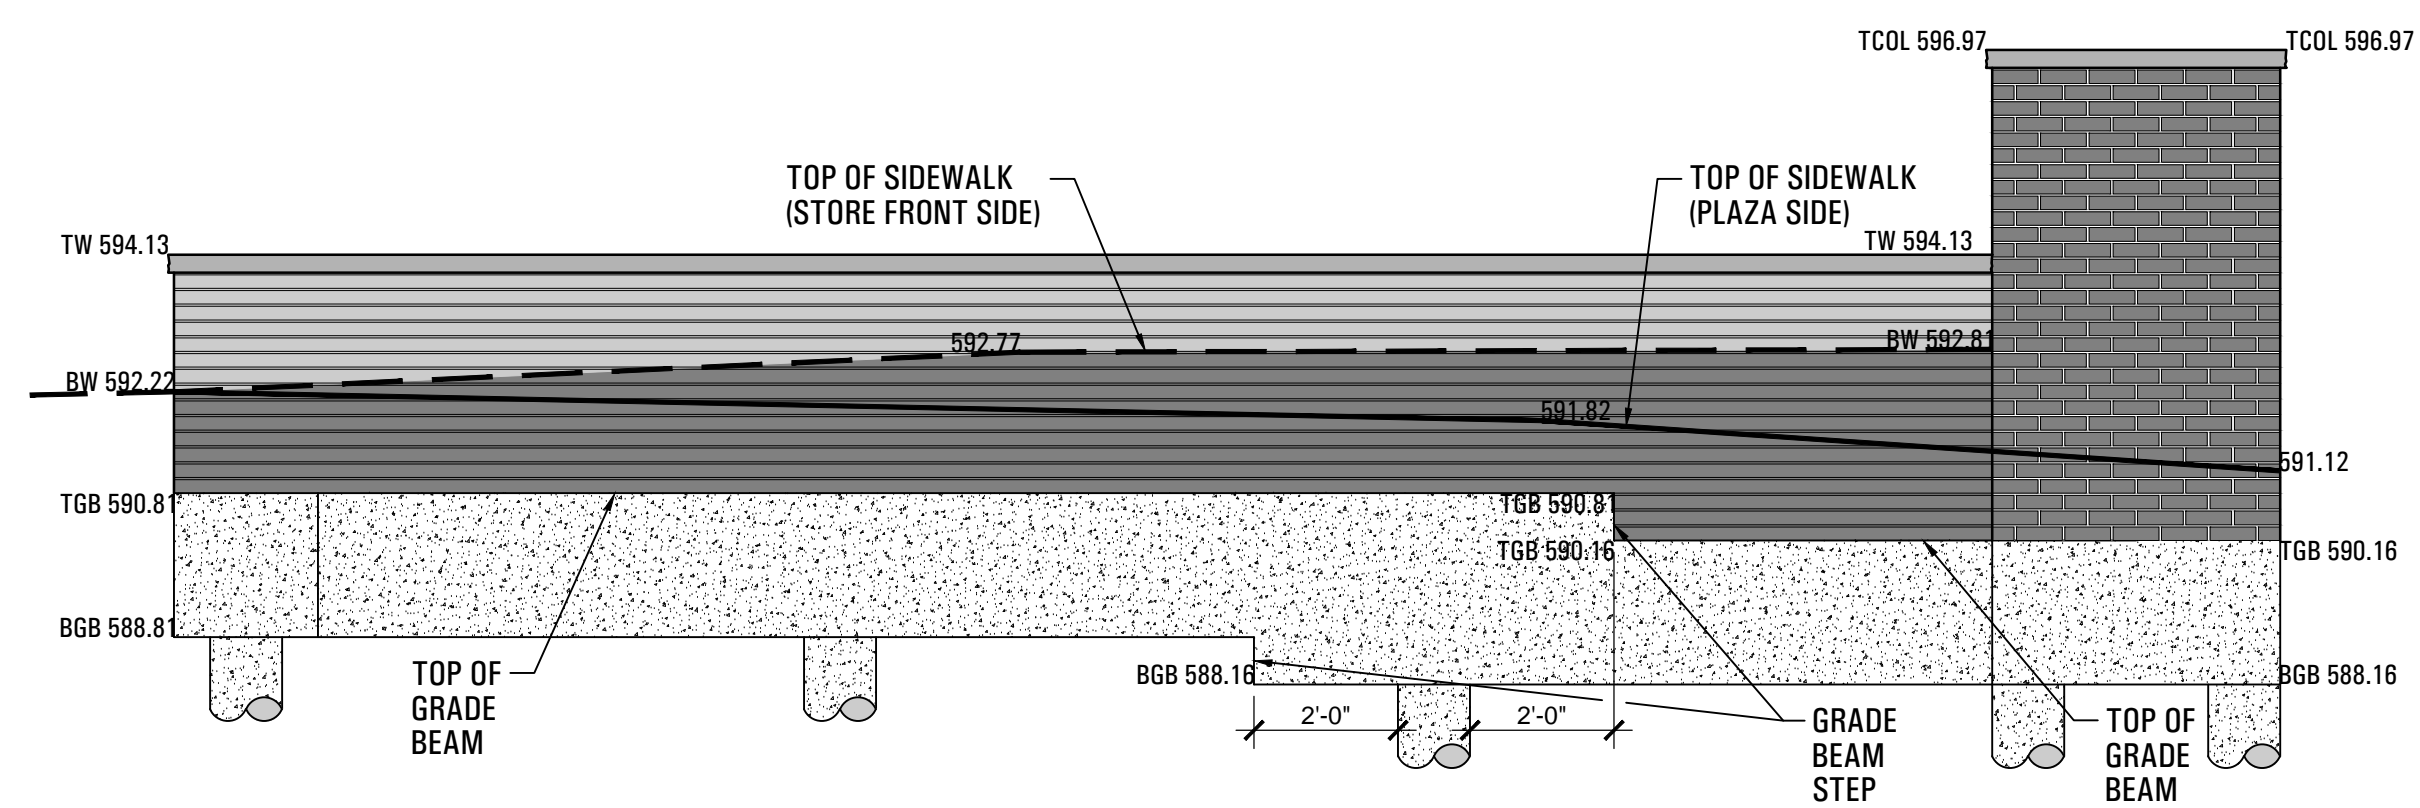


3 WALL ELEVATION - 118 E. RUSK ST.
 SCALE: 3/8" = 1'-0"

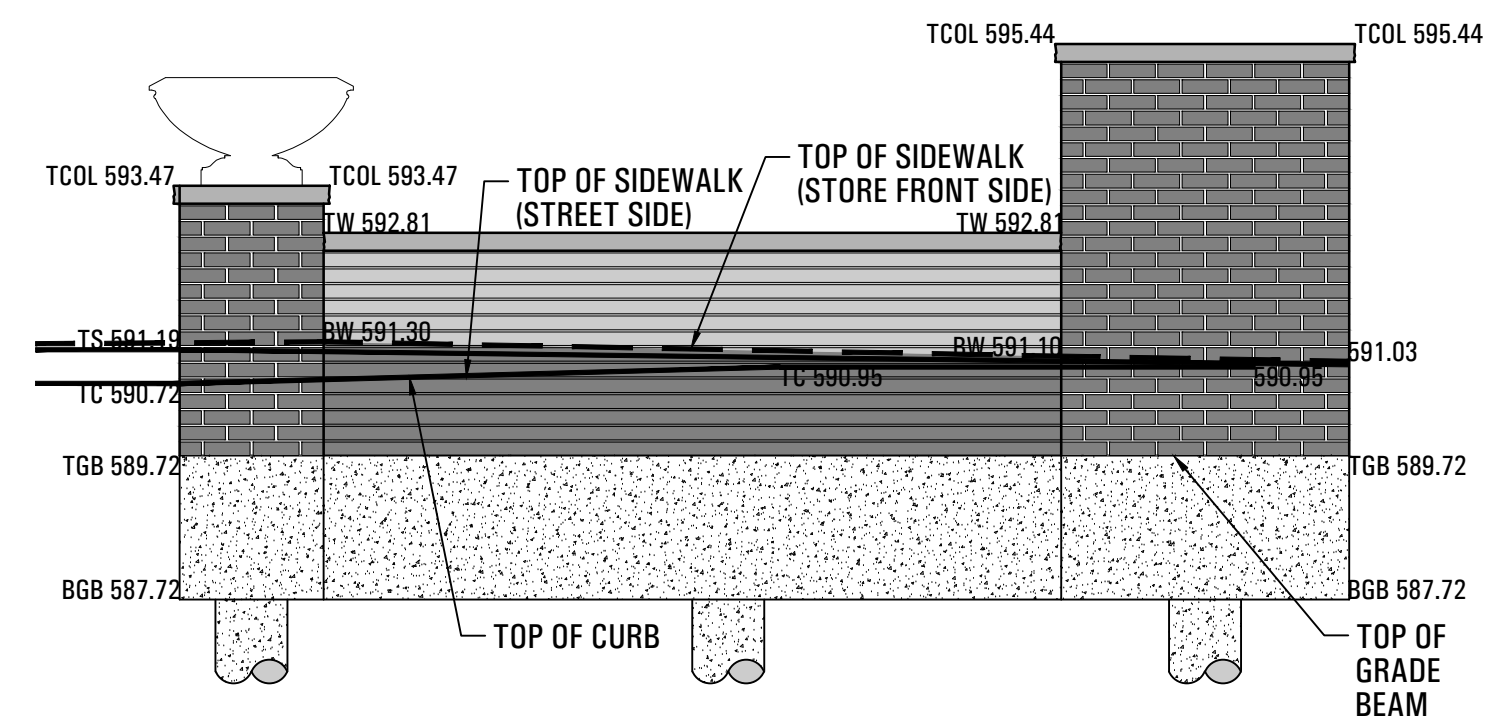


4 WALL ELEVATION - 202 E. RUSK ST.
 SCALE: 3/8" = 1'-0"

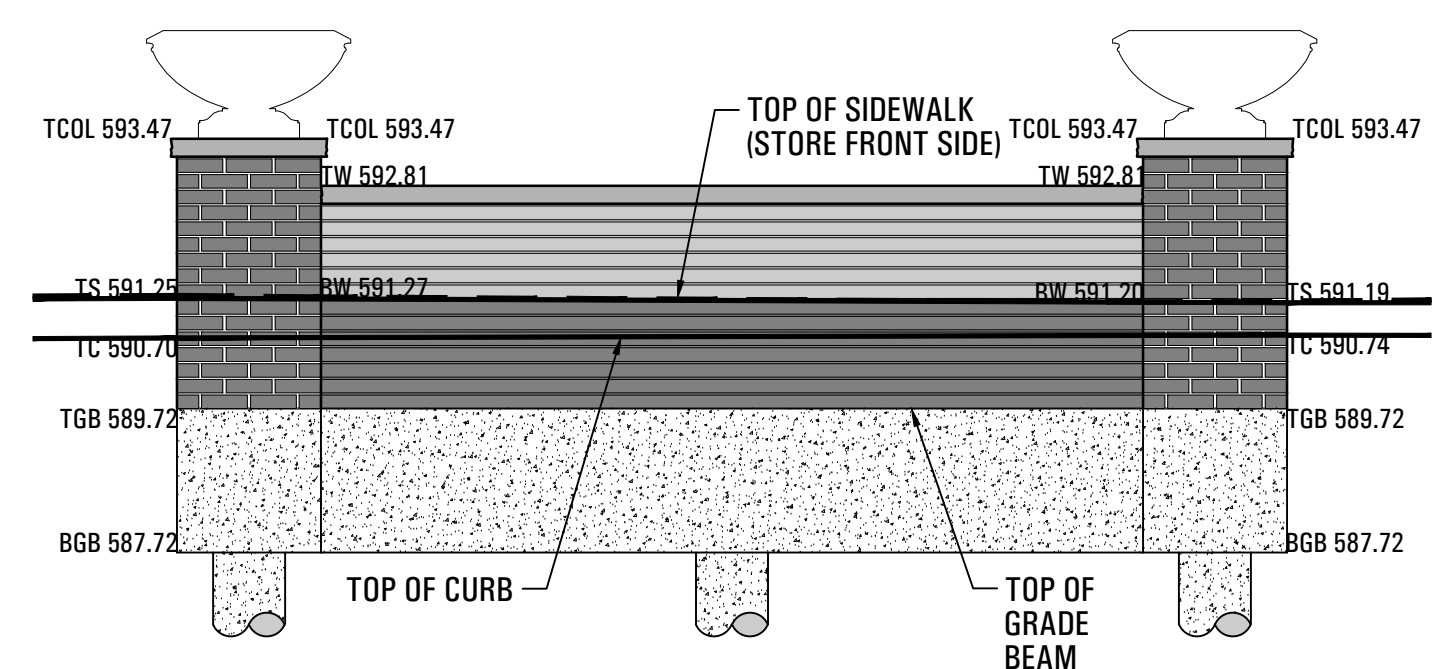

5 WALL ELEVATION - 204 E. RUSK ST.
 SCALE: 3/8" = 1'-0"

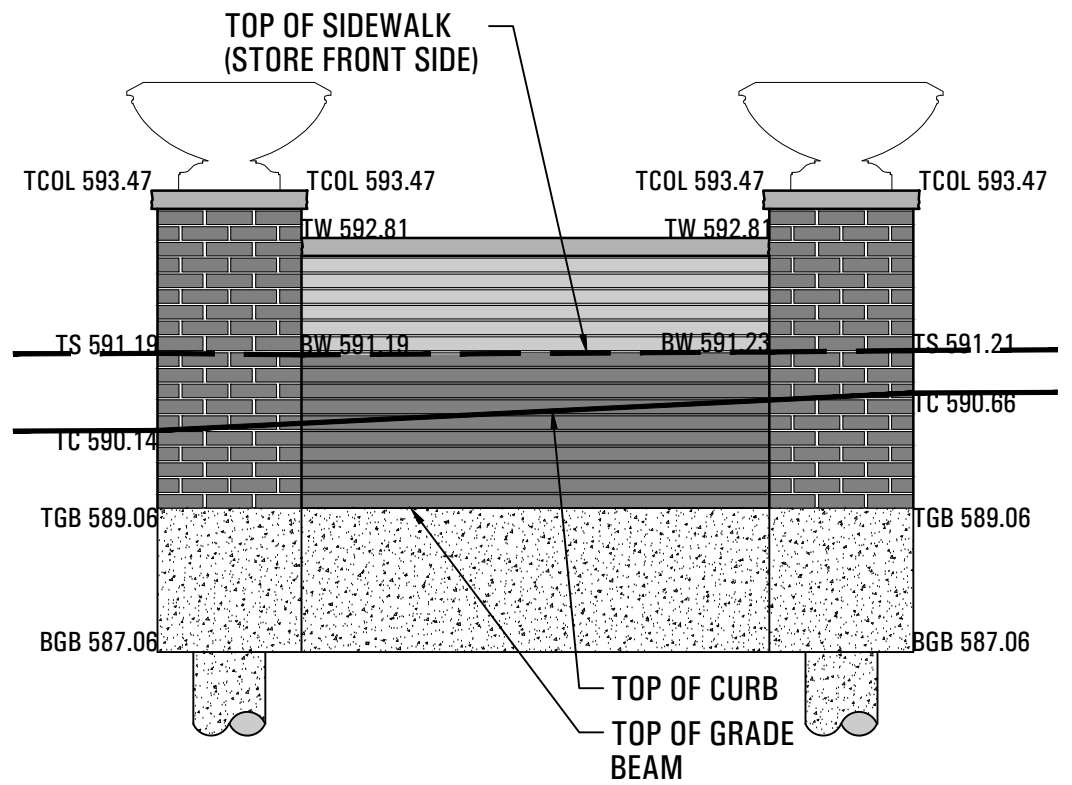

6 WALL ELEVATION - 206 E. RUSK ST.
 SCALE: 3/8" = 1'-0"

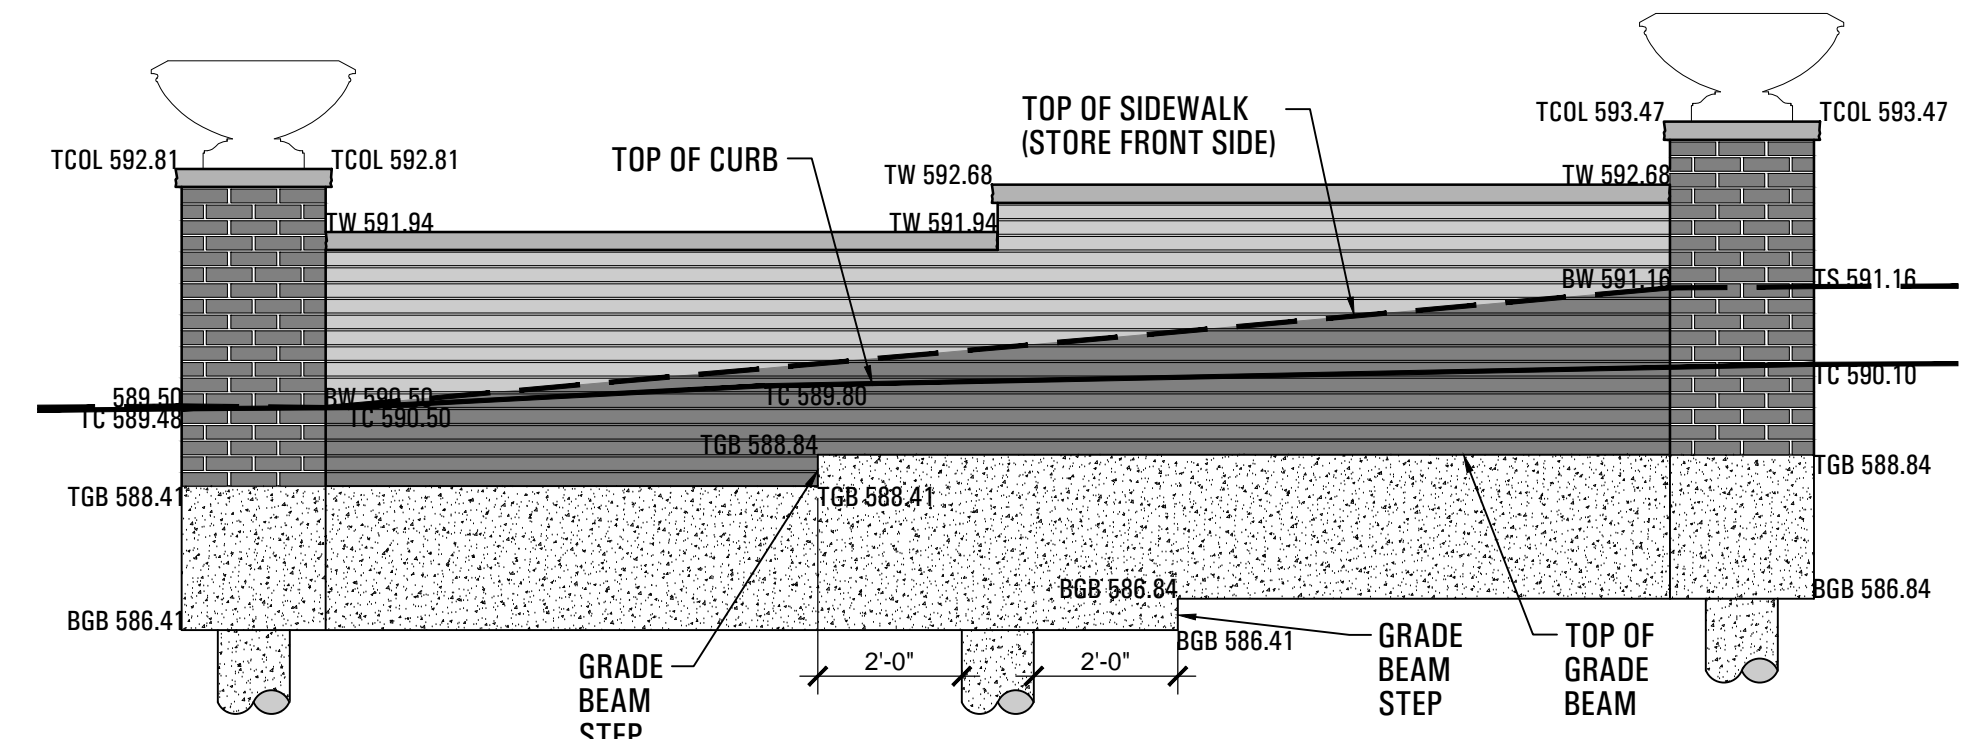

7 WALL ELEVATION - 210 E. RUSK ST.
 SCALE: 3/8" = 1'-0"