


SITE PLAN LEGEND:

- EDGE OF PAVEMENT
- CONCRETE SIDEWALK PAVEMENT
- CONCRETE VEHICULAR PAVEMENT
- TYPICAL LIGHT FIXTURE

1 ENLARGEMENT PLAN
SCALE: 1" = 10'-0"

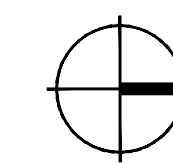

Downtown Rockwall
la terra studio Project #12024
streetscape improvements
PHASE 2
rockwall, texas



submittals / revisions

no.	date	detail
△	05/13/14	RFI #51
△	09/16/14	RFI #121, #125
△	11/26/14	LASI #12

la terra studio, inc.

12024
Its project number
02.26.2014
date
rac; bhm
drawn by
mtb
checked by

registration



Enlargement Plan
sheet number

EP-2