

**(A) TRASH RECEPTACLE (19 TOTAL):**

RECEPTACLE, FLAT TOP, 36 GALLON  
 MODEL: CV2-2000-PF  
 FINISH: BLACK POWDER COAT  
 MANUFACTURER: SITESCAPES  
 CONTACT: BRITNEY NOVACEK 888.331.9464

**(B) BENCH (2 TOTAL):**

BENCH 4' BACKED BENCH, CAST IRON ENDS  
 MODEL: CV1-3010-PF  
 FINISH: BLACK POWDER COAT  
 MANUFACTURER: SITESCAPES  
 CONTACT: BRITNEY NOVACEK 888.331.9464

**(C) BENCH (8 TOTAL):**

BENCH 6' BACKED BENCH, CAST IRON ENDS  
 MODEL: CV1-1010-PF  
 FINISH: BLACK POWDER COAT  
 MANUFACTURER: SITESCAPES  
 CONTACT: BRITNEY NOVACEK 888.331.9464


**(D) BIKE POST (2 TOTAL):**

BOLLARD BIKE POST, 2 LOOPS  
 MODEL: BP2-02-SM-PF  
 FINISH: BLACK POWDER COAT  
 MANUFACTURER: SITESCAPES  
 CONTACT: BRITNEY NOVACEK 888.331.9464

NOTE:  
 LANDSCAPE ARCHITECT TO APPROVE  
 FINAL PLACEMENT OF SITE FURNISHINGS  
 PRIOR TO INSTALLATION

**SITE FURNISHING LEGEND:**

- SHEETS
- (A) TRASH RECEPTACLE (19)
- (B) 4' BENCH (2)
- (C) 6' BENCH (8)
- (D) BIKE POST (4)

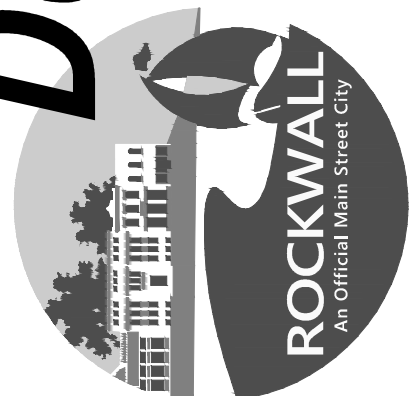

submittals / revisions

no.	date	detail
△	06/08/15	LASI #17

la terra studio, inc.

12024  
 its project number  
 02.26.2014  
 date  
 rac; bhm  
 drawn by  
 mtb  
 checked by

registration



02.26.2014  
 sheet title

**Site Furnishings Plan**  
 sheet number

**SF-1**

