



© 2013 la terra studio, inc. All Rights Reserved FILE:R:\12024-Downtown Rockwall PS&E - Rockwall\CAD\12024\_Enlargement\_Plan\_key.dwg

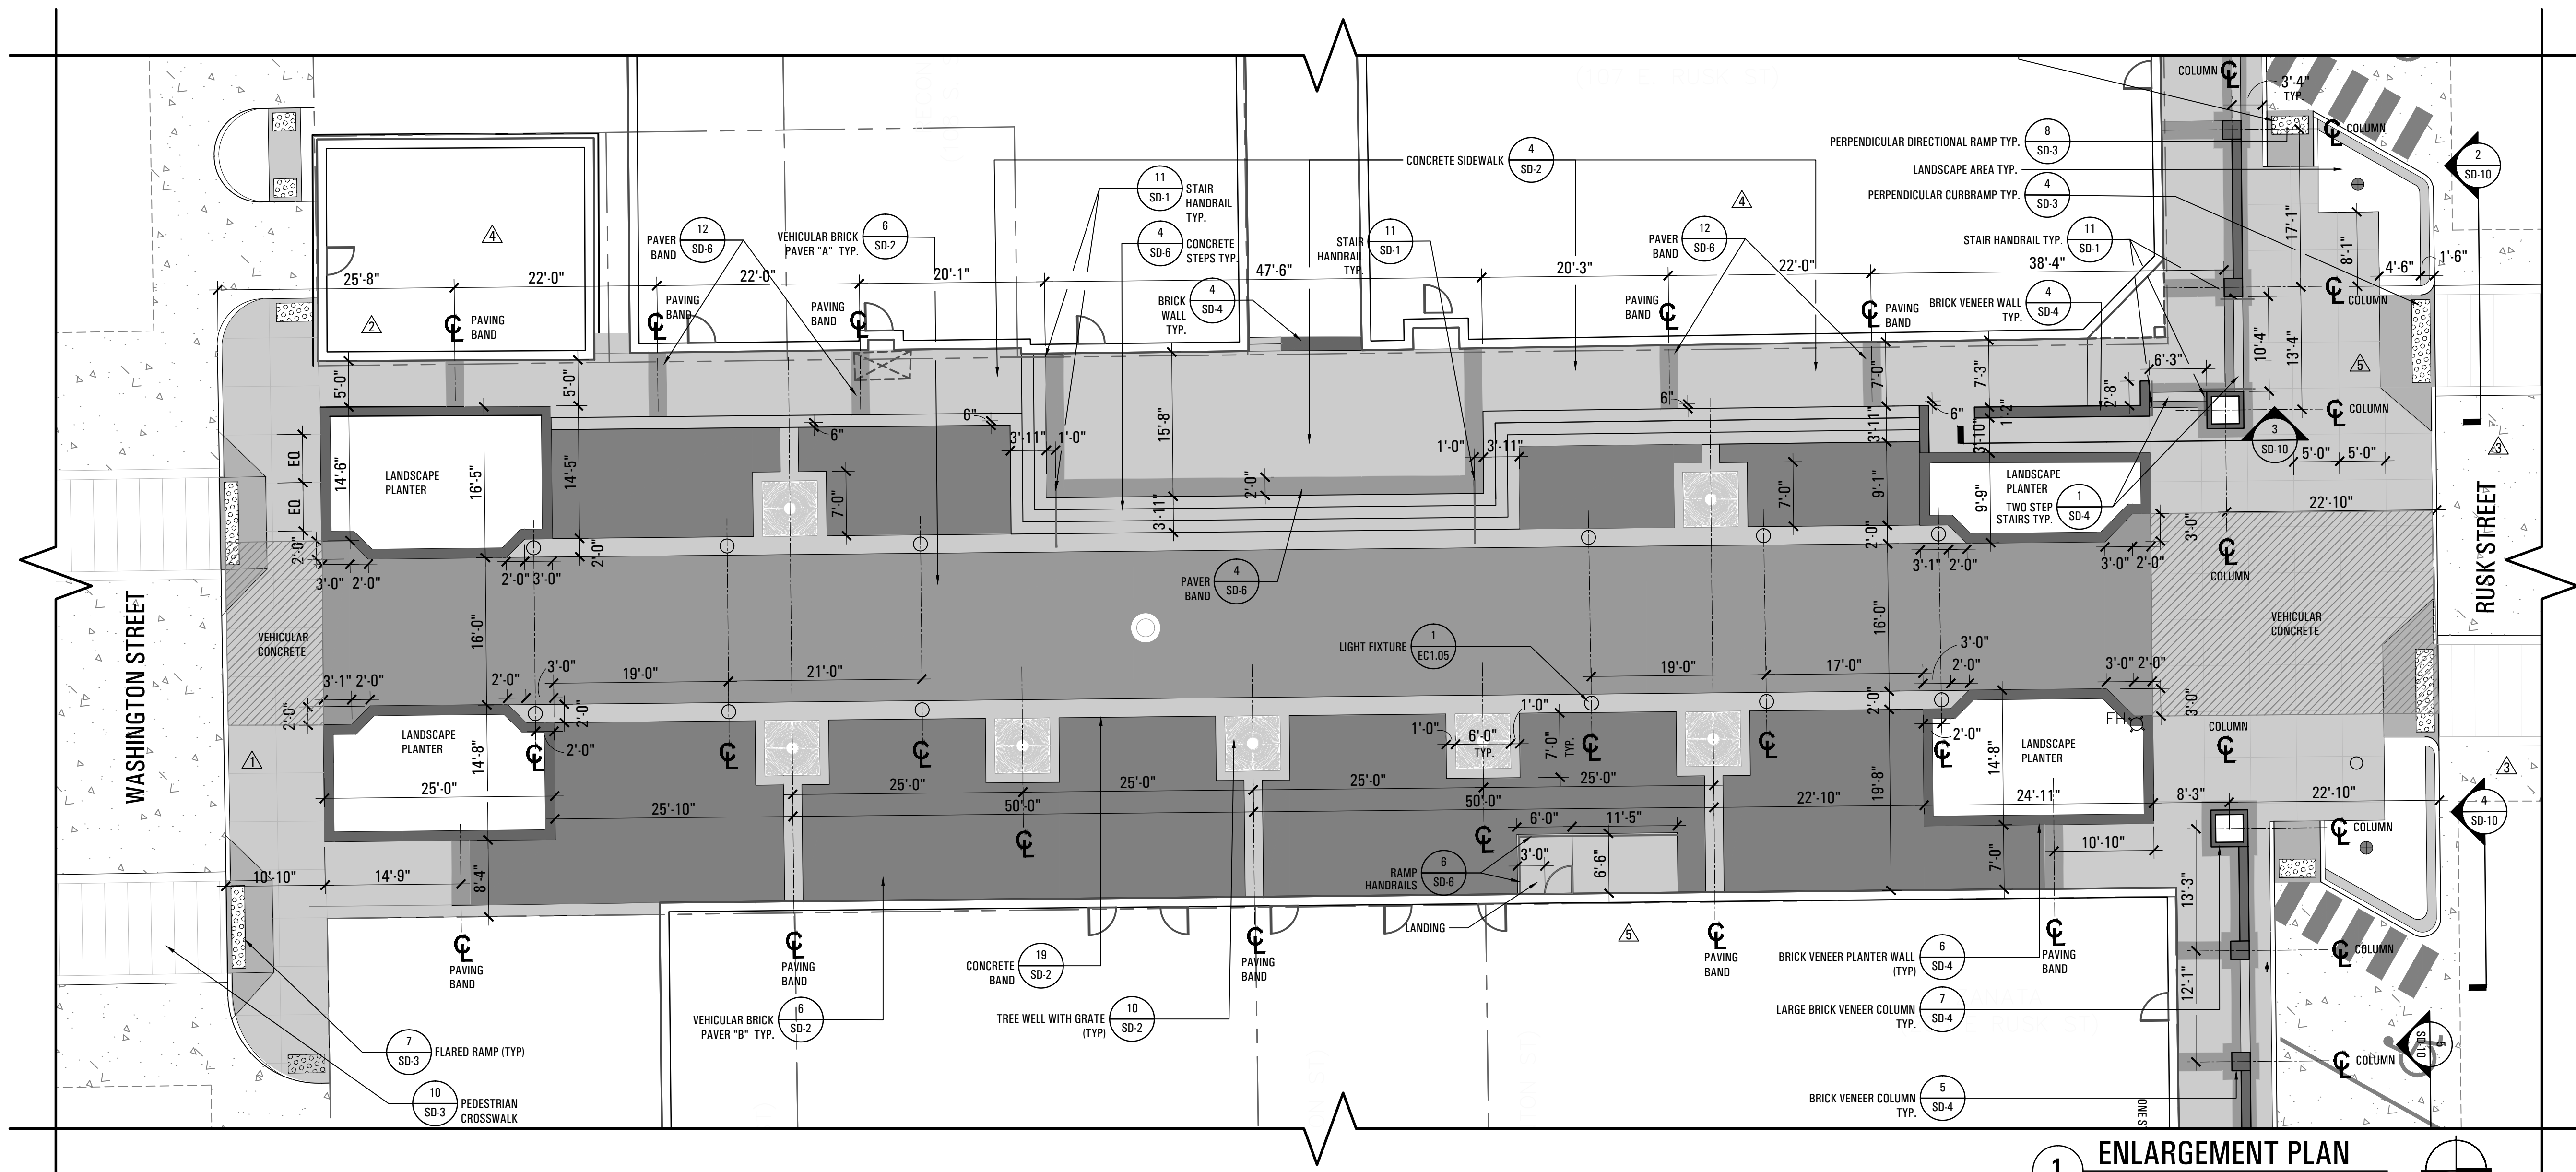

**1 ENLARGEMENT PLAN**  
SCALE: 1" = 10'-0"

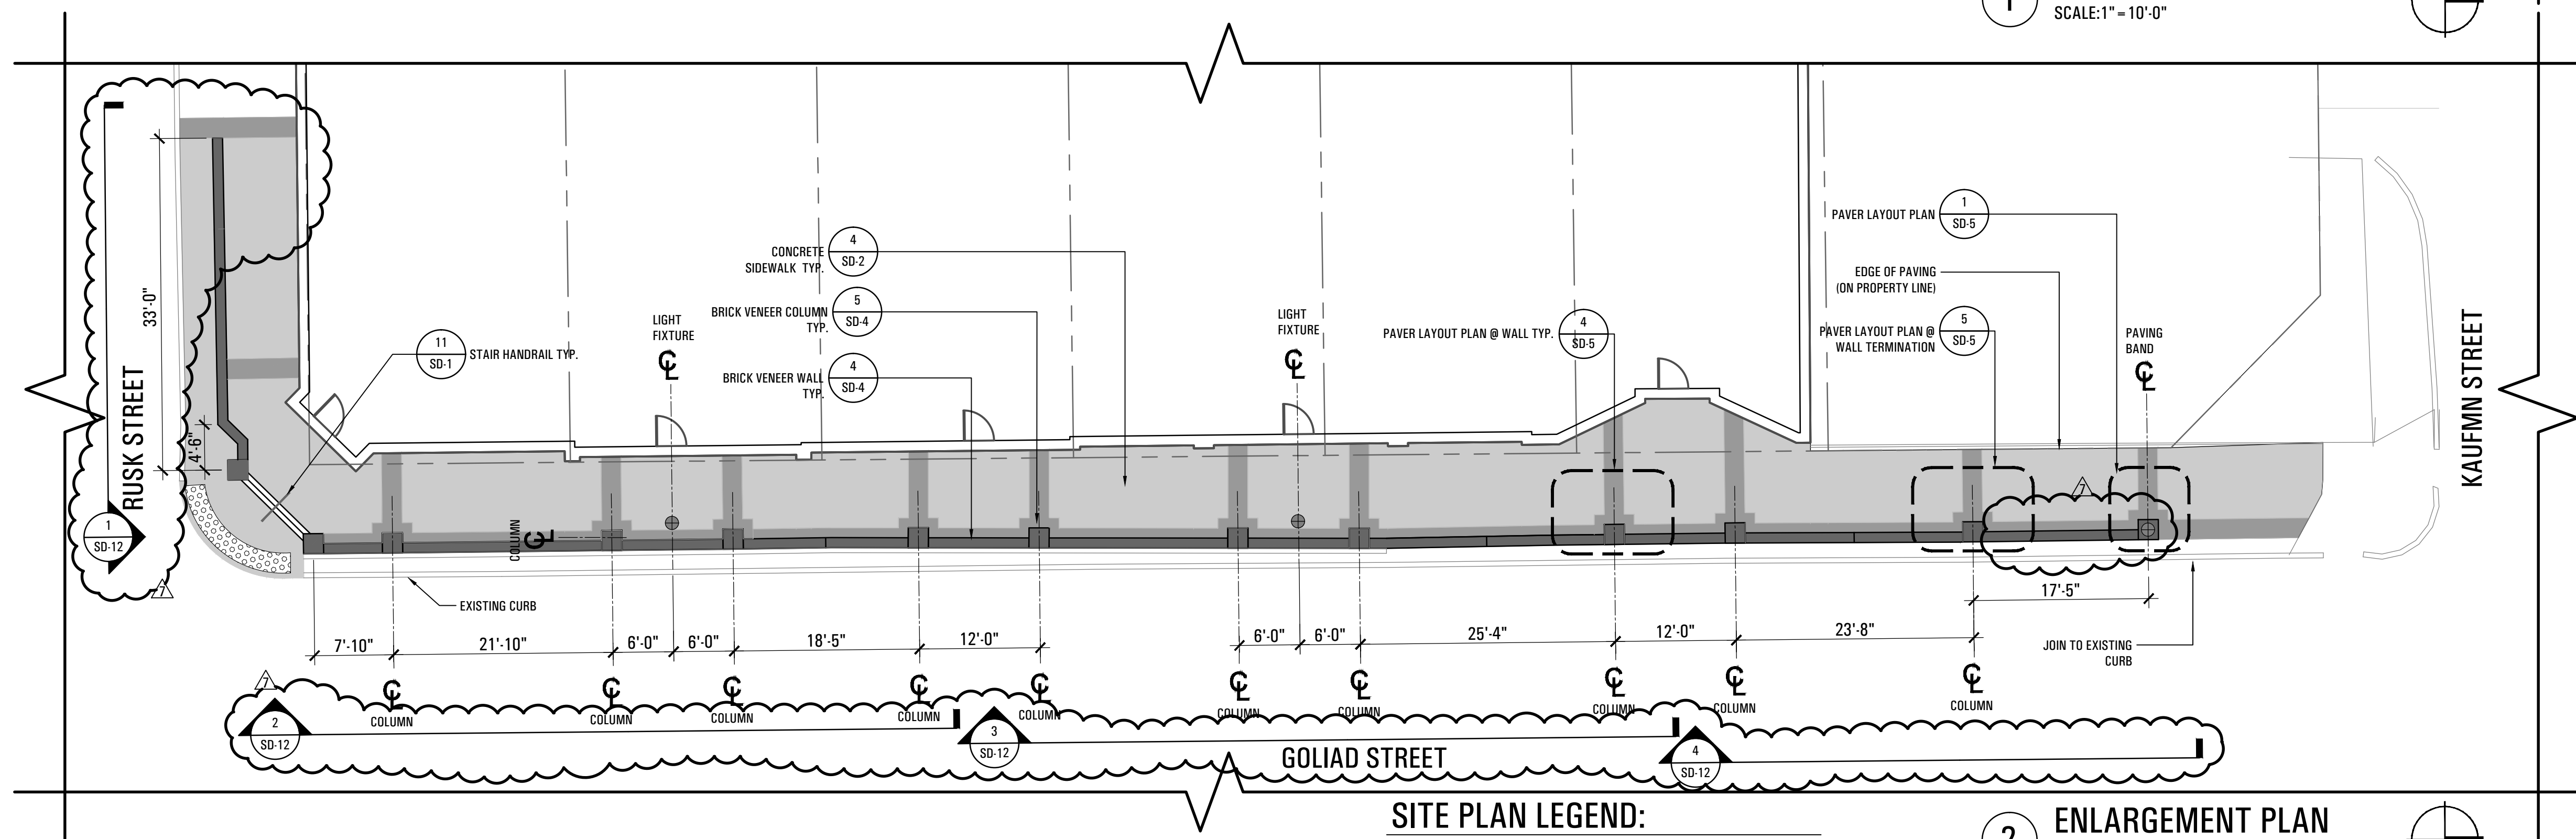

**SITE PLAN LEGEND:**

**2 ENLARGEMENT PLAN**  
SCALE: 1" = 10'-0"

**Downtown Rockwall**  
*la terra studio Project #12024*  
**streetscape improvements**  
PHASE 2  
rockwall, texas



submittals / revisions

no.	date	detail
▲	05/13/14	RFI #71
▲	08/14/14	LASI #9
▲	07/31/14	LASI #10
▲	09/26/14	RFI #131
▲	10/16/14	RFI #137
▲	12/30/14	RFI #139
▲	06/04/15	LASI #18

la terra studio, inc.

12024  
its project number  
02.26.2014  
date  
rac; bhm  
drawn by  
mtb  
checked by

