

~ MATCH LINE-SHEET GP-1 ~



~ MATCH LINE-SHEET GP-5 ~

~ MATCH LINE-SHEET GP-3 ~

**GRADING PLAN LEGEND:**

- 580 — EXISTING GRADE CONTOUR
- 581 — FINISH GRADE CONTOUR
- 587.25 — FINISH SPOT GRADE
- 580.00 — SEE CIVIL FOR CROSS REFERENCE OF PROPOSED ELEVATION
- TS TOP STEP
- BS BOTTOM STEP
- TW TOP OF WALL
- BW BOTTOM OF WALL
- TC TOP OF CURB
- G GUTTER
- FF FINISH FLOOR
- TCOL TOP OF COLUMN

**sheet location**

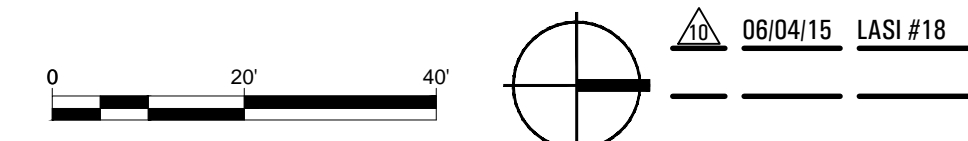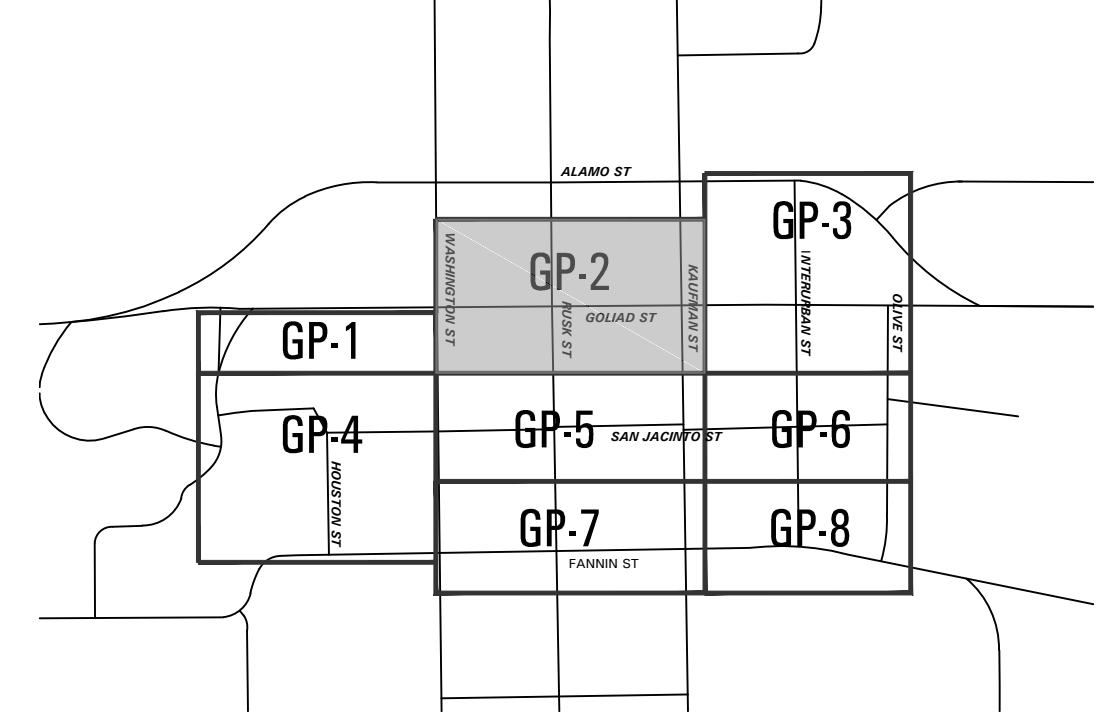

**Downtown Rockwall**  
 la terra studio Project #12024  
**streetscape improvements**  
 PHASE 2  
 rockwall, texas




submittals / revisions

no.	date	detail
△	04/11/14	RFI #39,56
△	05/02/14	RFI #77 WEST RUSK GRADING
△	06/17/14	RFI #93
△	07/11/14	LASI #7
△	07/25/14	RFI #104
△	09/10/14	RFI #124
△	10/27/14	RFI #140
△	01/13/15	LASI #14
△	02/09/15	RFI #160

la terra studio, inc.

12024  
 lts project number  
 02.26.2014  
 date  
 rac; bhm  
 drawn by  
 mtb  
 checked by

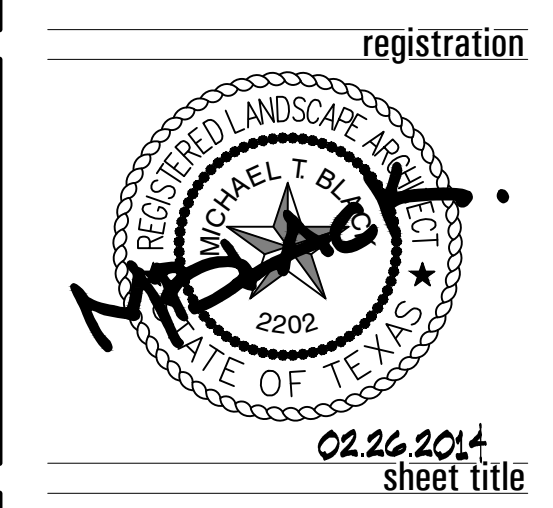

**Grading Plan**  
 sheet number  
**GP-2**