


1 ENLARGEMENT PLAN
SCALE: 1" = 10'-0"

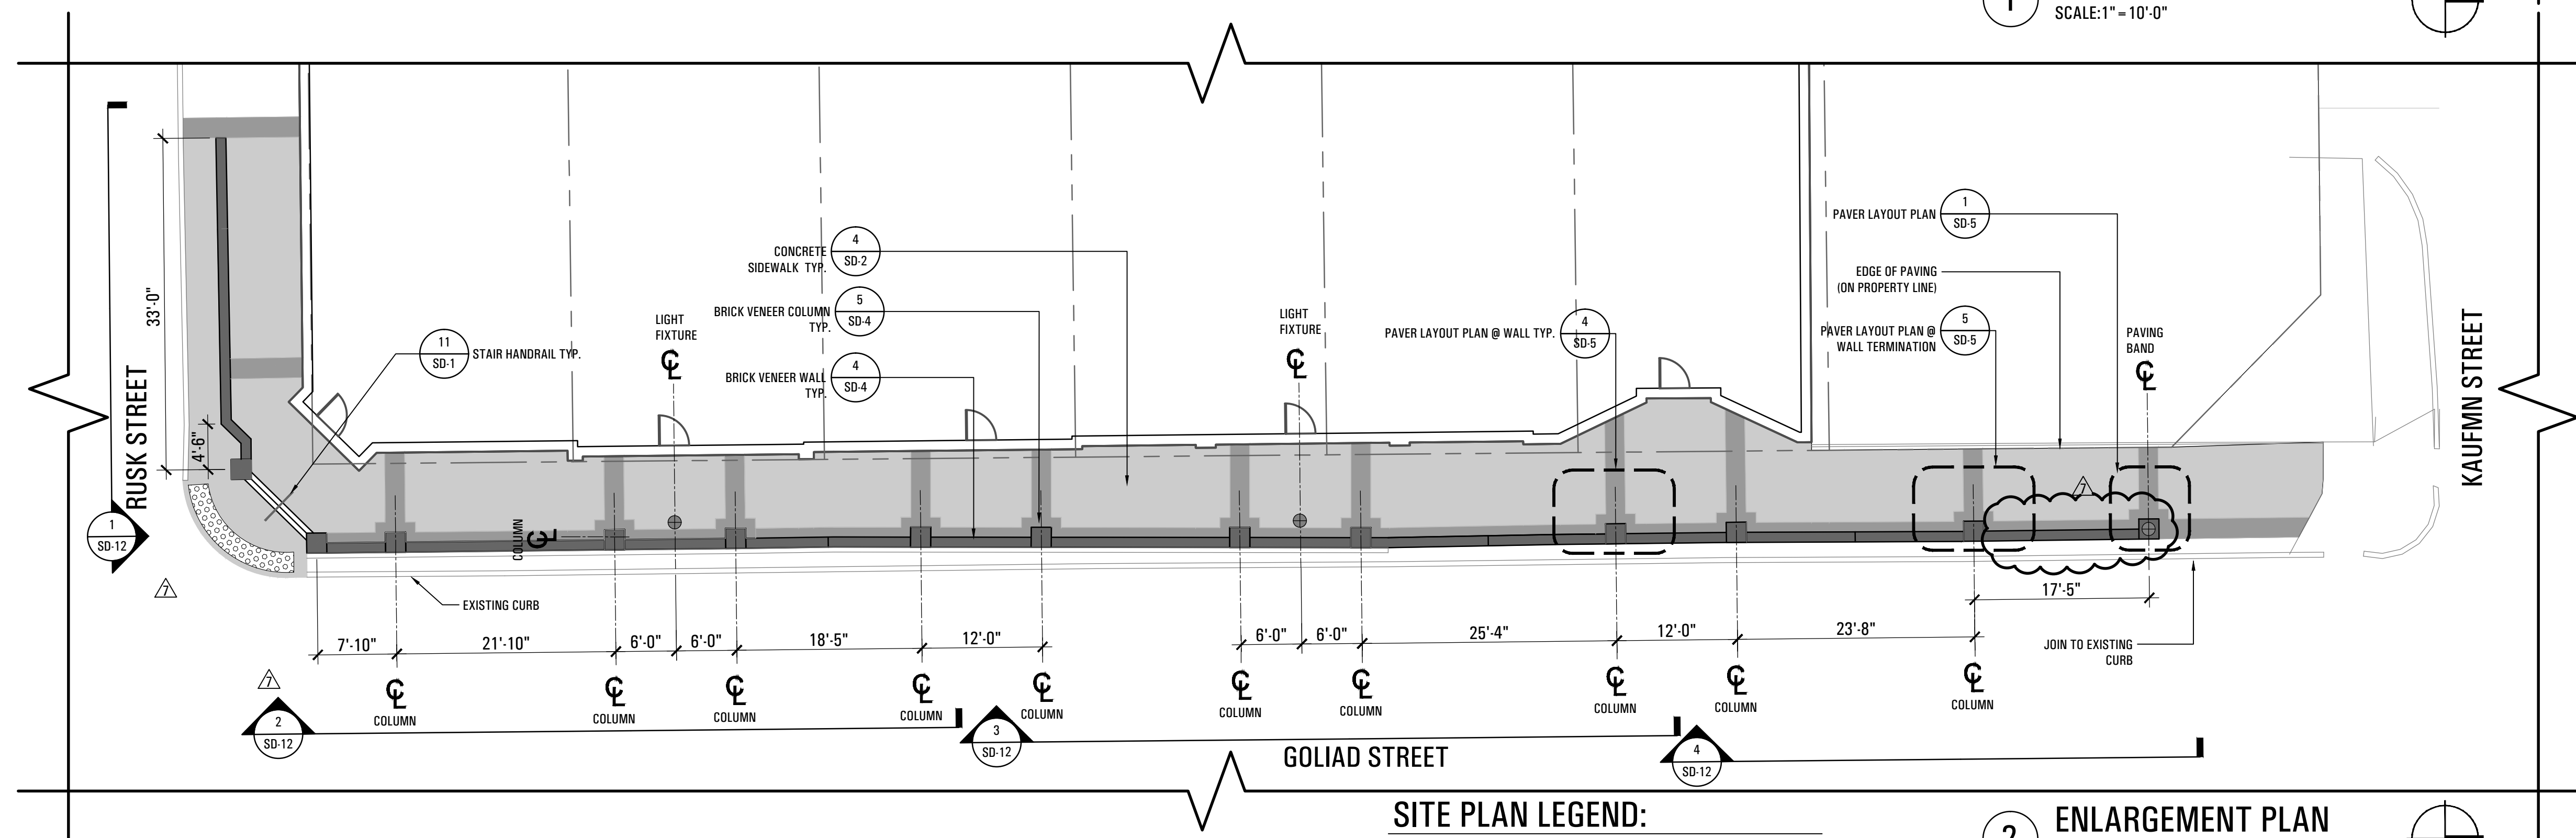

SITE PLAN LEGEND:

- EDGE OF PAVEMENT
- CONCRETE SIDEWALK PAVEMENT
- CONCRETE VEHICULAR PAVEMENT
- TYPICAL LIGHT FIXTURE

2 ENLARGEMENT PLAN
SCALE: 1" = 10'-0"

Downtown Rockwall
la terra studio Project #12024
streetscape improvements
PHASE 2
rockwall, texas



submittals / revisions

no.	date	detail
▲	05/13/14	RFI #71
▲	08/14/14	LASI #9
▲	07/31/14	LASI #10
▲	09/26/14	RFI #131
▲	10/16/14	RFI #137
▲	12/30/14	RFI #139
▲	06/04/15	LASI #18
▲	06/08/15	LASI #19

la terra studio, inc.
12024
its project number
02.26.2014
date
rac; bhm
drawn by
mtb
checked by

