


SITE PLAN LEGEND:

- EDGE OF PAVEMENT
- CONCRETE SIDEWALK PAVEMENT
- CONCRETE VEHICULAR PAVEMENT
- TYPICAL LIGHT FIXTURE

1 ENLARGEMENT PLAN
SCALE: 1" = 10'-0"

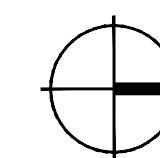

Downtown Rockwall
streetscape improvements
PHASE 2
rockwall, texas




submittals / revisions

| no. | date | detail |
|-----|----------|----------------|
| △ | 05/13/14 | RFI #51 |
| △ | 09/16/14 | RFI #121, #125 |
| △ | 11/26/14 | LASI #12 |
| △ | 02/27/15 | RFI #164 |
| △ | 06/09/15 | LASI #19 |

la terra studio, inc.

12024
its project number
02.26.2014
date
rac; bhm
drawn by
mtb
checked by

registration

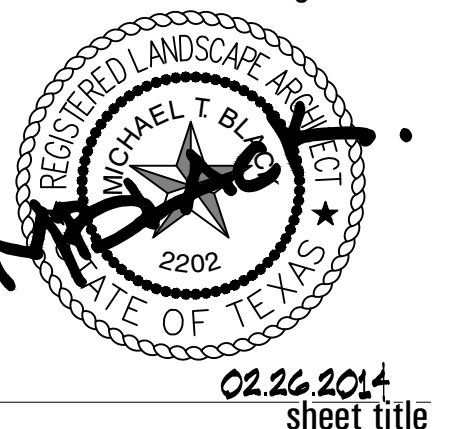

Enlargement Plan
sheet number

EP-2