

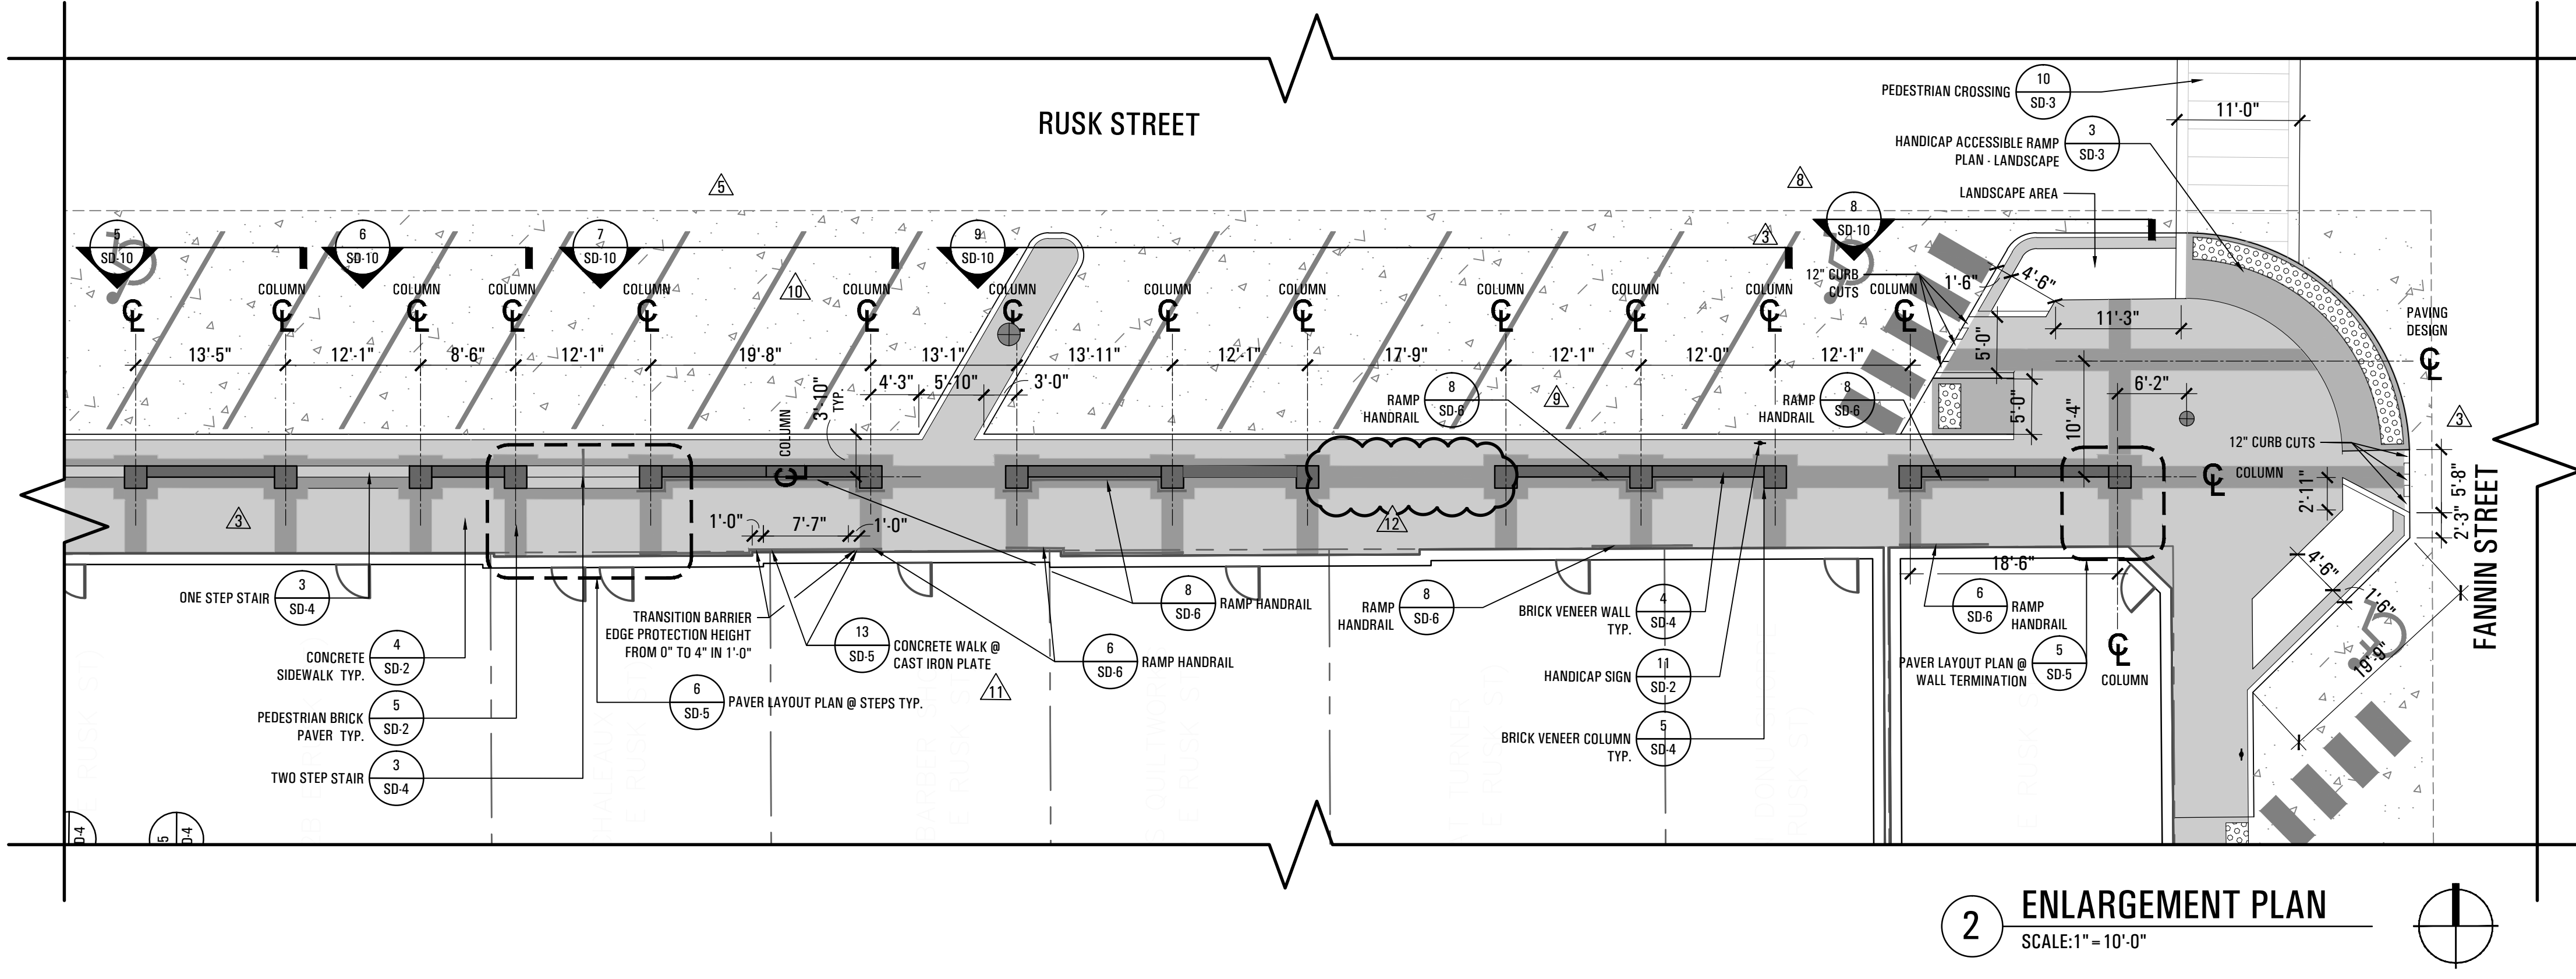


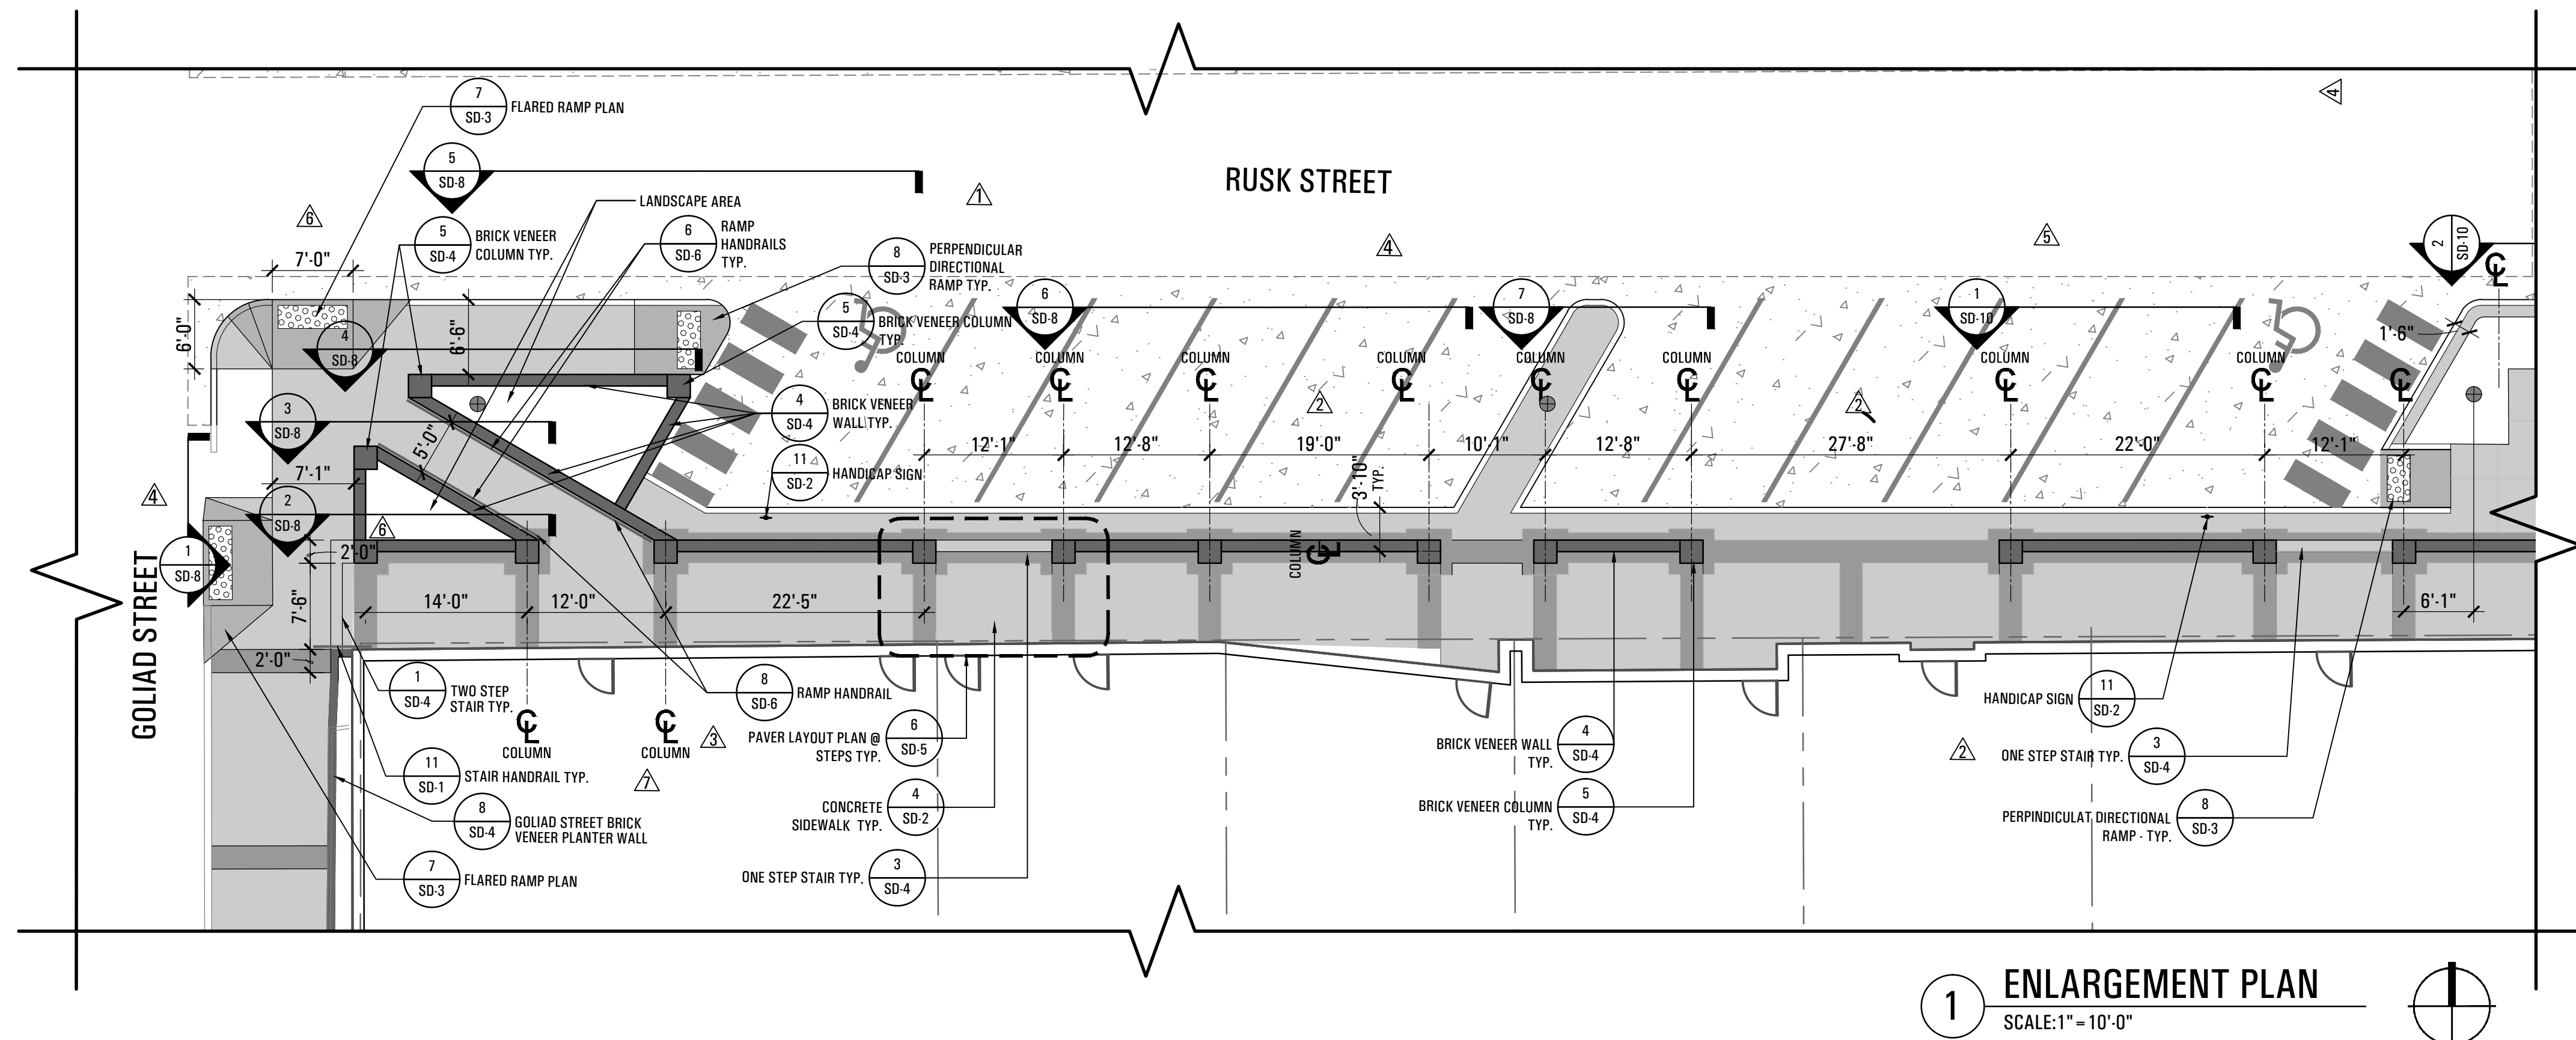

submittals / revisions

no.	date	detail
△	04/14/14	RFI #39
△	05/02/14	RFI #77 WEST RUSK GRADING
△	05/08/14	RFI #20, #38, #42, #43, #54
△	06/17/14	RFI #93
△	07/31/14	LASI #10
△	10/27/14	RFI #140
△	11/17/14	RFI #144
△	11/28/14	LASI #12
△	01/13/15	RFI #154

12024  
 its project number  
 02.26.2014  
 date  
 rac; bhm  
 drawn by  
 mtb  
 checked by

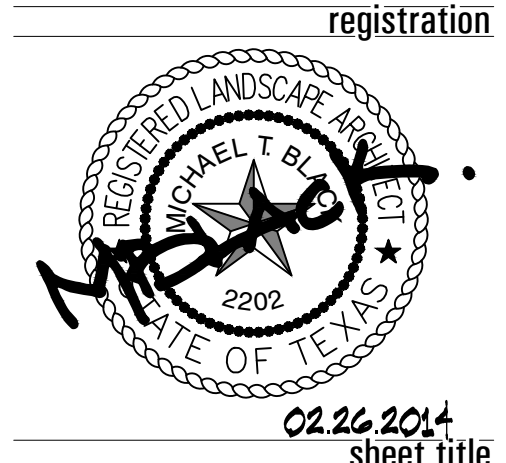

**SITE PLAN LEGEND:**

- EDGE OF PAVEMENT
- CONCRETE SIDEWALK PAVEMENT
- CONCRETE VEHICULAR PAVEMENT
- TYPICAL LIGHT FIXTURE