



la terra studio



DALLAS FORT WORTH HOUSTON



ENGINEERING ASSOCIATES

Downtown Rockwall
la terra studio Project #12024
streetscape improvements
PHASE 2
rockwall, texas



submittals / revisions

no.	date	detail
▲	05/08/14	RFI #20, #42, #43, #54
▲	05/16/14	RFI #37
▲	07/15/14	RFI #108
▲	09/30/14	RFI #123
▲	11/26/14	LASI #12
▲	12/16/14	RFI #145
▲	01/13/15	RFI #153
▲	04/15/15	RFI #146
▲	04/22/15	LASI #16

la terra studio, inc.

12024
its project number
02.26.2014
date
rac; bhm
drawn by
mtb
checked by


registration



02.26.2014 sheet title

Grading Plan
sheet number

GP-7

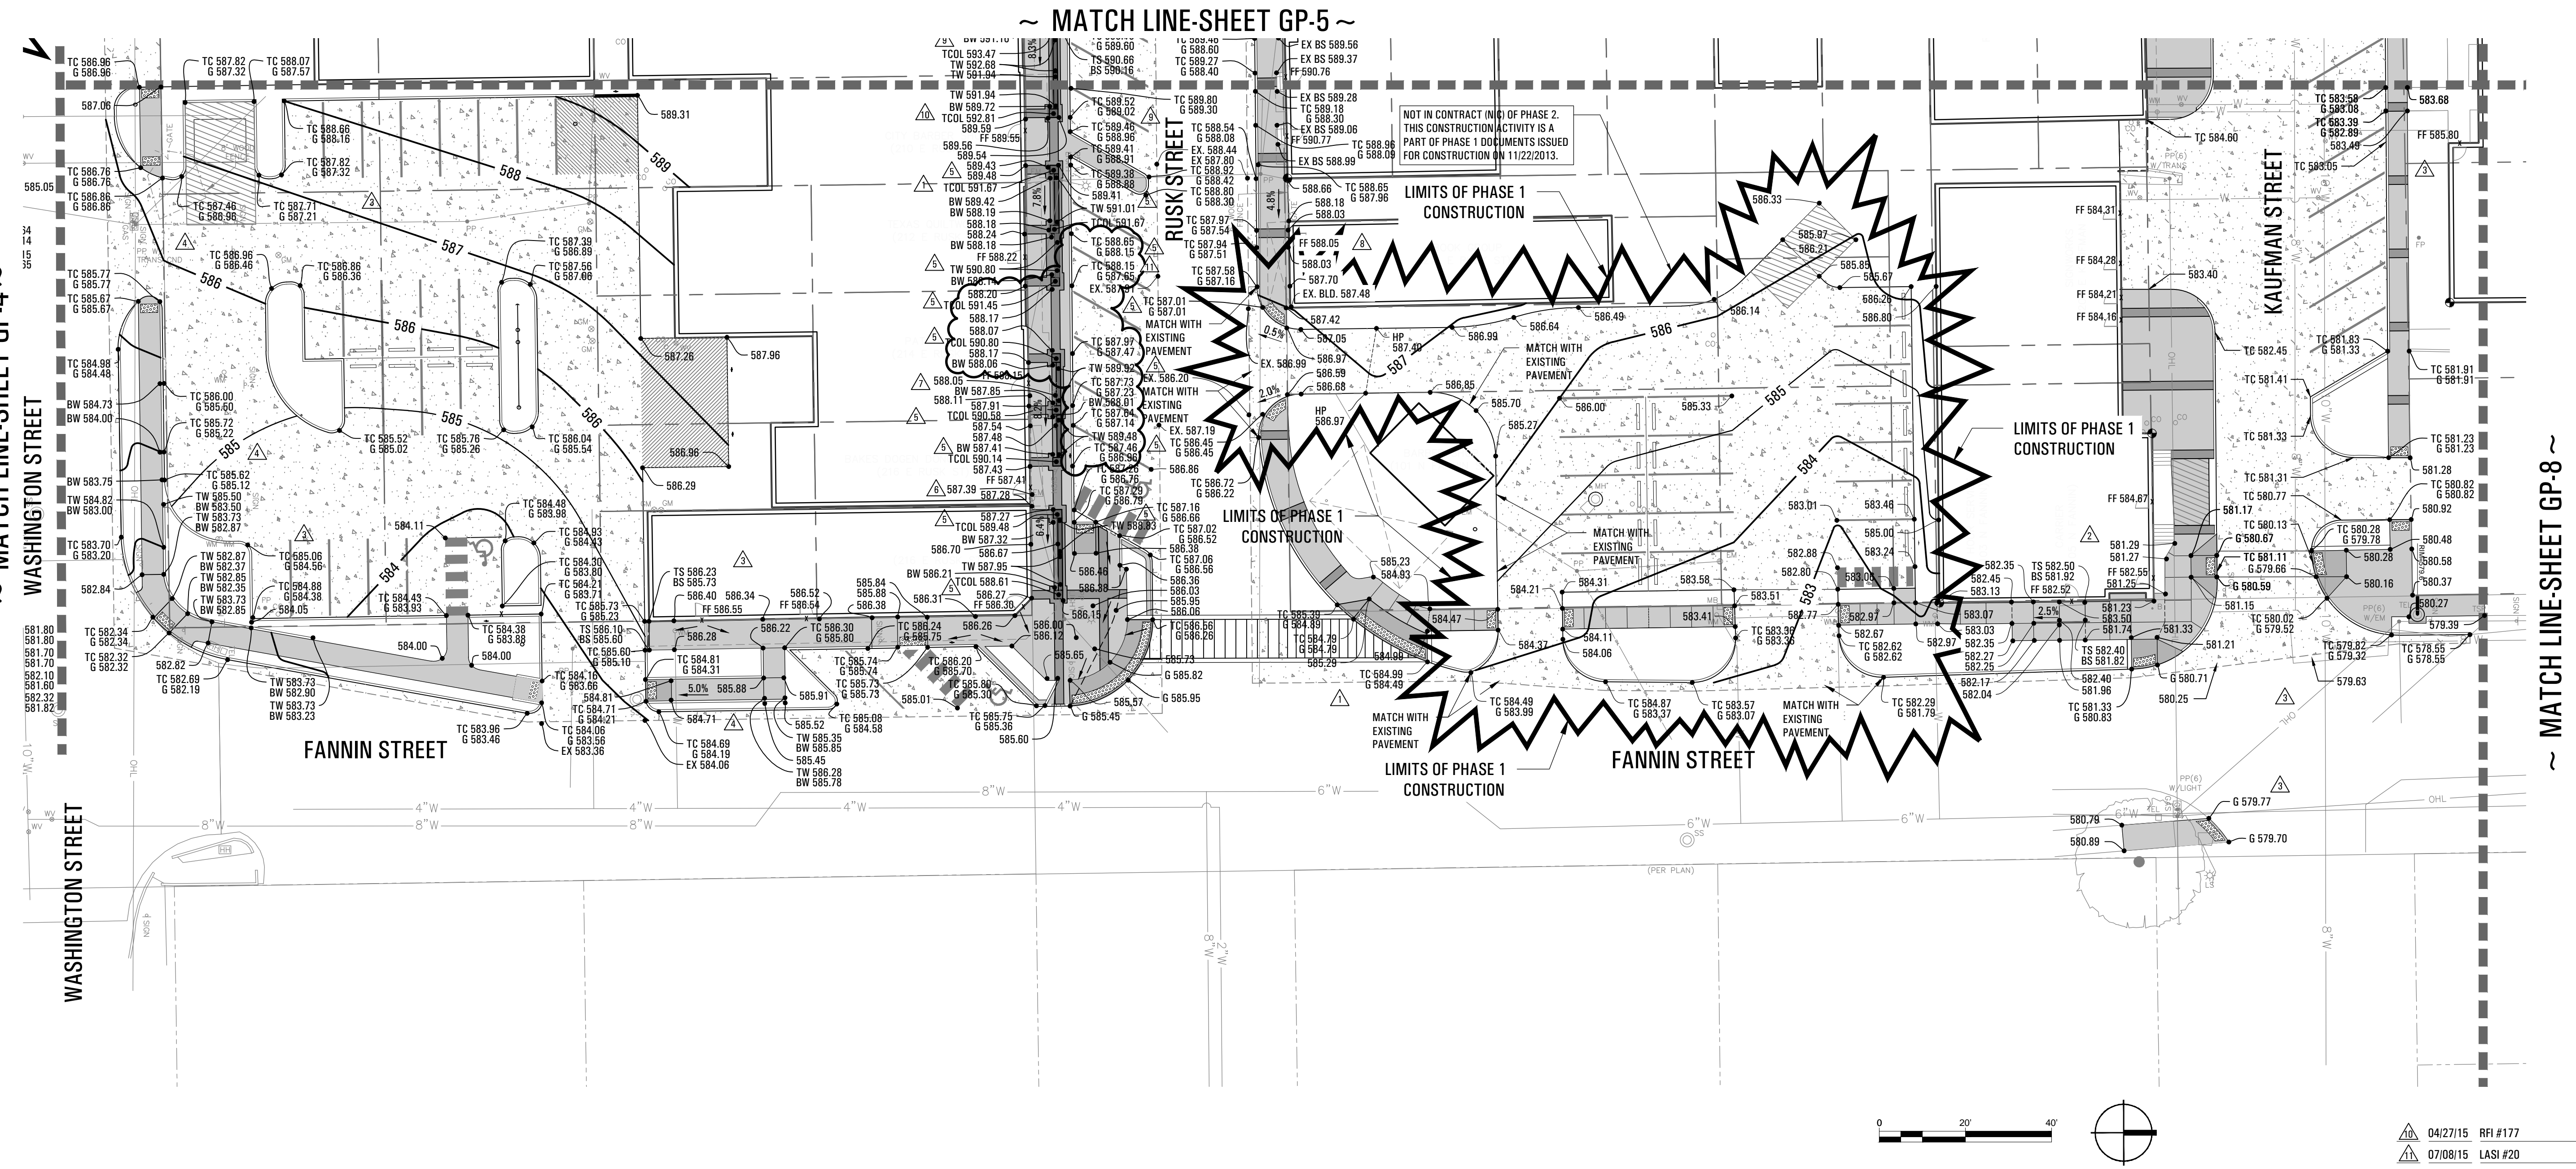

GRADING PLAN LEGEND:

- PHASE 1 PROJECT LIMIT LINE
- EXISTING GRADE CONTOUR
- FINISH GRADE CONTOUR
- FINISH SPOT GRADE
- SEE CIVIL FOR CROSS REFERENCE OF PROPOSED ELEVATION
- TOP STEP
- BOTTOM STEP
- TOP OF WALL
- BOTTOM OF WALL
- TOP OF CURB
- GUTTER
- FINISH FLOOR
- TOP OF COLUMN

sheet location

