

PLANT AND MATERIALS LIST: NOTE: CONTRACTOR TO VERIFY ALL QUANTITIES PER PLANS

CANOPY TREES

| QNTY. | SYMBOL | COMMON NAME | BOTANIC NAME | SIZE | HEIGHT | NOTES |
|-------|--------|------------------|------------------------|--------------|-----------|--|
| 23 | CP | CHINESE PISTACHE | PISTACHIA CHINENSIS | 65 GAL. / 4" | 12' - 15' | 6' SPREAD, FULL HEAD, BRANCHING AT ±5' MATCHED |
| 1 | LO | LIVE OAK | QUERCUS VIRGINIANA | 65 GAL. / 4" | 12' - 15' | 6' SPREAD, FULL HEAD, BRANCHING AT ±5' MATCHED |
| 5 | LBE | LACE BARK ELM | ULMUS PARVIFOLIA | 65 GAL. / 4" | 14' - 18' | 6' SPREAD, FULL HEAD, BRANCHING AT ±5' MATCHED |
| 4 | RO | RED OAK | QUERCUS SHUMARDI | 65 GAL. / 4" | 14' - 18' | 8' SPREAD, FULL HEAD, BRANCHING AT ±5' MATCHED |
| 7 | CM | CADDO MAPLE | ACER SACCHARUM 'CADDO' | 65 GAL. / 4" | 12' - 15' | 6' SPREAD, FULL HEAD, BRANCHING AT ±5' MATCHED |

*LANDSCAPE ARCHITECT TO APPROVE ALL TREES PRIOR TO INSTALLATION

SHRUBS

| QNTY. | SYMBOL | COMMON NAME | BOTANIC NAME | SIZE | HEIGHT | NOTES |
|-------|--------|--|--|--------|--------|---------------------------------|
| 19 | CFF | CHINESE FRINGE FLOWER 'PURPLE DIAMOND' | LOROPETALUM CHINENSIS 'PURPLE DIAMOND' | 5 GAL. | 18" | CONTAINER GROWN, FULL, 48" O.C. |
| 237 | CH | CARISSA HOLLY | ILEX CORNUTA 'CARISSA' | 3 GAL. | 18" | CONTAINER GROWN, FULL, 36" O.C. |
| 143 | CR | CARPET ROSEMARY | ROSMARINUS OFFICINALIS 'HUNTINGTON CARPET' | 1 GAL. | 8" | CONTAINER GROWN, FULL, 24" O.C. |
| 203 | GL | GIANT LIRIOPE | LIRIOPE GIGANTEA | 1 GAL. | 12" | CONTAINER GROWN, FULL, 24" O.C. |
| 148 | IH | INDIAN HAWTHORN | RHAPHIOLEPIS INDICA 'CLARA' | 3 GAL. | 18" | CONTAINER GROWN, FULL, 36" O.C. |
| 692 | MF | MEXICAN FEATHER GRASS | STIPA TENIOSSIMA | 1 GAL. | 12" | CONTAINER GROWN, FULL, 24" O.C. |

TURF

| QNTY. | SYMBOL | COMMON NAME | BOTANIC NAME | SIZE | HEIGHT | NOTES |
|-----------|--------|-------------------------------|-------------------------|------|--------|-----------|
| 3,385 SF | SSSAG | SOLID SOD ST. AUGUSTINE GRASS | STENOTAPHRUM SECUNDATUM | N/A | N/A | SOLID SOD |
| 19,675 SF | SSBG | SOLID SOD BERMUDA GRASS | Cynodon dactylon | N/A | N/A | SOLID SOD |

NOTE: APPLY 4" CLEAN TOPSOIL TO ALL TURF AREAS PRIOR TO INSTALLATION OF SOD OR HYDROMULCH

GROUND COVER

| QNTY. | SYMBOL | COMMON NAME | BOTANIC NAME | SIZE | HEIGHT | NOTES |
|-------|---------|-------------|-----------------|--------|--------|---------------------------------|
| 130 | LIR MUS | LILY TURF | LIRIOPE MUSCARI | 1 GAL. | 12" | CONTAINER GROWN, FULL, 18" O.C. |

EXISTING TREE

| QNTY. | SYMBOL | NOTE |
|-------|----------|---|
| | PER PLAN | REFERENCE CIVIL DEMO PLANS FOR TREE PRESERVATION. |

© 2013 la terra studio, inc. All Rights Reserved FILE:P:\12024-Downtown Rockwall PSS&E - Rockwall\CAD\8HEET\$1\2024_LD-2.dwg




Downtown Rockwall
 la terra studio Project #12024
streetscape improvements
 PHASE 2
 rockwall, texas

submittals / revisions

| no. | date | detail |
|-----|----------|----------|
| 1 | 09/17/15 | LASI #22 |
| | | |
| | | |
12024
 its project number
 02.26.2014
 date
 rac; bhm
 drawn by
 mtb
 checked by

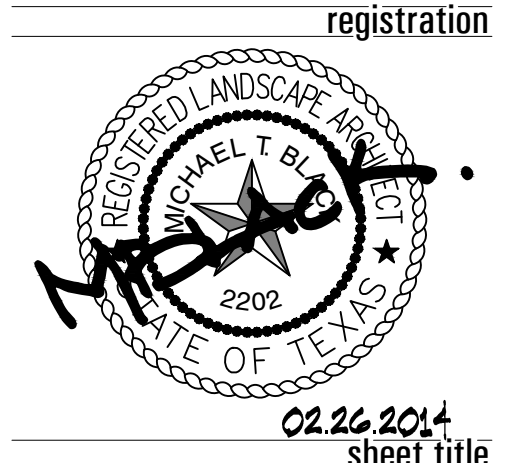

PLANT LIST
 sheet number
LD-2