


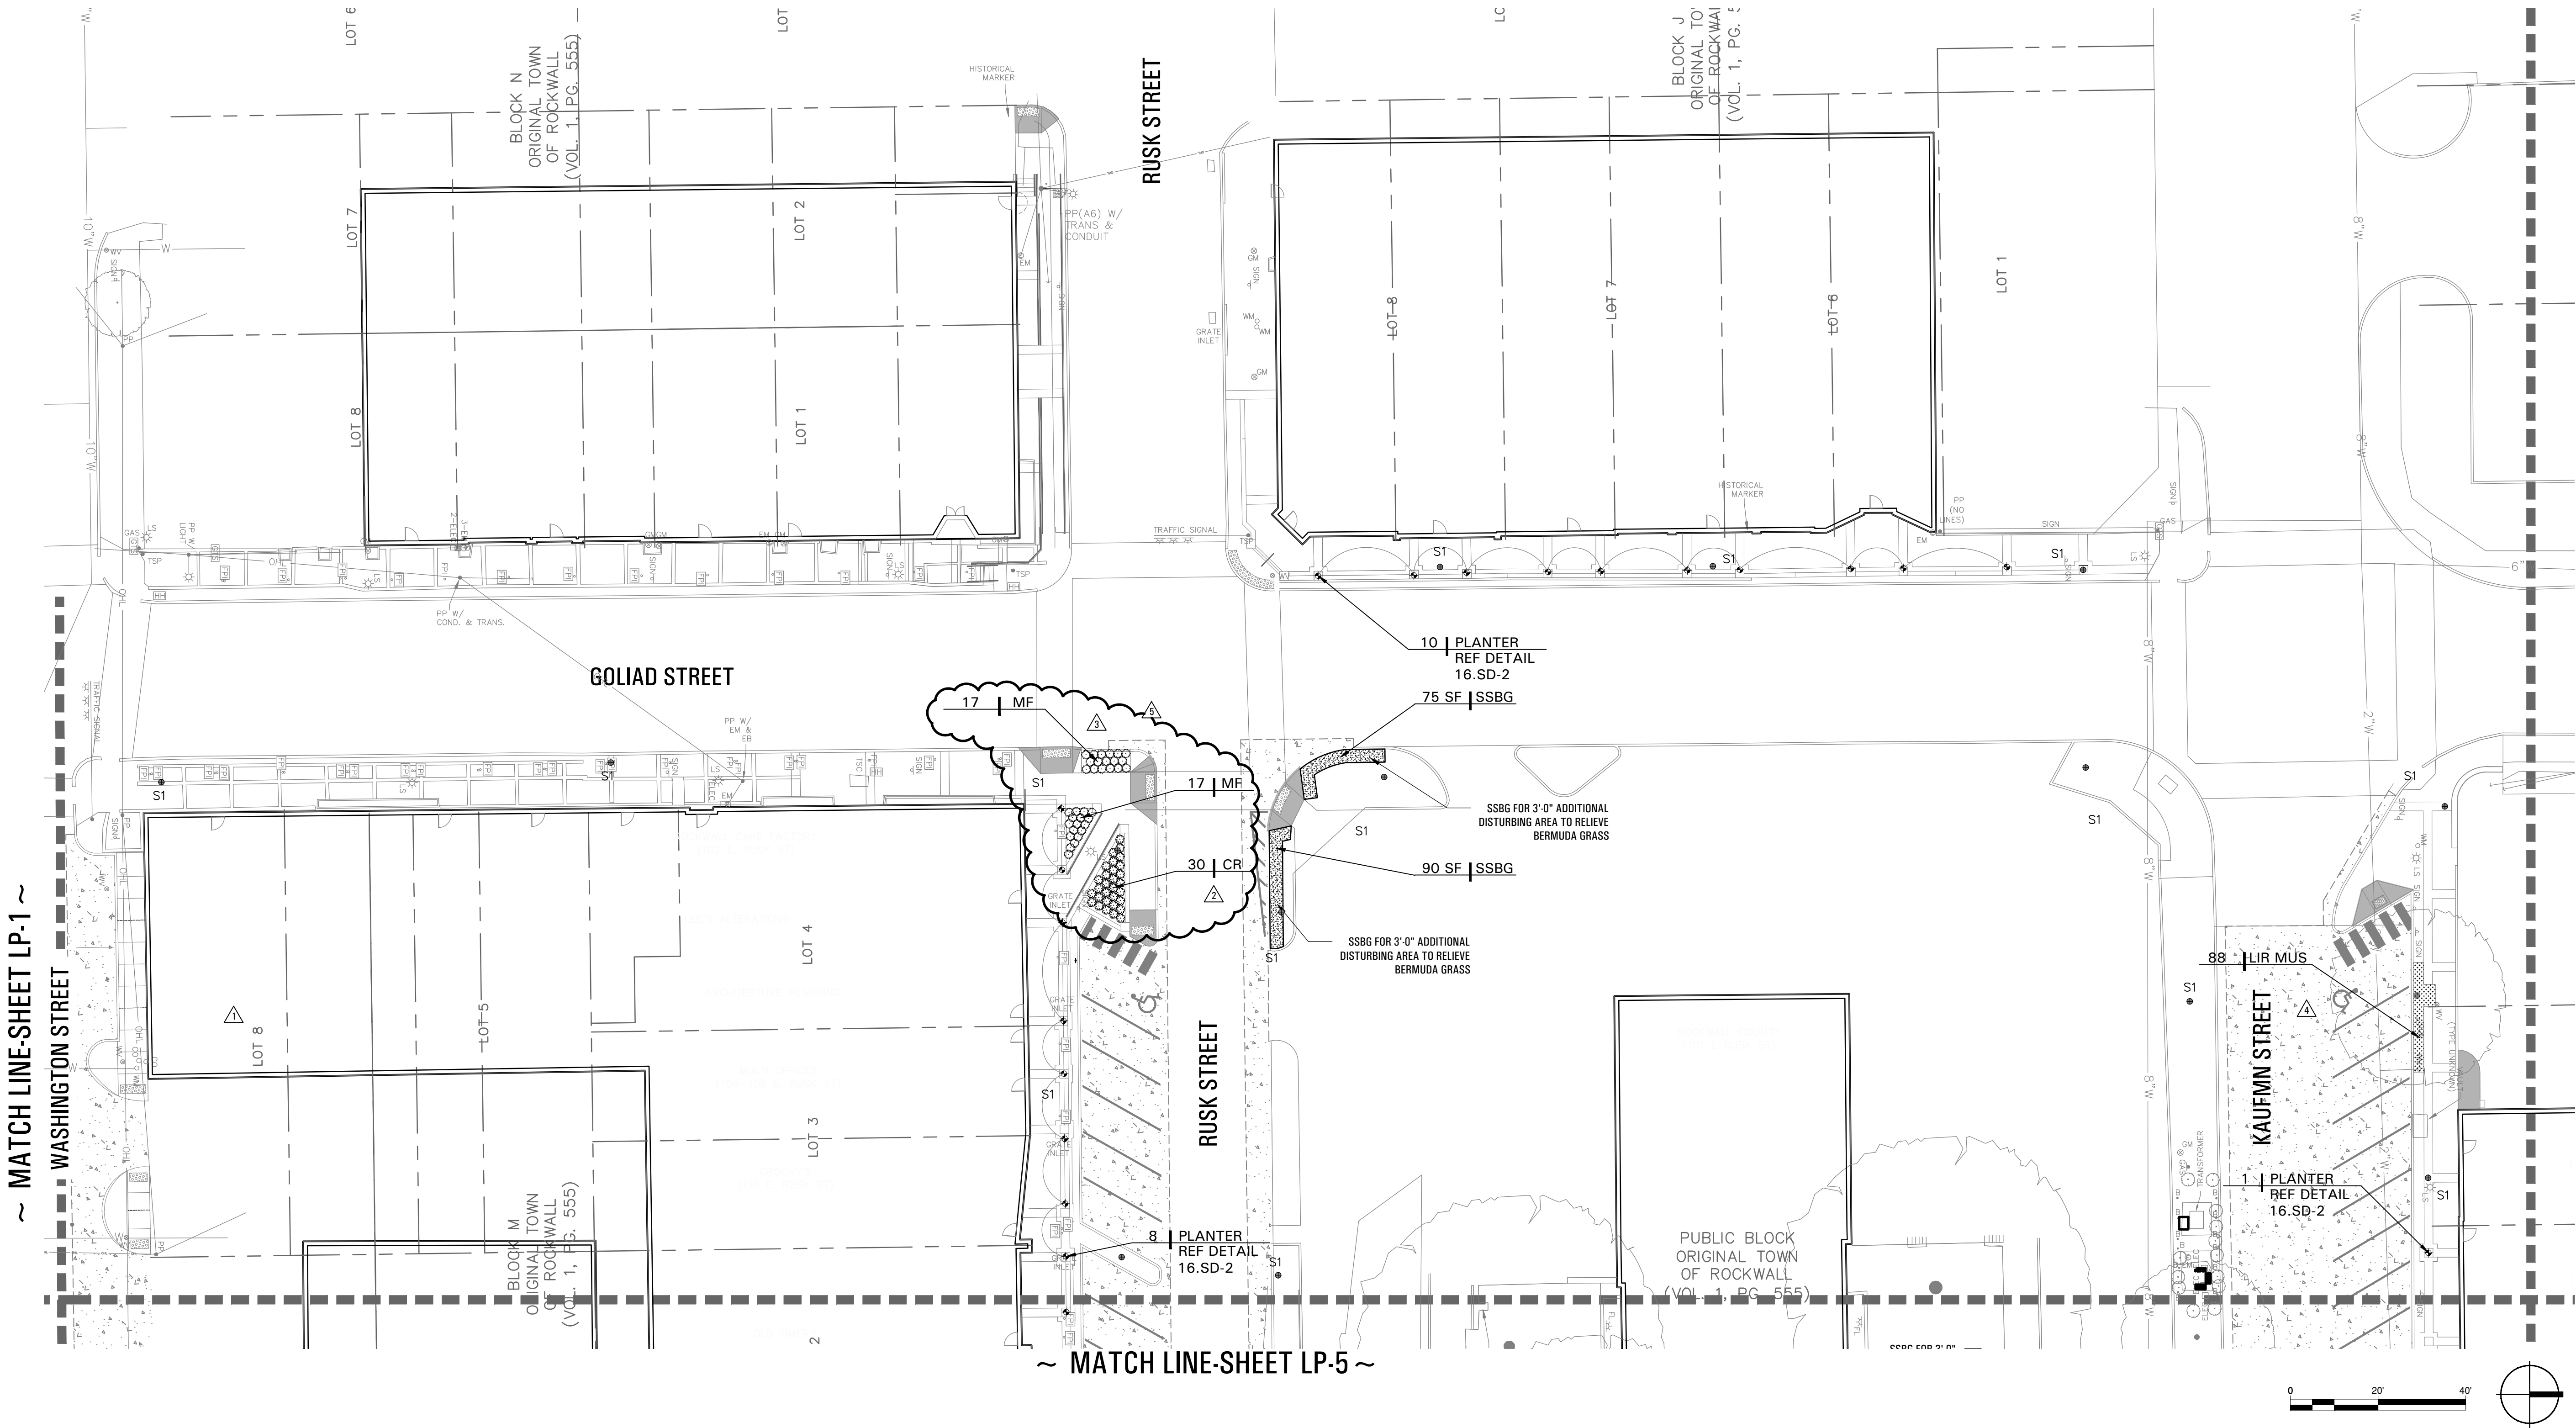

PLANT AND MATERIALS LIST: NOTE: CONTRACTOR TO VERIFY QUANTITIES PER PLANS

CANOPY TREES

QNTY.	SYMBOL	COMMON NAME	BOTANIC NAME
	CP	CHINESE PISTACHE	PISTACHIA CHINENSIS

SHRUBS

QNTY.	SYMBOL	COMMON NAME	BOTANIC NAME
	MF	MEXICAN FEATHER GRASS	STIPA TENIOSSIMA
	CR	CARPET ROSEMARY	ROSMARINUS OFFICINALIS 'HUNTINGTON CARPET'

GROUND COVER

QNTY.	SYMBOL	COMMON NAME	BOTANIC NAME
130	LIR MUS	LILY TURF	LIRIOPE MUSCARI


TURF

QNTY.	SYMBOL	COMMON NAME	BOTANIC NAME
	SSBG	SOLID SOD BERMUDA GRASS	Cynodon dactylon

EXISTING TREE

QNTY.	SYMBOL	NOTE
	PER PLAN	REFERENCE CIVIL DEMO PLANS FOR TREE PRESERVATION.

sheet location

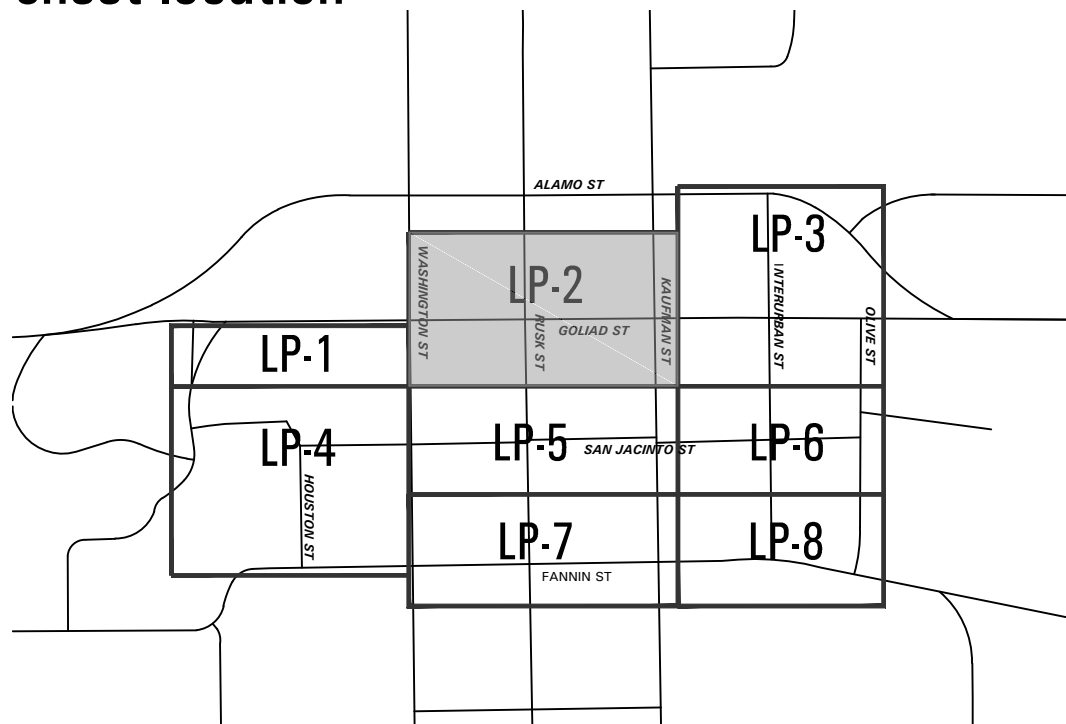


submittals / revisions

no.	date	detail
1	07/14/14	RFI #101
2	07/29/14	RFI #114
3	08/20/14	RFI #119
4	09/10/14	RFI #124
5	09/17/15	LASI #22

la terra studio, inc.

12024
Its project number
02.26.2014
date
rac; bhm
drawn by
mtb
checked by

registration

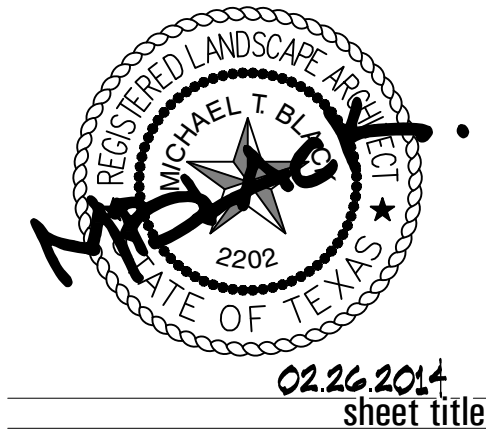

Landscape Plan
sheet number

LP-2