


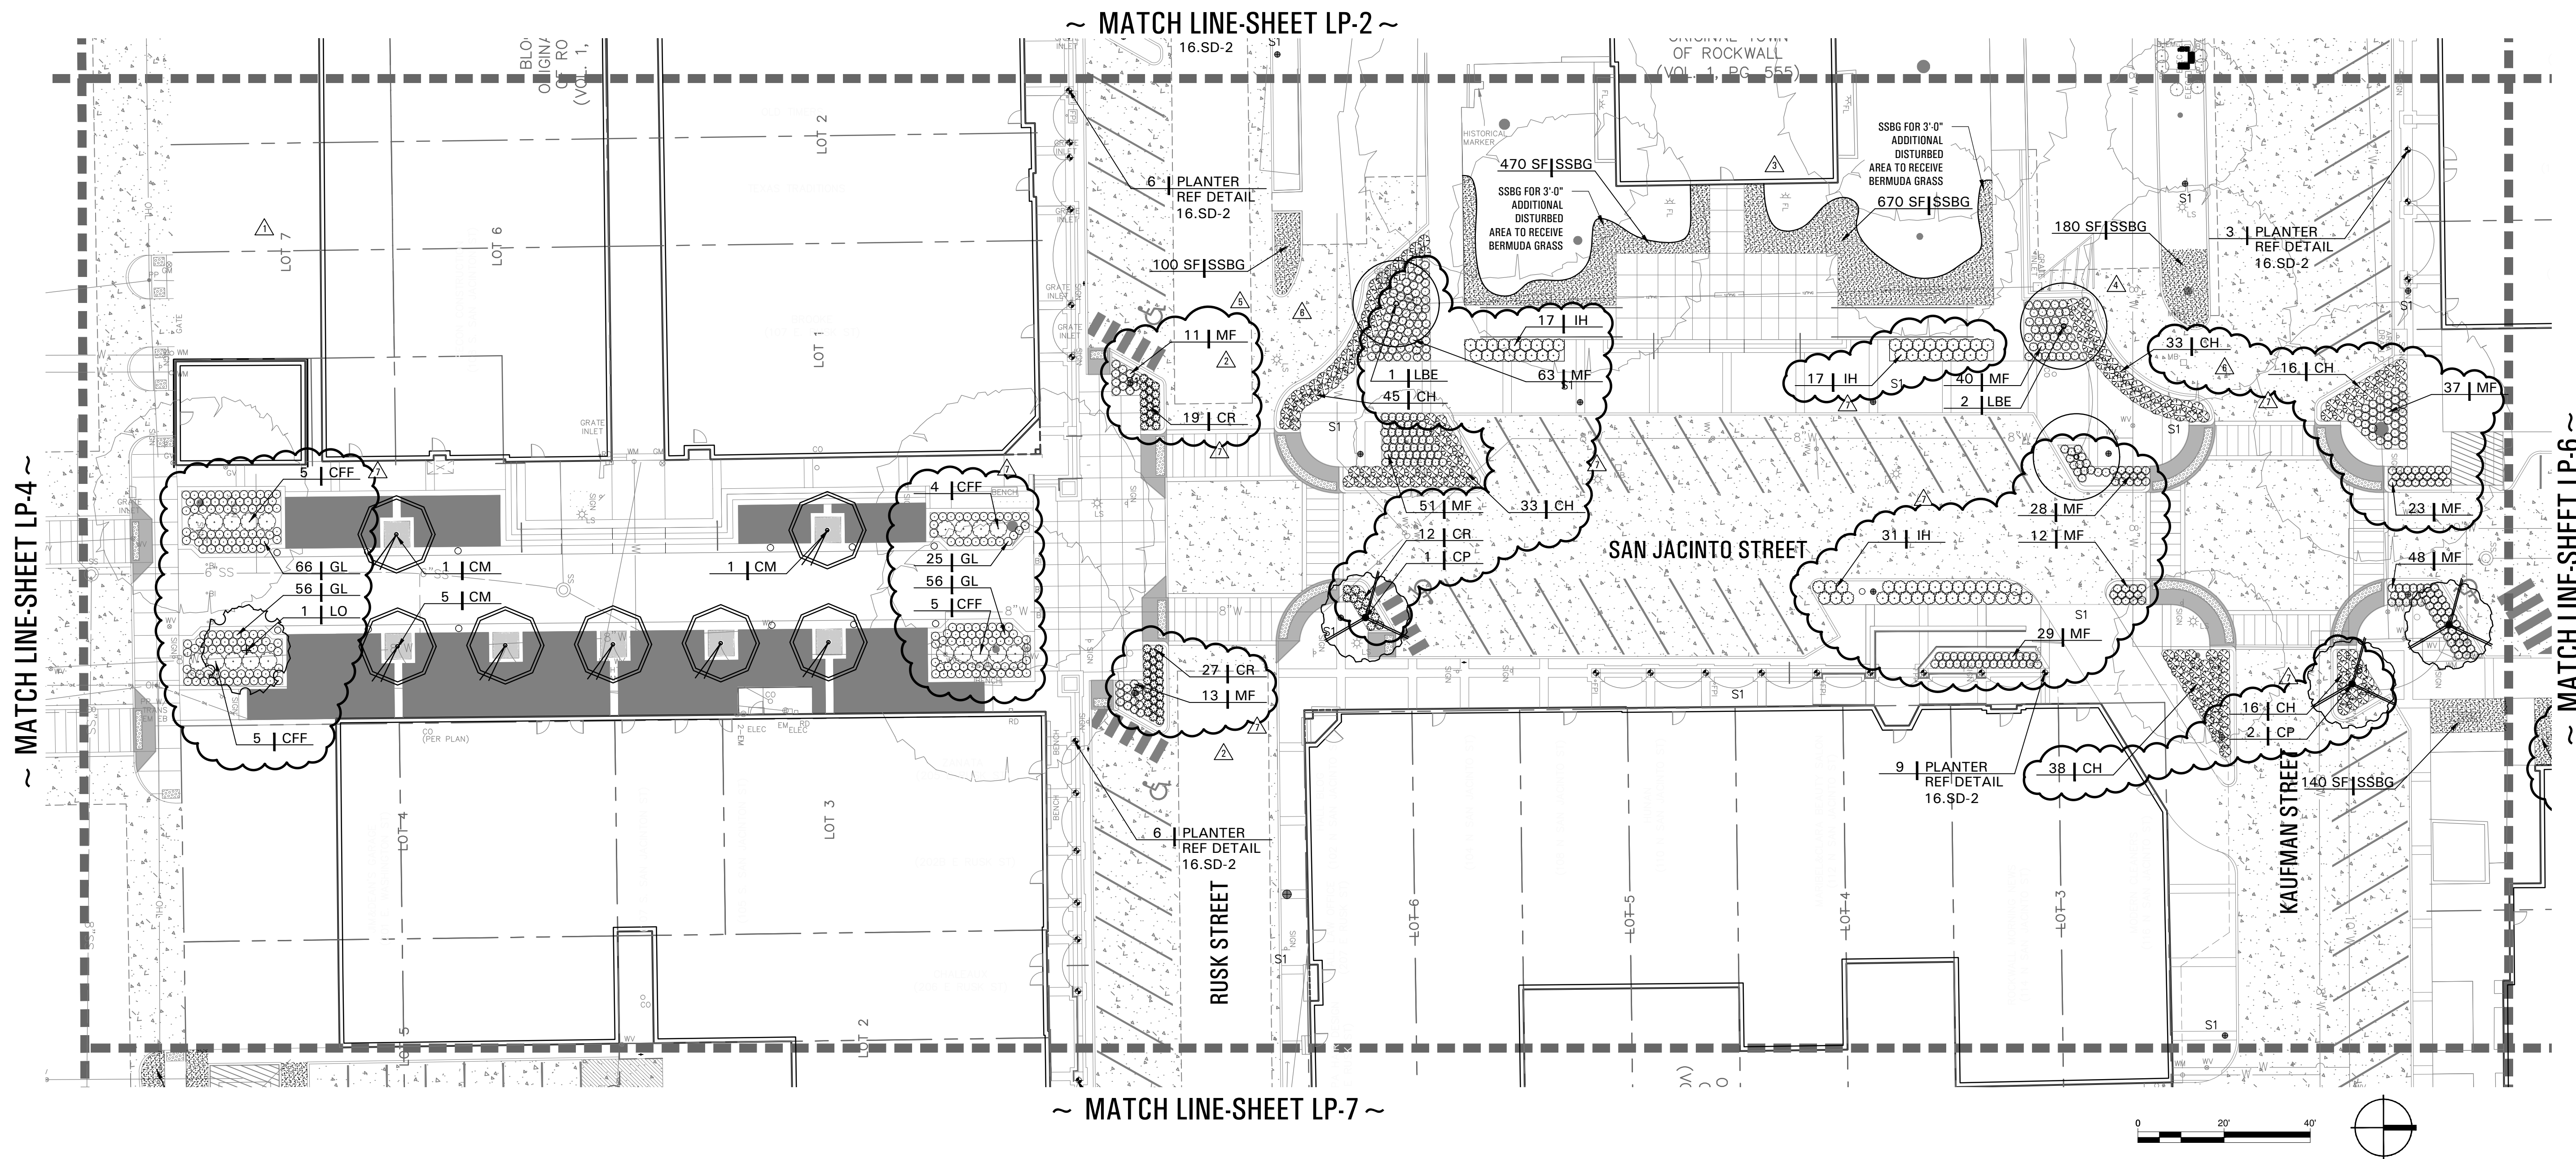

CANOPY TREES

	QNTY.	SYMBOL	COMMON NAME	BOTANIC NAME
		CP	CHINESE PISTACHE	PISTACHIA CHINENSIS
		LO	LIVE OAK	QUERCUS VIRGINIANA
		LBE	LACE BARK ELM	ULMUS PARVIFOLIA
		RO	RED OAK	QUERCUS SHUMARDI
		CM	CADDO MAPLE	ACER SACCHARUM 'CADDO'

	QNTY.	SYMBOL	COMMON NAME	BOTANIC NAME
		CFF	CHINESE FRINGE FLOWER 'PURPLE DIAMOND'	LOROPETALUM CHINENSIS 'PURPLE DIAMOND'
		CH	CARISSA HOLLY	ILEX CORNUTA 'CARISSA'
		CR	CARPET ROSEMARY	ROSMARINUS OFFICINALIS 'HUNTINGTON CARPET'
		GL	GIANT LIRIOPE	LIRIOPE GIGANTEA
		IH	INDIAN HAWTHORN	RHAPHIOLEPIS INDICA 'CLARA'
		MF	MEXICAN FEATHER GRASS	STIPA TENIOSSIMA

TURF

	QNTY.	SYMBOL	COMMON NAME	BOTANIC NAME
		SSBG	SOLID SOD BERMUDA GRASS	Cynodon dactylon

EXISTING TREE

QNTY.	SYMBOL	NOTE
	PER PLAN	REFERENCE CIVIL DEMO PLANS FOR TREE PRESERVATION.

sheet location

