

~ MATCH LINE-SHEET GP-1 ~


~ MATCH LINE-SHEET GP-5 ~

~ MATCH LINE-SHEET GP-3 ~

GRADING PLAN LEGEND:

- 580 ——— EXISTING GRADE CONTOUR
- 581 ——— FINISH GRADE CONTOUR
- 587.25 ——— FINISH SPOT GRADE
- 580.00 ——— SEE CIVIL FOR CROSS REFERENCE OF PROPOSED ELEVATION
- TS ——— TOP STEP
- BS ——— BOTTOM STEP
- TW ——— TOP OF WALL
- BW ——— BOTTOM OF WALL
- TC ——— TOP OF CURB
- G ——— GUTTER
- FF ——— FINISH FLOOR
- TCOL ——— TOP OF COLUMN

sheet location

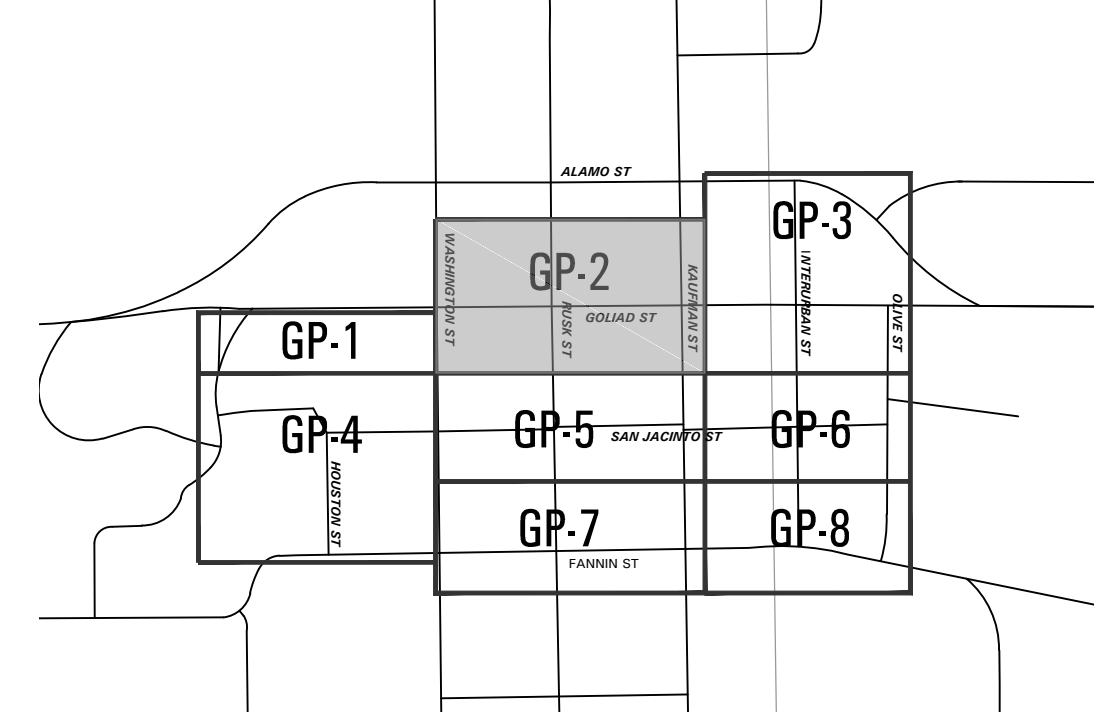

06/04/15	LASI #18
09/10/15	RFI #38
10/09/15	RFI #200, #202
10/14/15	RFI #207
12/02/15	LASI #23

Downtown Rockwall
 la terra studio Project #12024
streetscape improvements
 PHASE 2
 rockwall, texas



submittals / revisions

no.	date	detail
▲	04/11/14	RFI #39,56
▲	05/02/14	RFI #77 WEST RUSK GRADING
▲	06/17/14	RFI #93
▲	07/11/14	LASI #7
▲	07/25/14	RFI #104
▲	09/10/14	RFI #124
▲	10/27/14	RFI #140
▲	01/13/15	LASI #14
▲	02/09/15	RFI #160

la terra studio, inc.

12024
 Its project number
 02.26.2014
 date
 rac; bhm
 drawn by
 mtb
 checked by

