

**PLANT AND MATERIALS LIST:** NOTE: CONTRACTOR TO VERIFY QUANTITIES PER PLANS

**CANOPY TREES**

QNTY.	SYMBOL	COMMON NAME	BOTANIC NAME
	CP	CHINESE PISTACHE	PISTACHIA CHINENSIS

**SHRUBS**

QNTY.	SYMBOL	COMMON NAME	BOTANIC NAME
	MF	MEXICAN FEATHER GRASS	STIPA TENIOSSIMA
	CR	CARPET ROSEMARY	ROSMARINUS OFFICINALIS 'HUNTINGTON CARPET'

**GROUND COVER**

QNTY.	SYMBOL	COMMON NAME	BOTANIC NAME
-------	--------	-------------	--------------

136	LIR MUS	LILY TURF	LIRIOPE MUSCARI
475	OPH JAP	DWARF MONDO GRASS	OPHIPOGON JAPONICA


**TURF**

QNTY.	SYMBOL	COMMON NAME	BOTANIC NAME
	SSBG	SOLID SOD BERMUDA GRASS	Cynodon dactylon

**EXISTING TREE**

QNTY.	SYMBOL	NOTE
	PER PLAN	REFERENCE CIVIL DEMO PLANS FOR TREE PRESERVATION.

**sheet location**

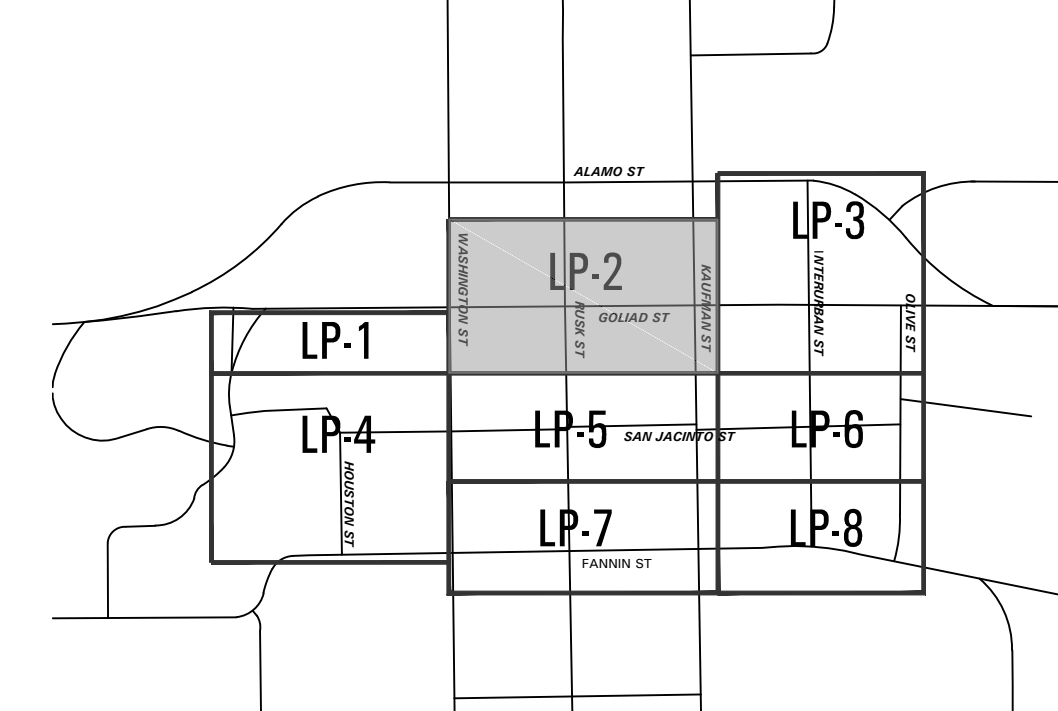

**Downtown Rockwall**  
 la terra studio Project #12024  
**streetscape improvements**  
 PHASE 2  
 rockwall, texas



submittals / revisions

no.	date	detail
△	07/14/14	RFI #101
△	07/29/14	RFI #114
△	08/20/14	RFI #119
△	09/10/14	RFI #124
△	09/17/15	LASI #22
△	12/02/15	LASI #23

la terra studio, inc.

12024  
 Its project number  
 02.26.2014  
 date  
 rac; bhm  
 drawn by  
 mtb  
 checked by

