

© 2013 la terra studio, inc. All Rights Reserved FILE:R:\12024-Downtown Rockwall PS&E - Rockwall\CAD\ISHEET\12024-Site Details_12.dwg



submittals / revisions

no.	date	detail
△	06/04/15	LASI #18
△	12/02/15	LASI #23

la terra studio, inc.

12024
 its project number
 02.26.2014
 date
 rac; bhm
 drawn by
 mtb
 checked by


registration




02.26.2014
 sheet title

△ Site Details
 sheet number


SD-12

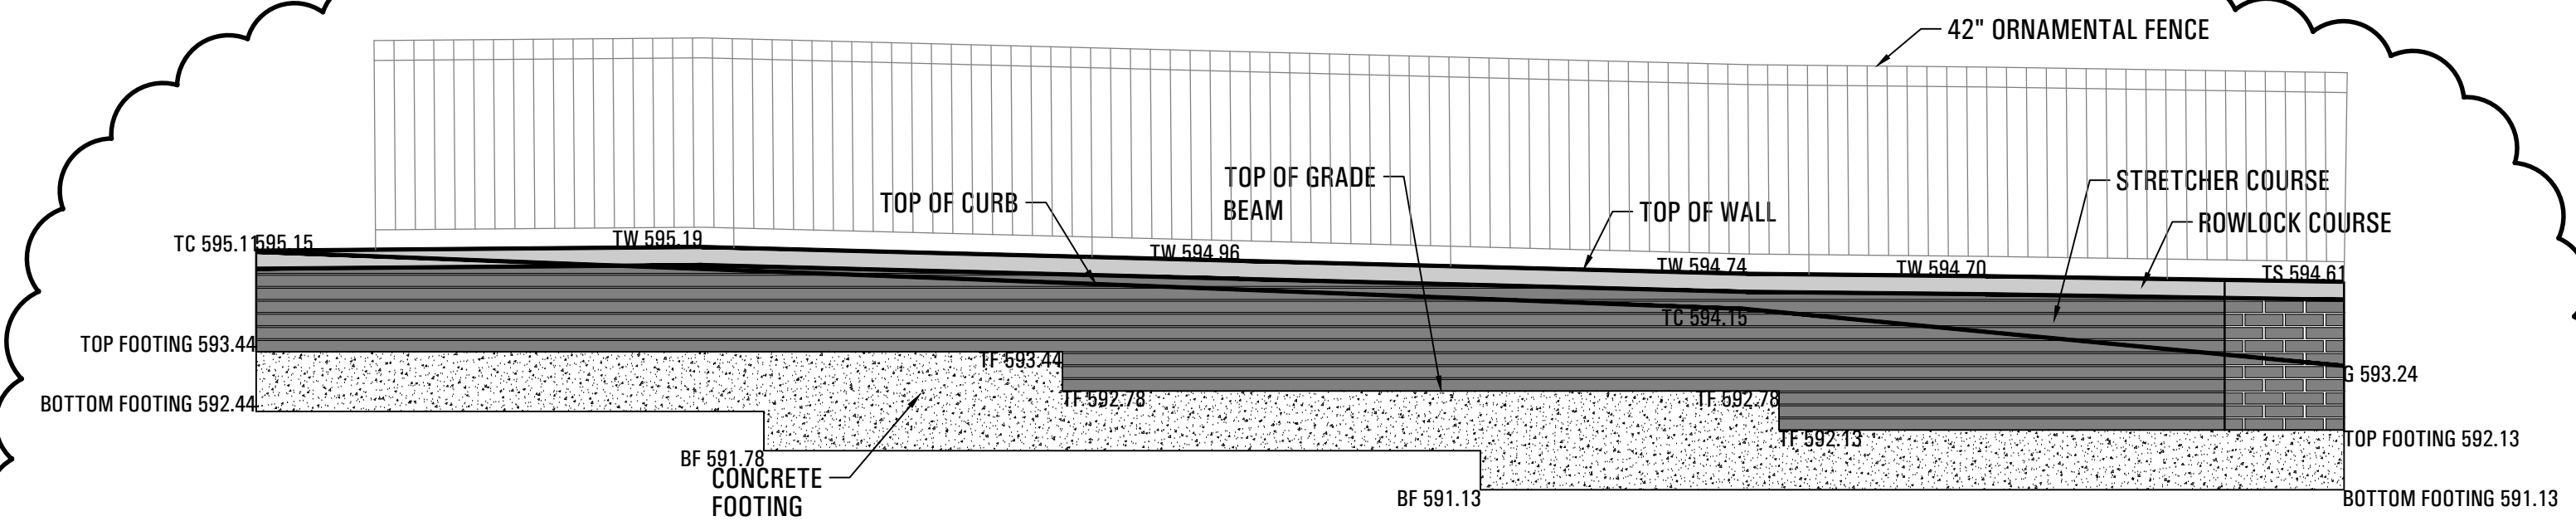


1 WALL ELEVATION - 101 E. RUSK ST.
 SCALE: 3/8" = 1'-0"

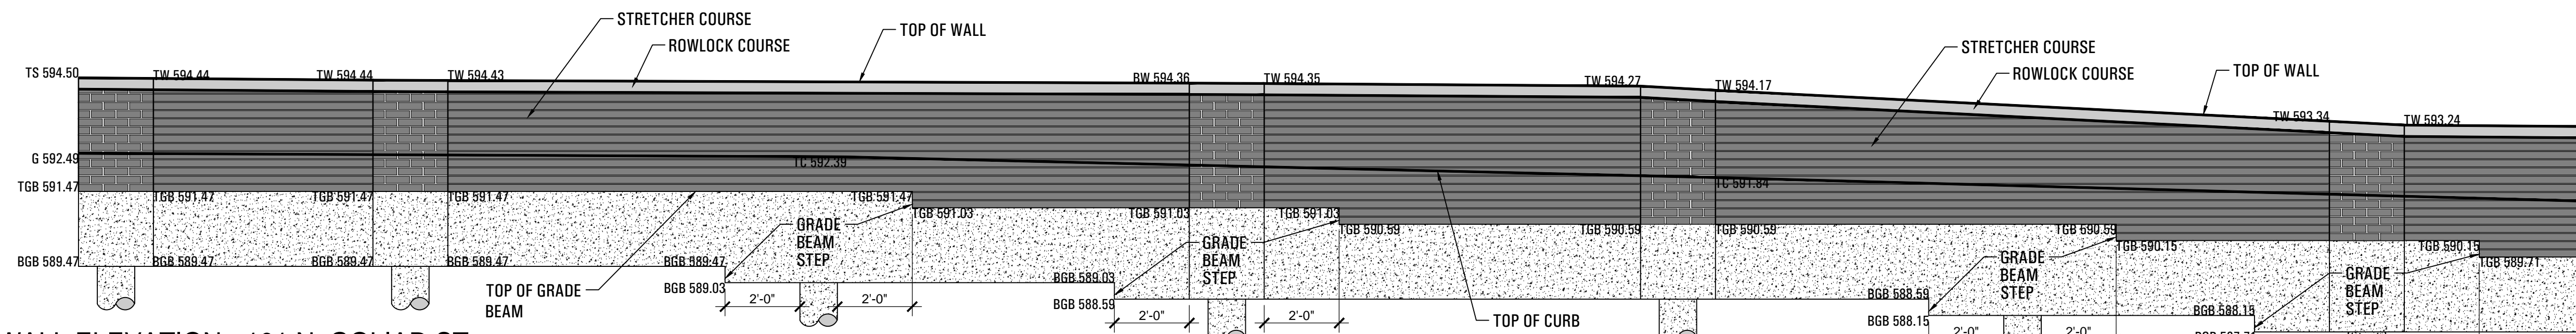

2 WALL ELEVATION - 101 N. GOLIAD ST.
 SCALE: 3/8" = 1'-0"

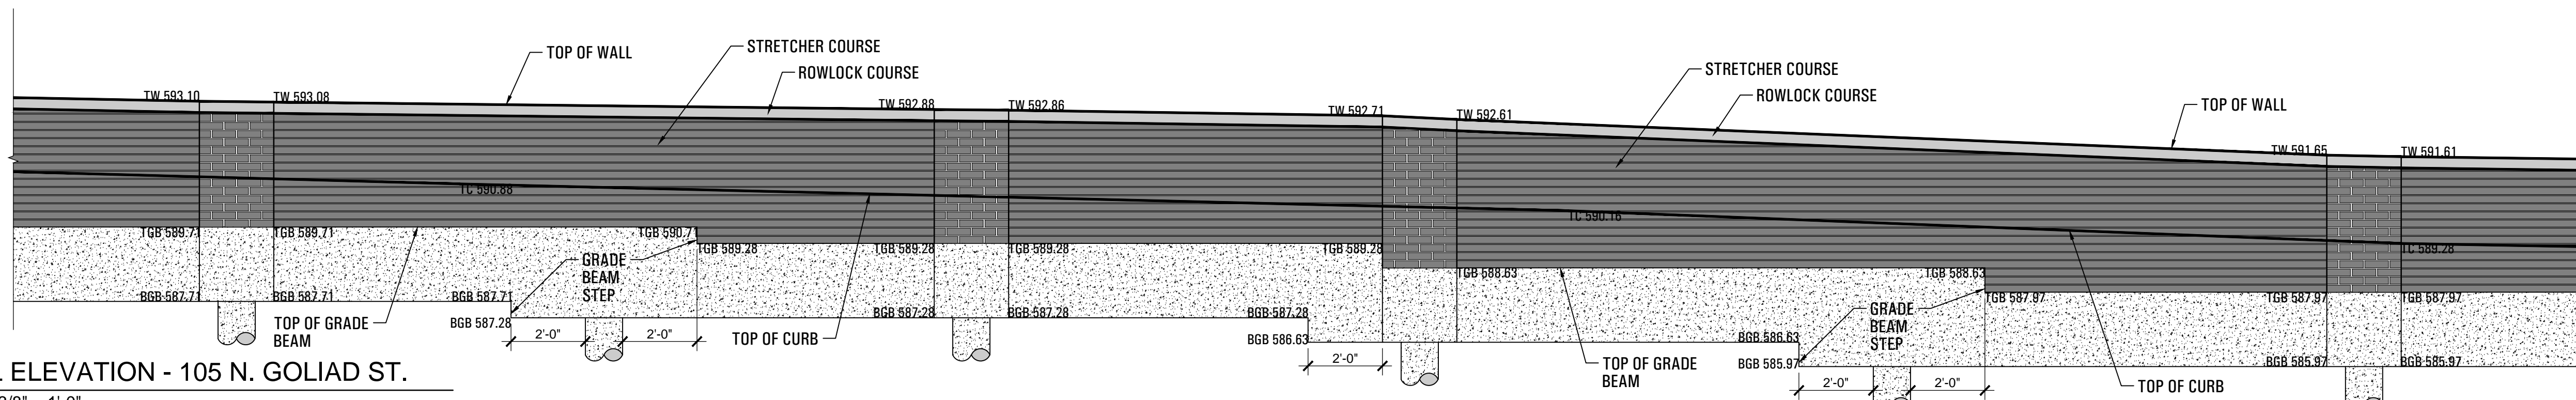

3 WALL ELEVATION - 105 N. GOLIAD ST.
 SCALE: 3/8" = 1'-0"

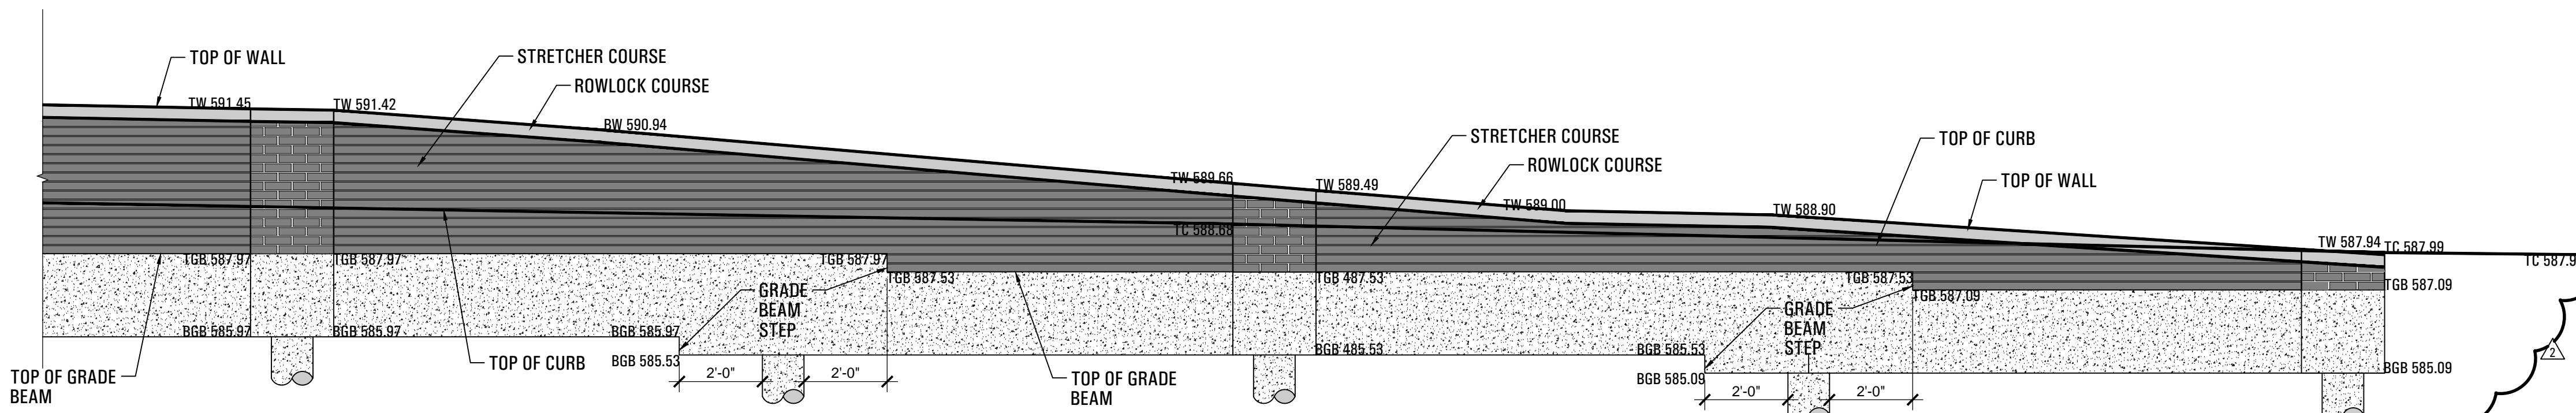

4 WALL ELEVATION - 109 N. GOLIAD ST.
 SCALE: 3/8" = 1'-0"