

© 2013 la terra studio, inc. All Rights Reserved FILE:R:\12024-Downtown Rockwall PS&E - Rockwall\CAD\Sheet\12024-Strt Details_7.dwg




submittals / revisions

no.	date	detail
1	12/02/15	LASI #23

la terra studio, inc.

12024
 its project number
 02.26.2014
 date
 rac; bhm
 drawn by
 mtb
 checked by


registration

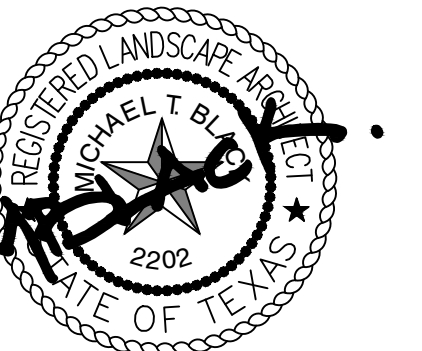



02.26.2014
 sheet title

Site Details
 sheet number



SD-7

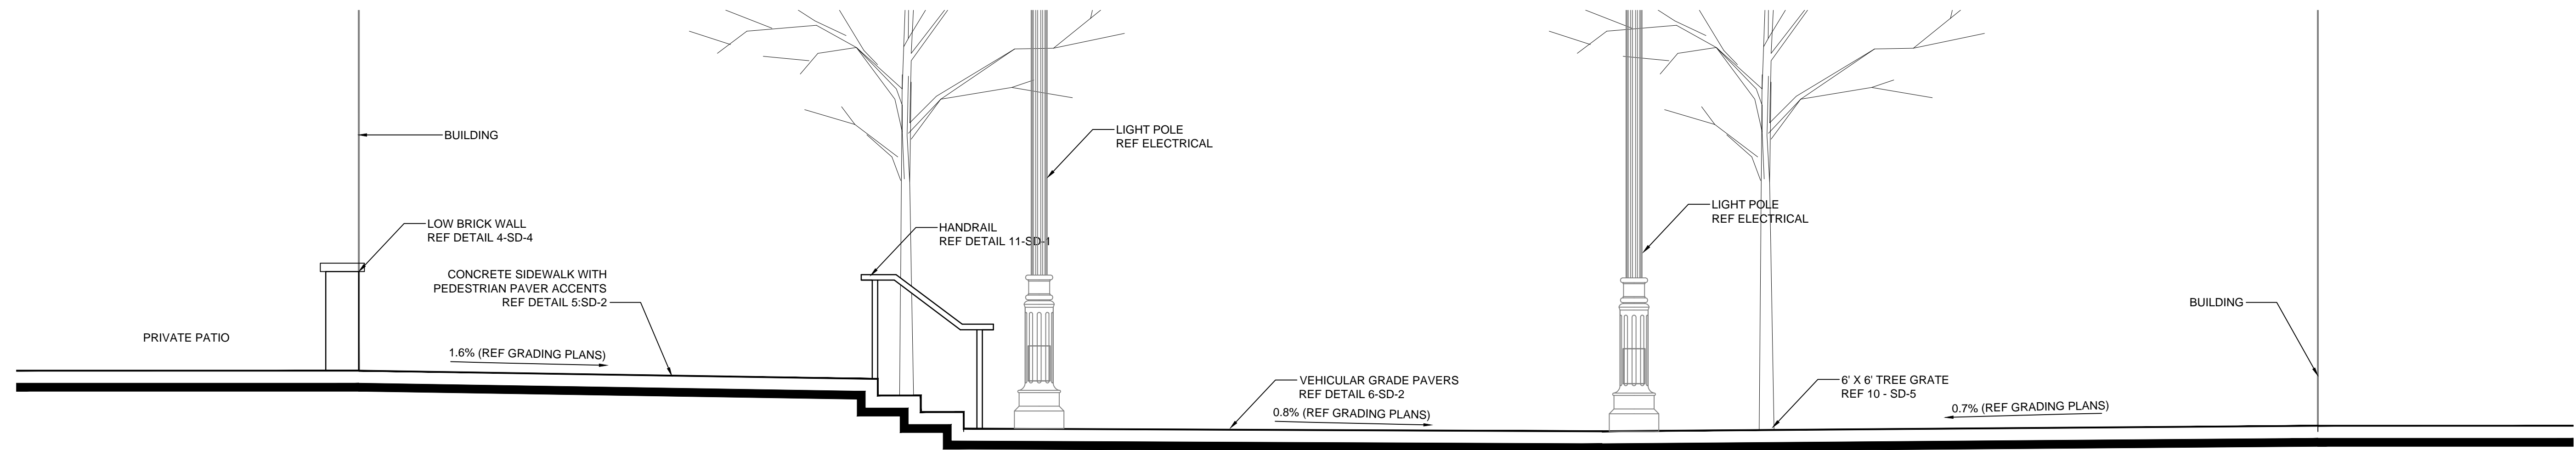



1 PEDESTRIAN PLAZA SECTION
 SCALE: 3/8" = 1'-0"

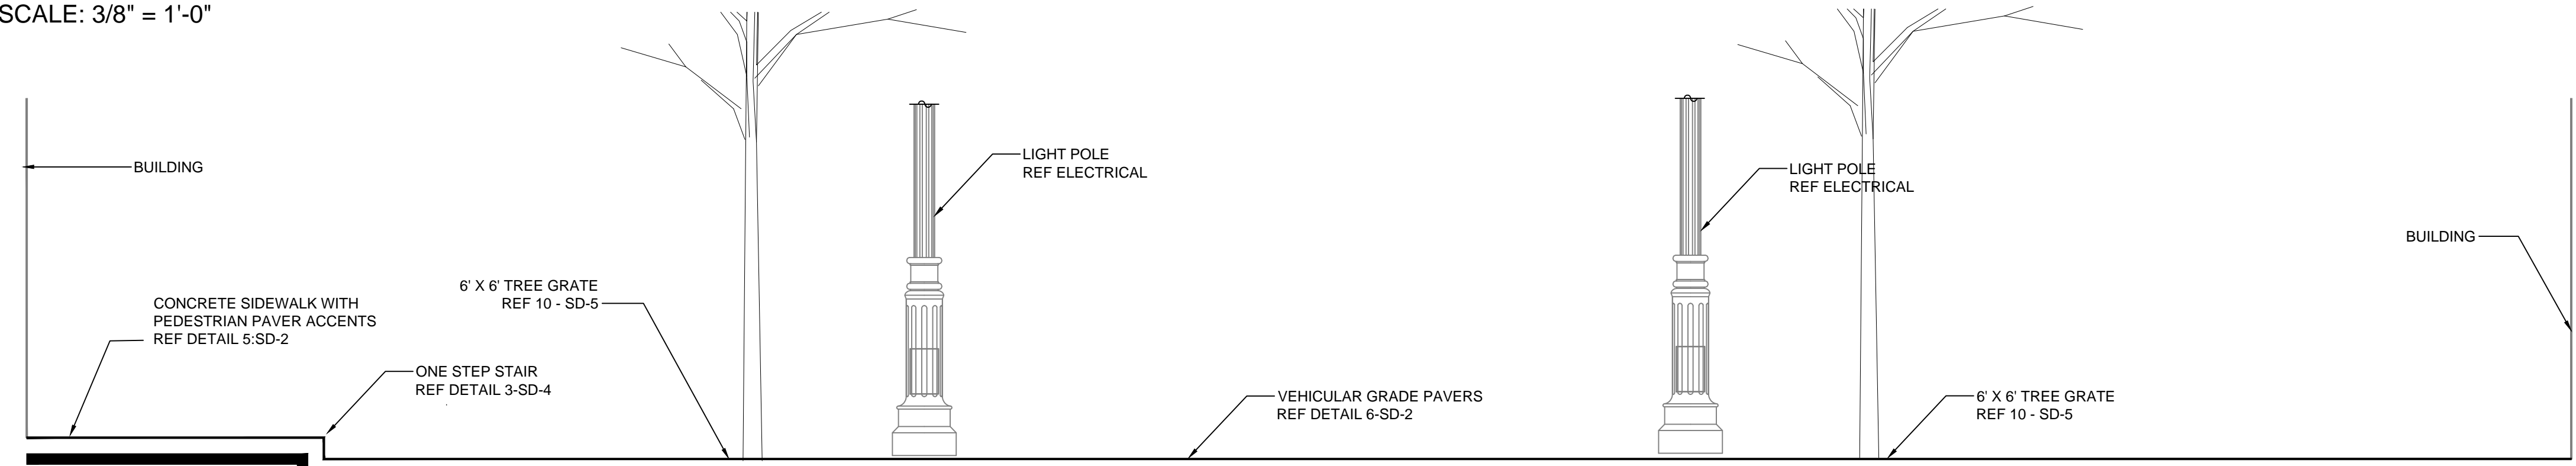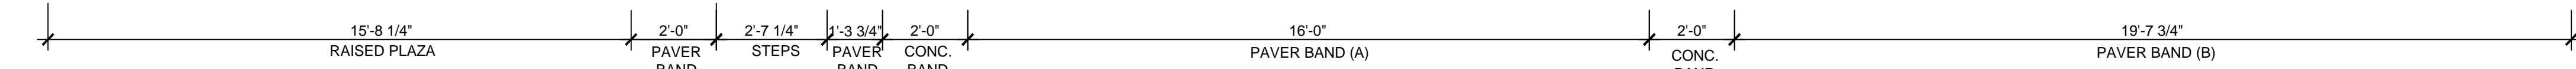

2 PEDESTRIAN PLAZA SECTION
 SCALE: 3/8" = 1'-0"

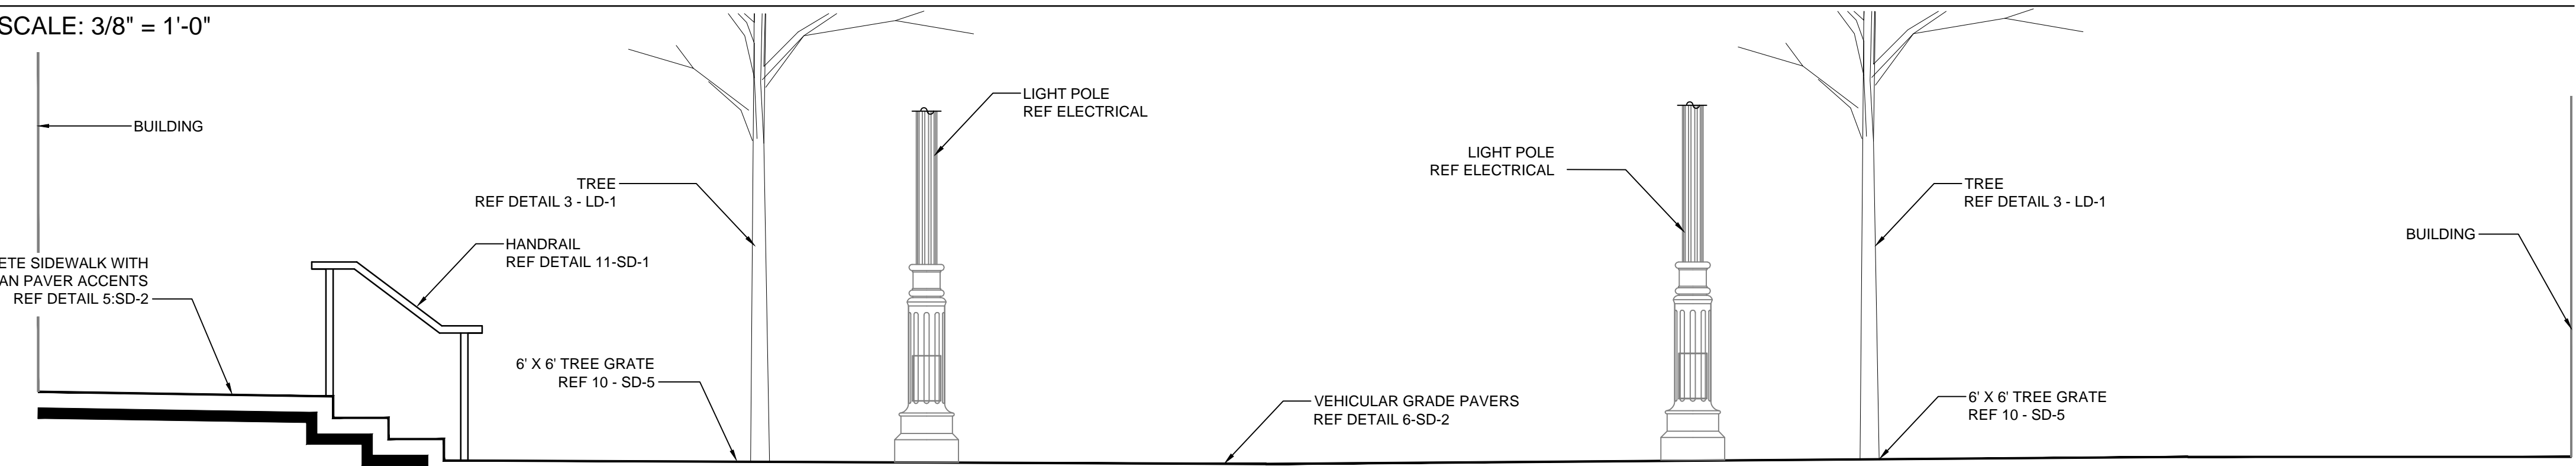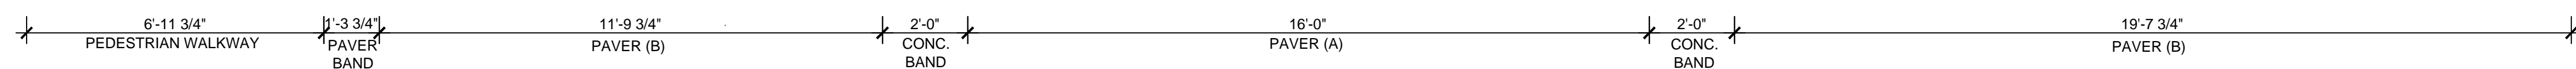

3 PEDESTRIAN PLAZA SECTION
 SCALE: 3/8" = 1'-0"

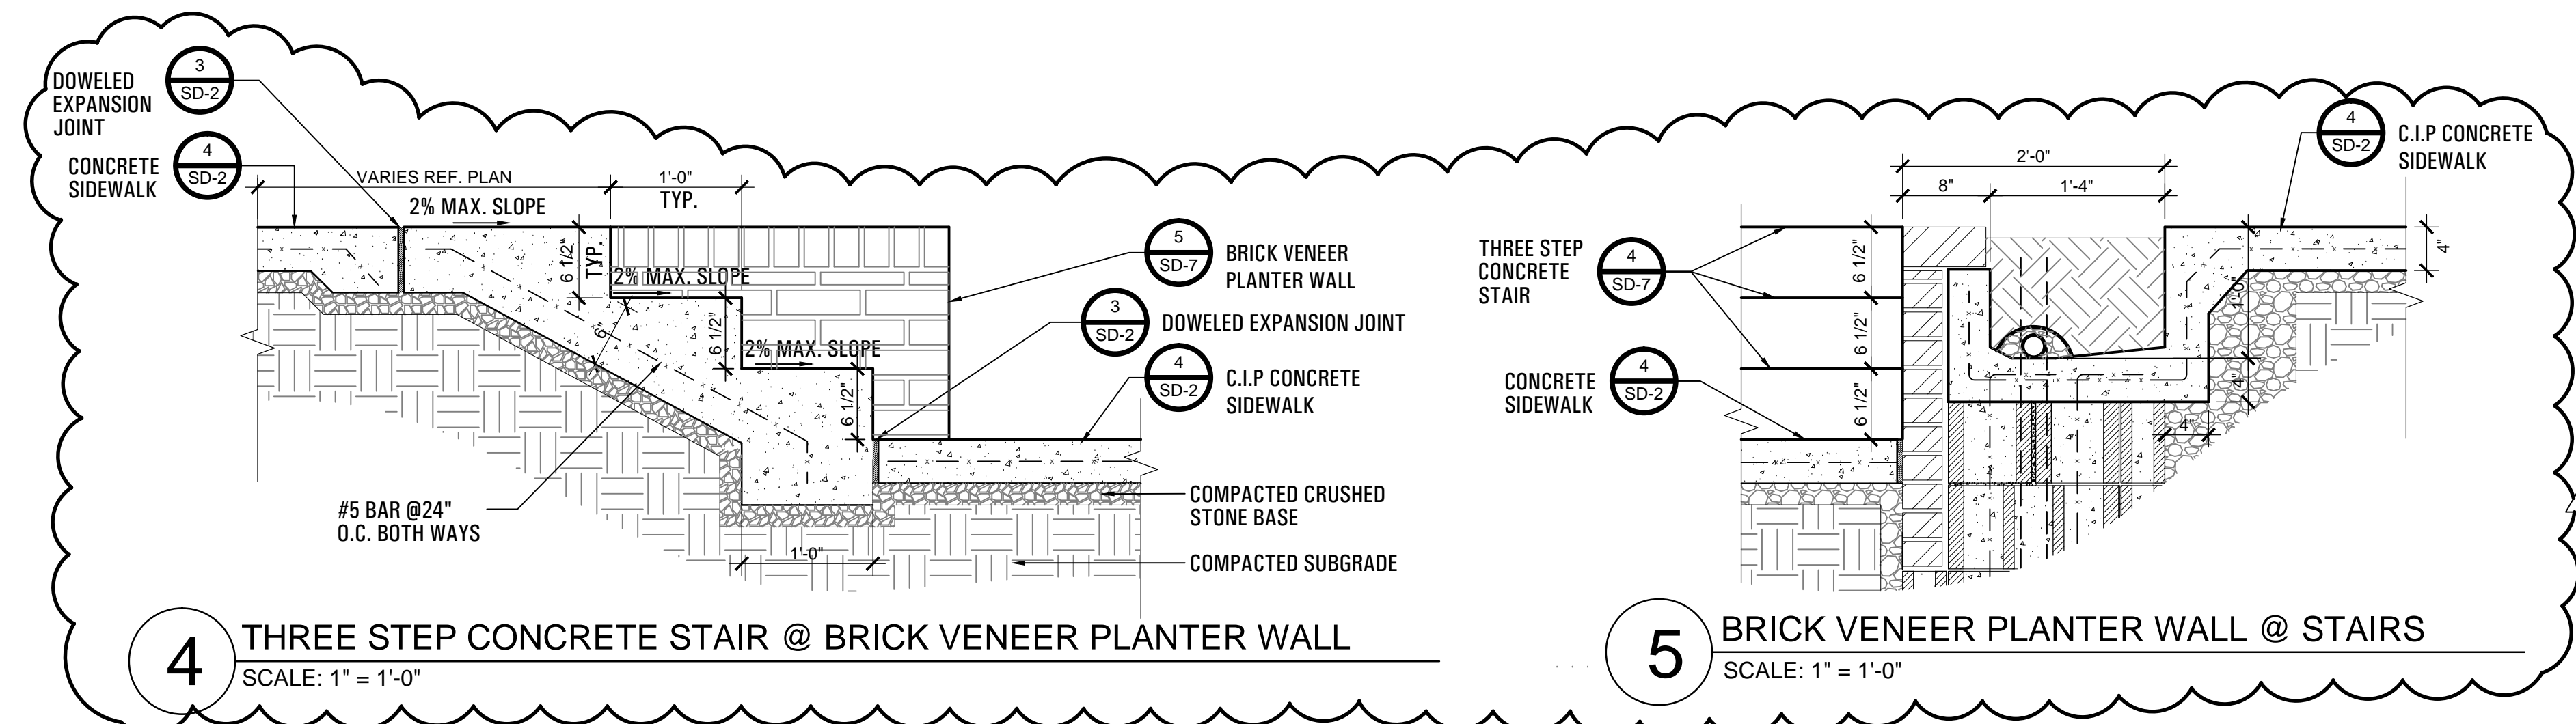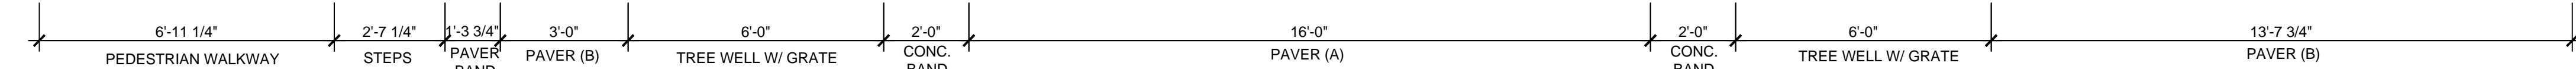

4 THREE STEP CONCRETE STAIR @ BRICK VENEER PLANTER WALL
 SCALE: 1" = 1'-0"

5 BRICK VENEER PLANTER WALL @ STAIRS
 SCALE: 1" = 1'-0"