


SITE PLAN LEGEND:

- PROJECT LIMIT LINE
- EDGE OF PAVEMENT
- CONCRETE SIDEWALK PAVEMENT
- CONCRETE VEHICULAR PAVEMENT
- TYPICAL LIGHT FIXTURE

sheet location

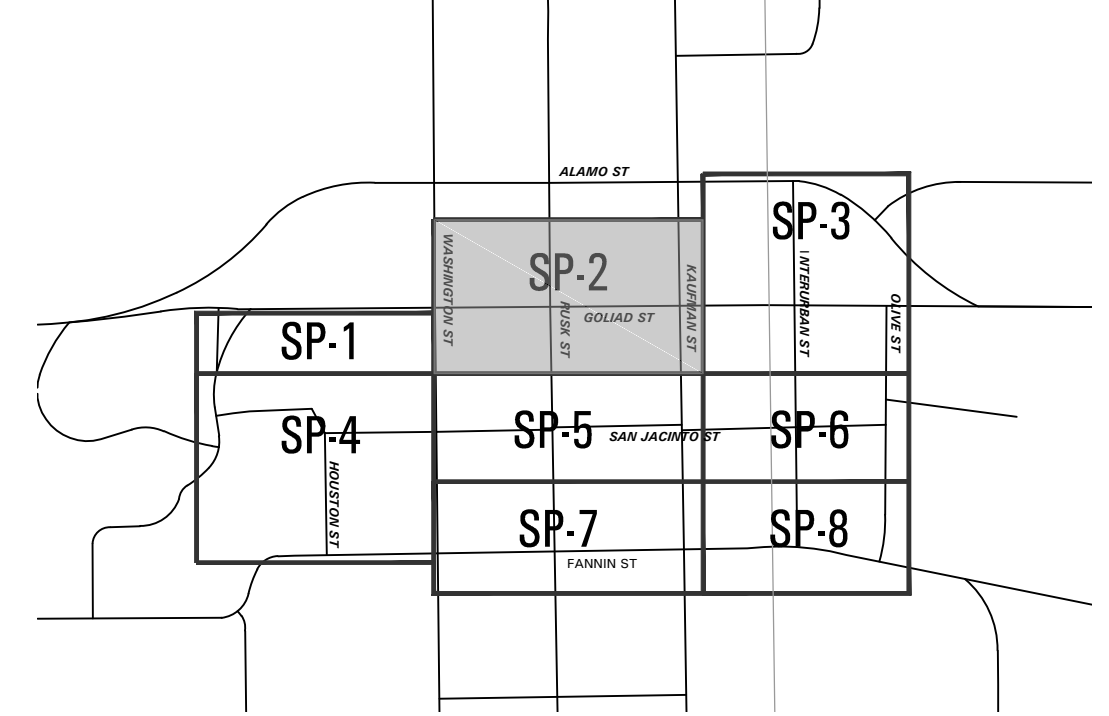

Downtown Rockwall
 la terra studio Project #12024
streetscape improvements
 PHASE 2
 rockwall, texas

submittals / revisions

no.	date	detail
△ 04/10/14		RFI #23
△ 09/10/14		RFI #124
△ 09/10/15		RFI #38
△ 09/28/15		RFI #196
△ 12/02/15		LASI #23

la terra studio, inc.
 12024
 its project number
 02.26.2014
 date
 rac; bhm
 drawn by
 mtb
 checked by

