


**LEGEND:**

- PROJECT LIMIT LINE
- TYPICAL LIGHT FIXTURE



**sheet location**

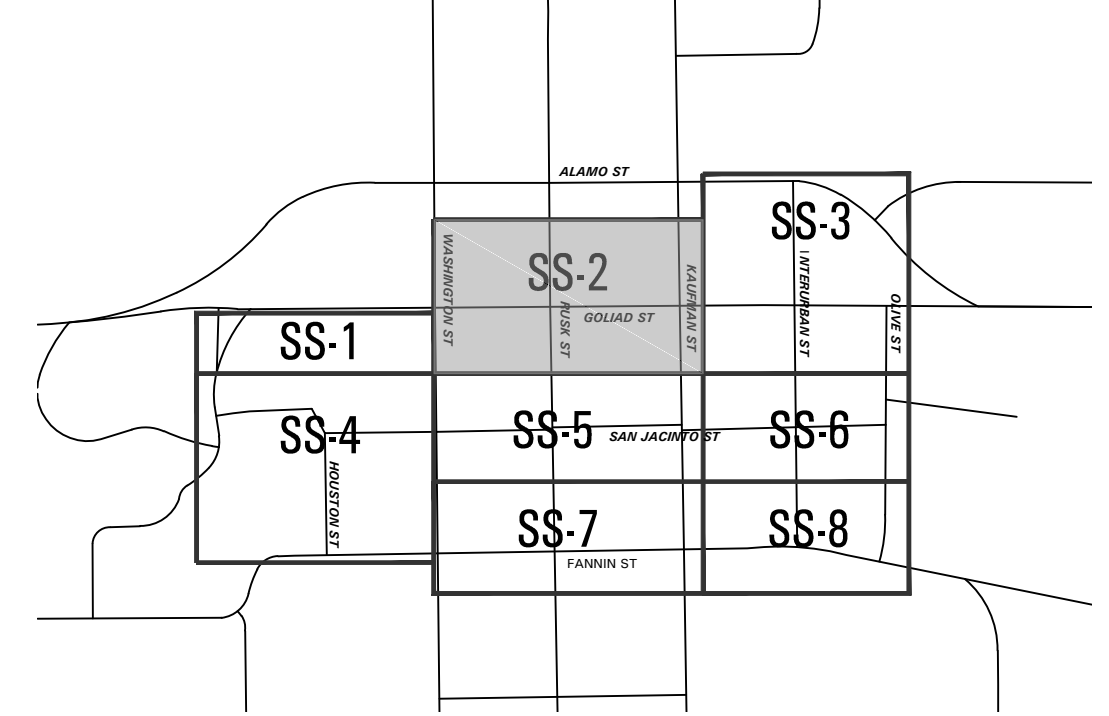

**Downtown Rockwall**  
 la terra studio Project #12024  
**streetscape improvements**  
 PHASE 2  
 rockwall, texas



submittals / revisions

no.	date	detail
▲	03/01/14	RFI #35
▲	09/23/14	RFI #115
▲	12/18/14	RFI #115
▲	10/14/15	RFI #197
▲	12/02/15	LASI #23

la terra studio, inc.  
 12024  
 its project number  
 02.26.2014  
 date  
 rac; bhm  
 drawn by  
 mtb  
 checked by



02.26.2014  
 sheet title  
**Subsurface Drainage Plan**  
 sheet number  
**SS-2**