



1 COURTHOUSE STAGE AREA PLAN - POWER - PHASE 2
SCALE: 1/8" = 1'-0"

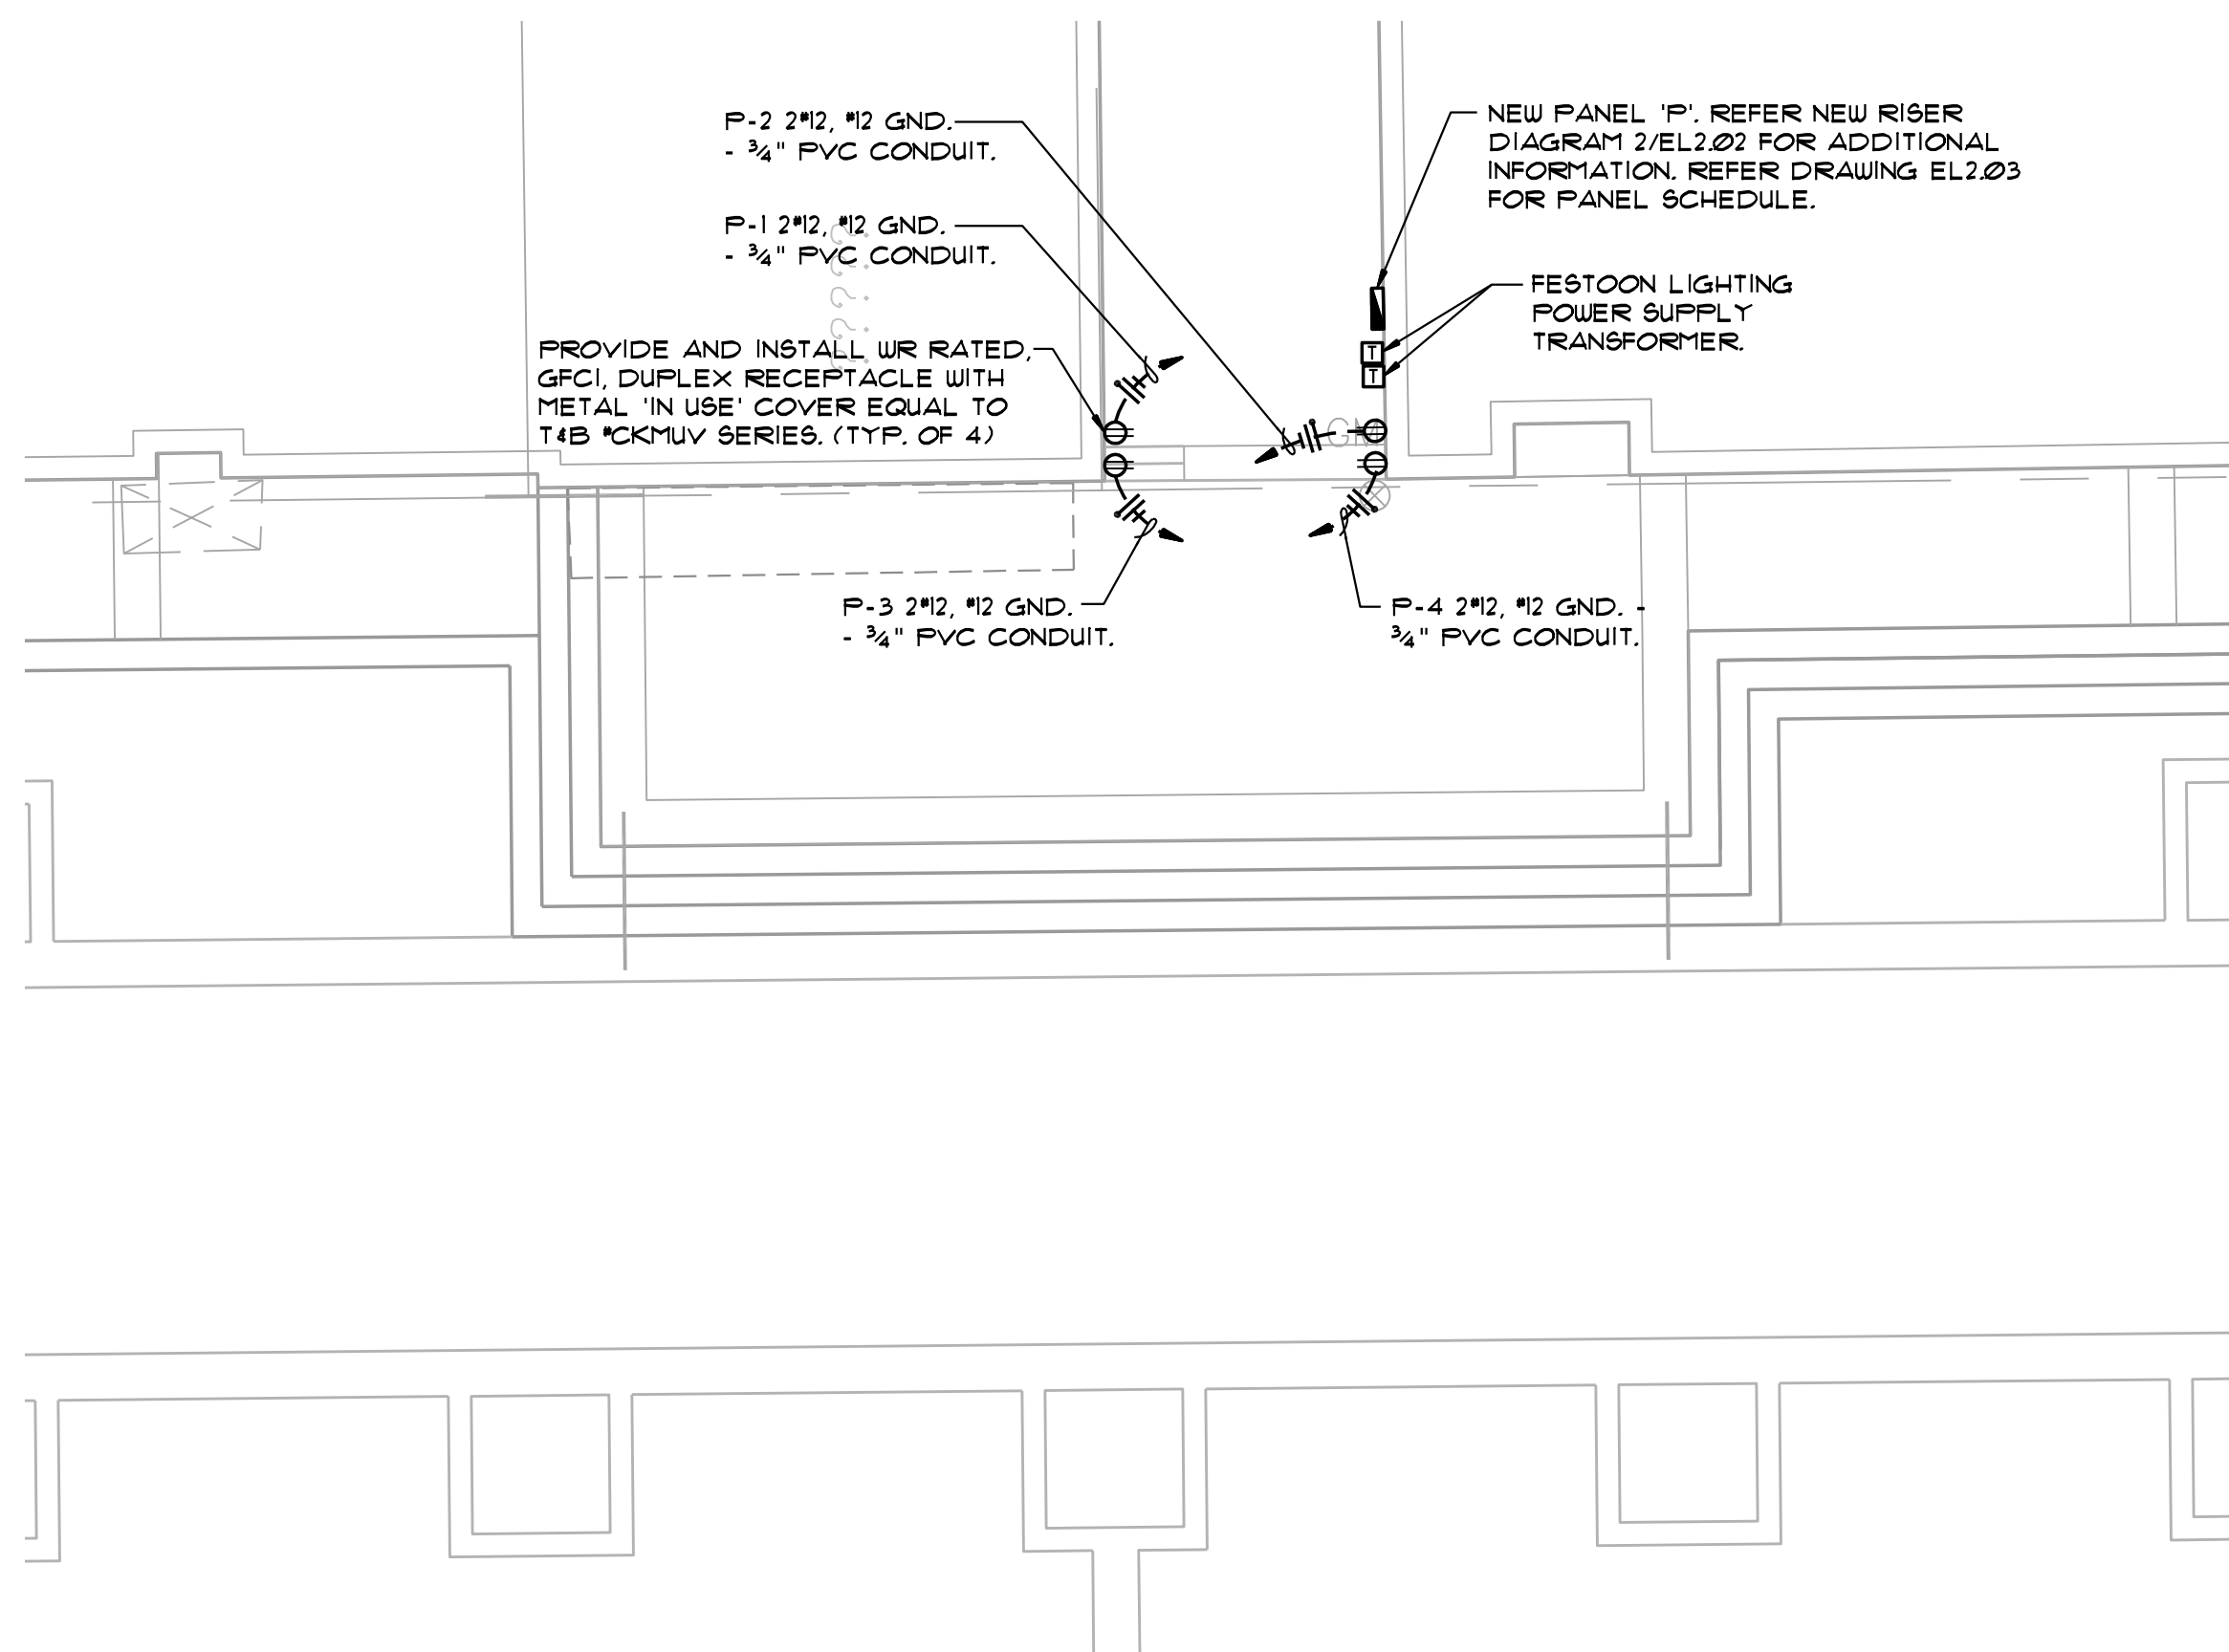

2 SAN JACINTO ST. PEDESTRIAN MALL PLAN - POWER - PHASE 2
SCALE: 1/8" = 1'-0"

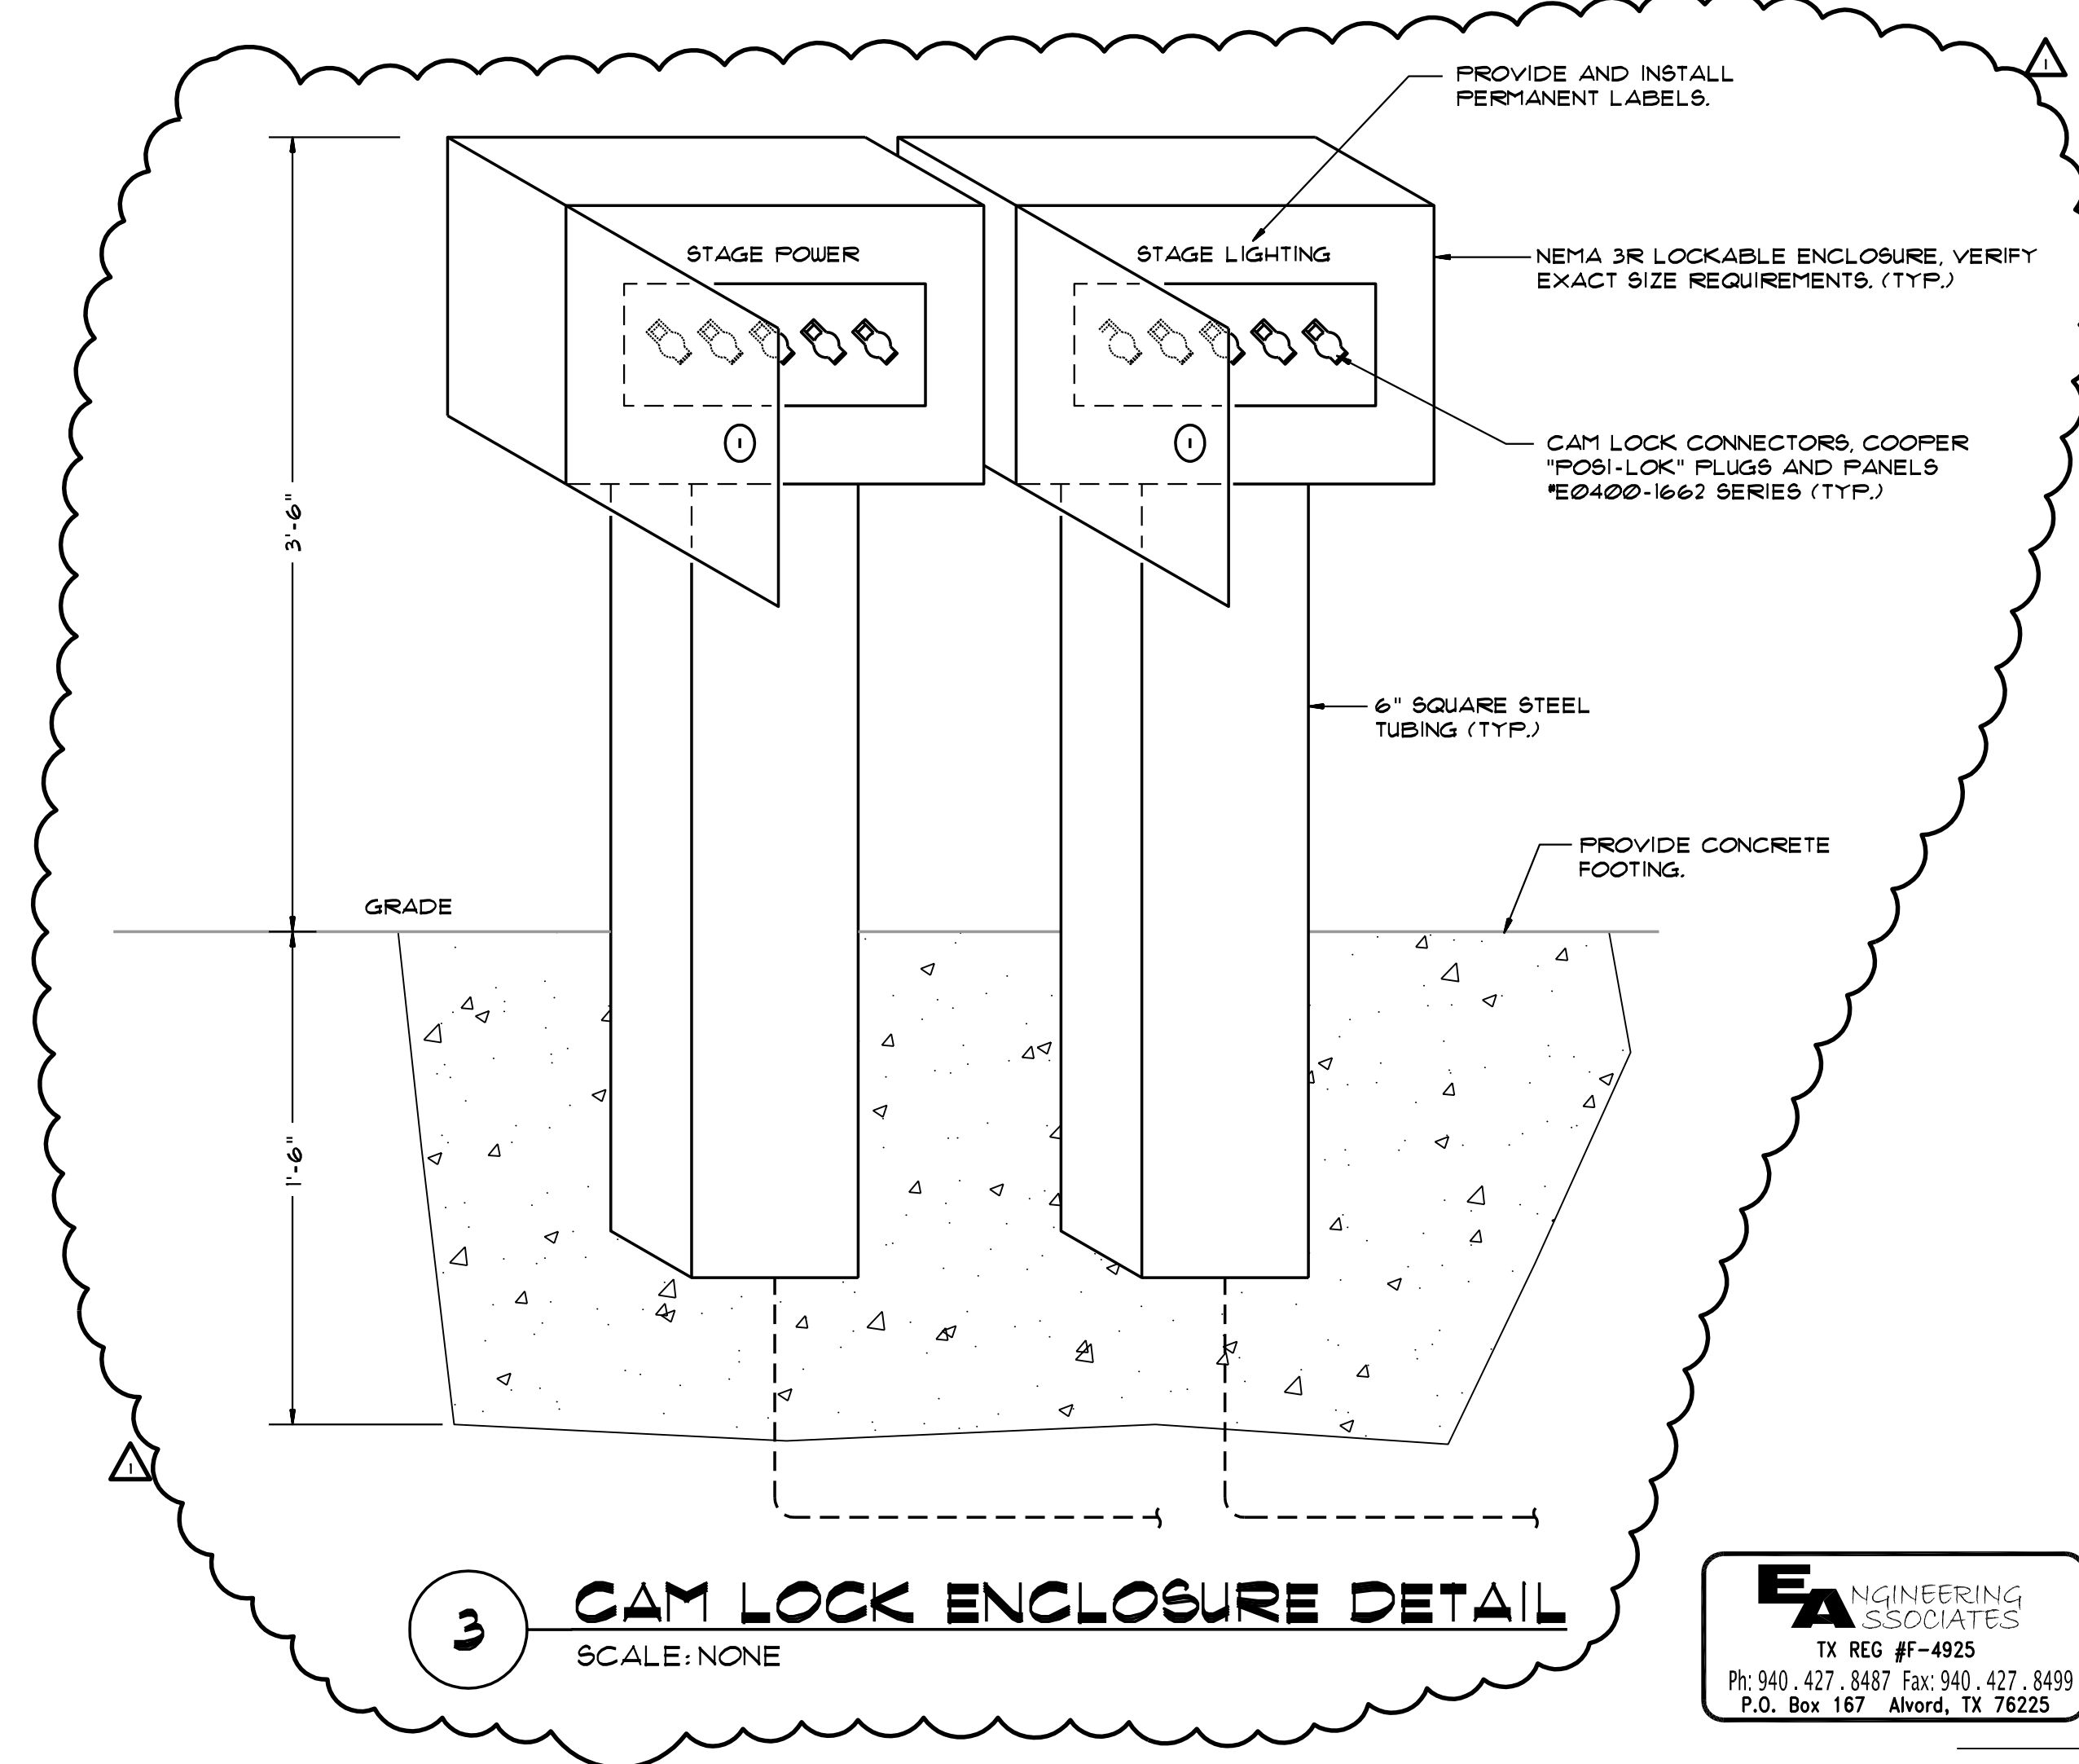

3 CAM LOCK ENCLOSURE DETAIL
SCALE: NONE

EA ENGINEERING ASSOCIATES
TX REG #F-4925
Ph: 940.427.8487 Fax: 940.427.8499
P.O. Box 167 Alford, TX 76225

submittals / revisions

no.	date	detail
Δ	4/2/2014	Electrical Revisions

la terra studio, inc.
12024
Its project number
02.26.2014
date
C.A.D.
drawn by
J.W.
checked by
registration

