


GRADING PLAN LEGEND:

- 580 ——— EXISTING GRADE CONTOUR
- 581 ——— FINISH GRADE CONTOUR
- 587.25 ——— FINISH SPOT GRADE
- 580.00 ——— SEE CIVIL FOR CROSS REFERENCE OF PROPOSED ELEVATION
- TS ——— TOP STEP
- BS ——— BOTTOM STEP
- TW ——— TOP OF WALL
- BW ——— BOTTOM OF WALL
- TC ——— TOP OF CURB
- G ——— GUTTER
- FF ——— FINISH FLOOR
- TCOL ——— TOP OF COLUMN

sheet location

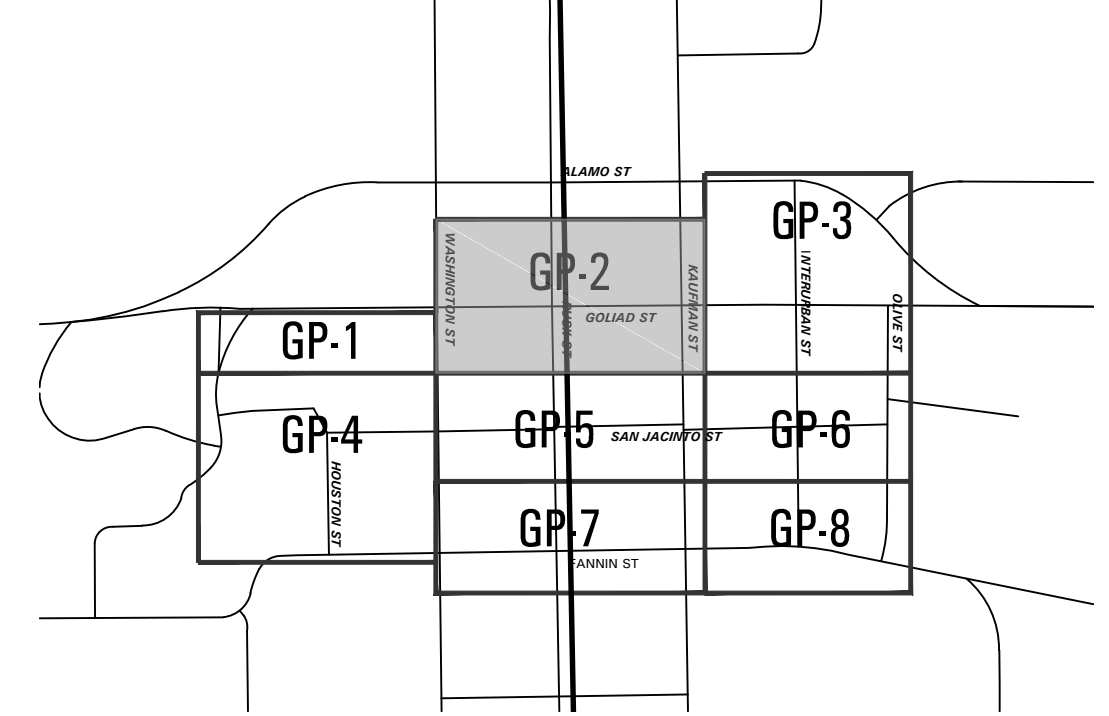

Downtown Rockwall
 la terra studio Project #12024
streetscape improvements
 PHASE 2
 rockwall, texas

submittals / revisions

no.	date	detail
△	04/11/14	RFI #39,56
△	05/02/14	RFI #77 WEST RUSK GRADING
△	06/17/14	RFI #93
△	07/11/14	LASI #7

la terra studio, inc.
 12024
 Its project number
 02.26.2014
 date
 rac; bhm
 drawn by
 mtb
 checked by

