

no.	date	detail
12/11/13	ADDENDUM #2	
7/11/14	LASI #7	


la terra studio, inc.

12024
 Its project number
 02.26.2014
 date
 JHB
 drawn by
 CMJ
 checked by

registration

sheet title
STORM DRAINAGE PLAN
 sheet number
C6-8

MATCH LINE - SHEET C6-6

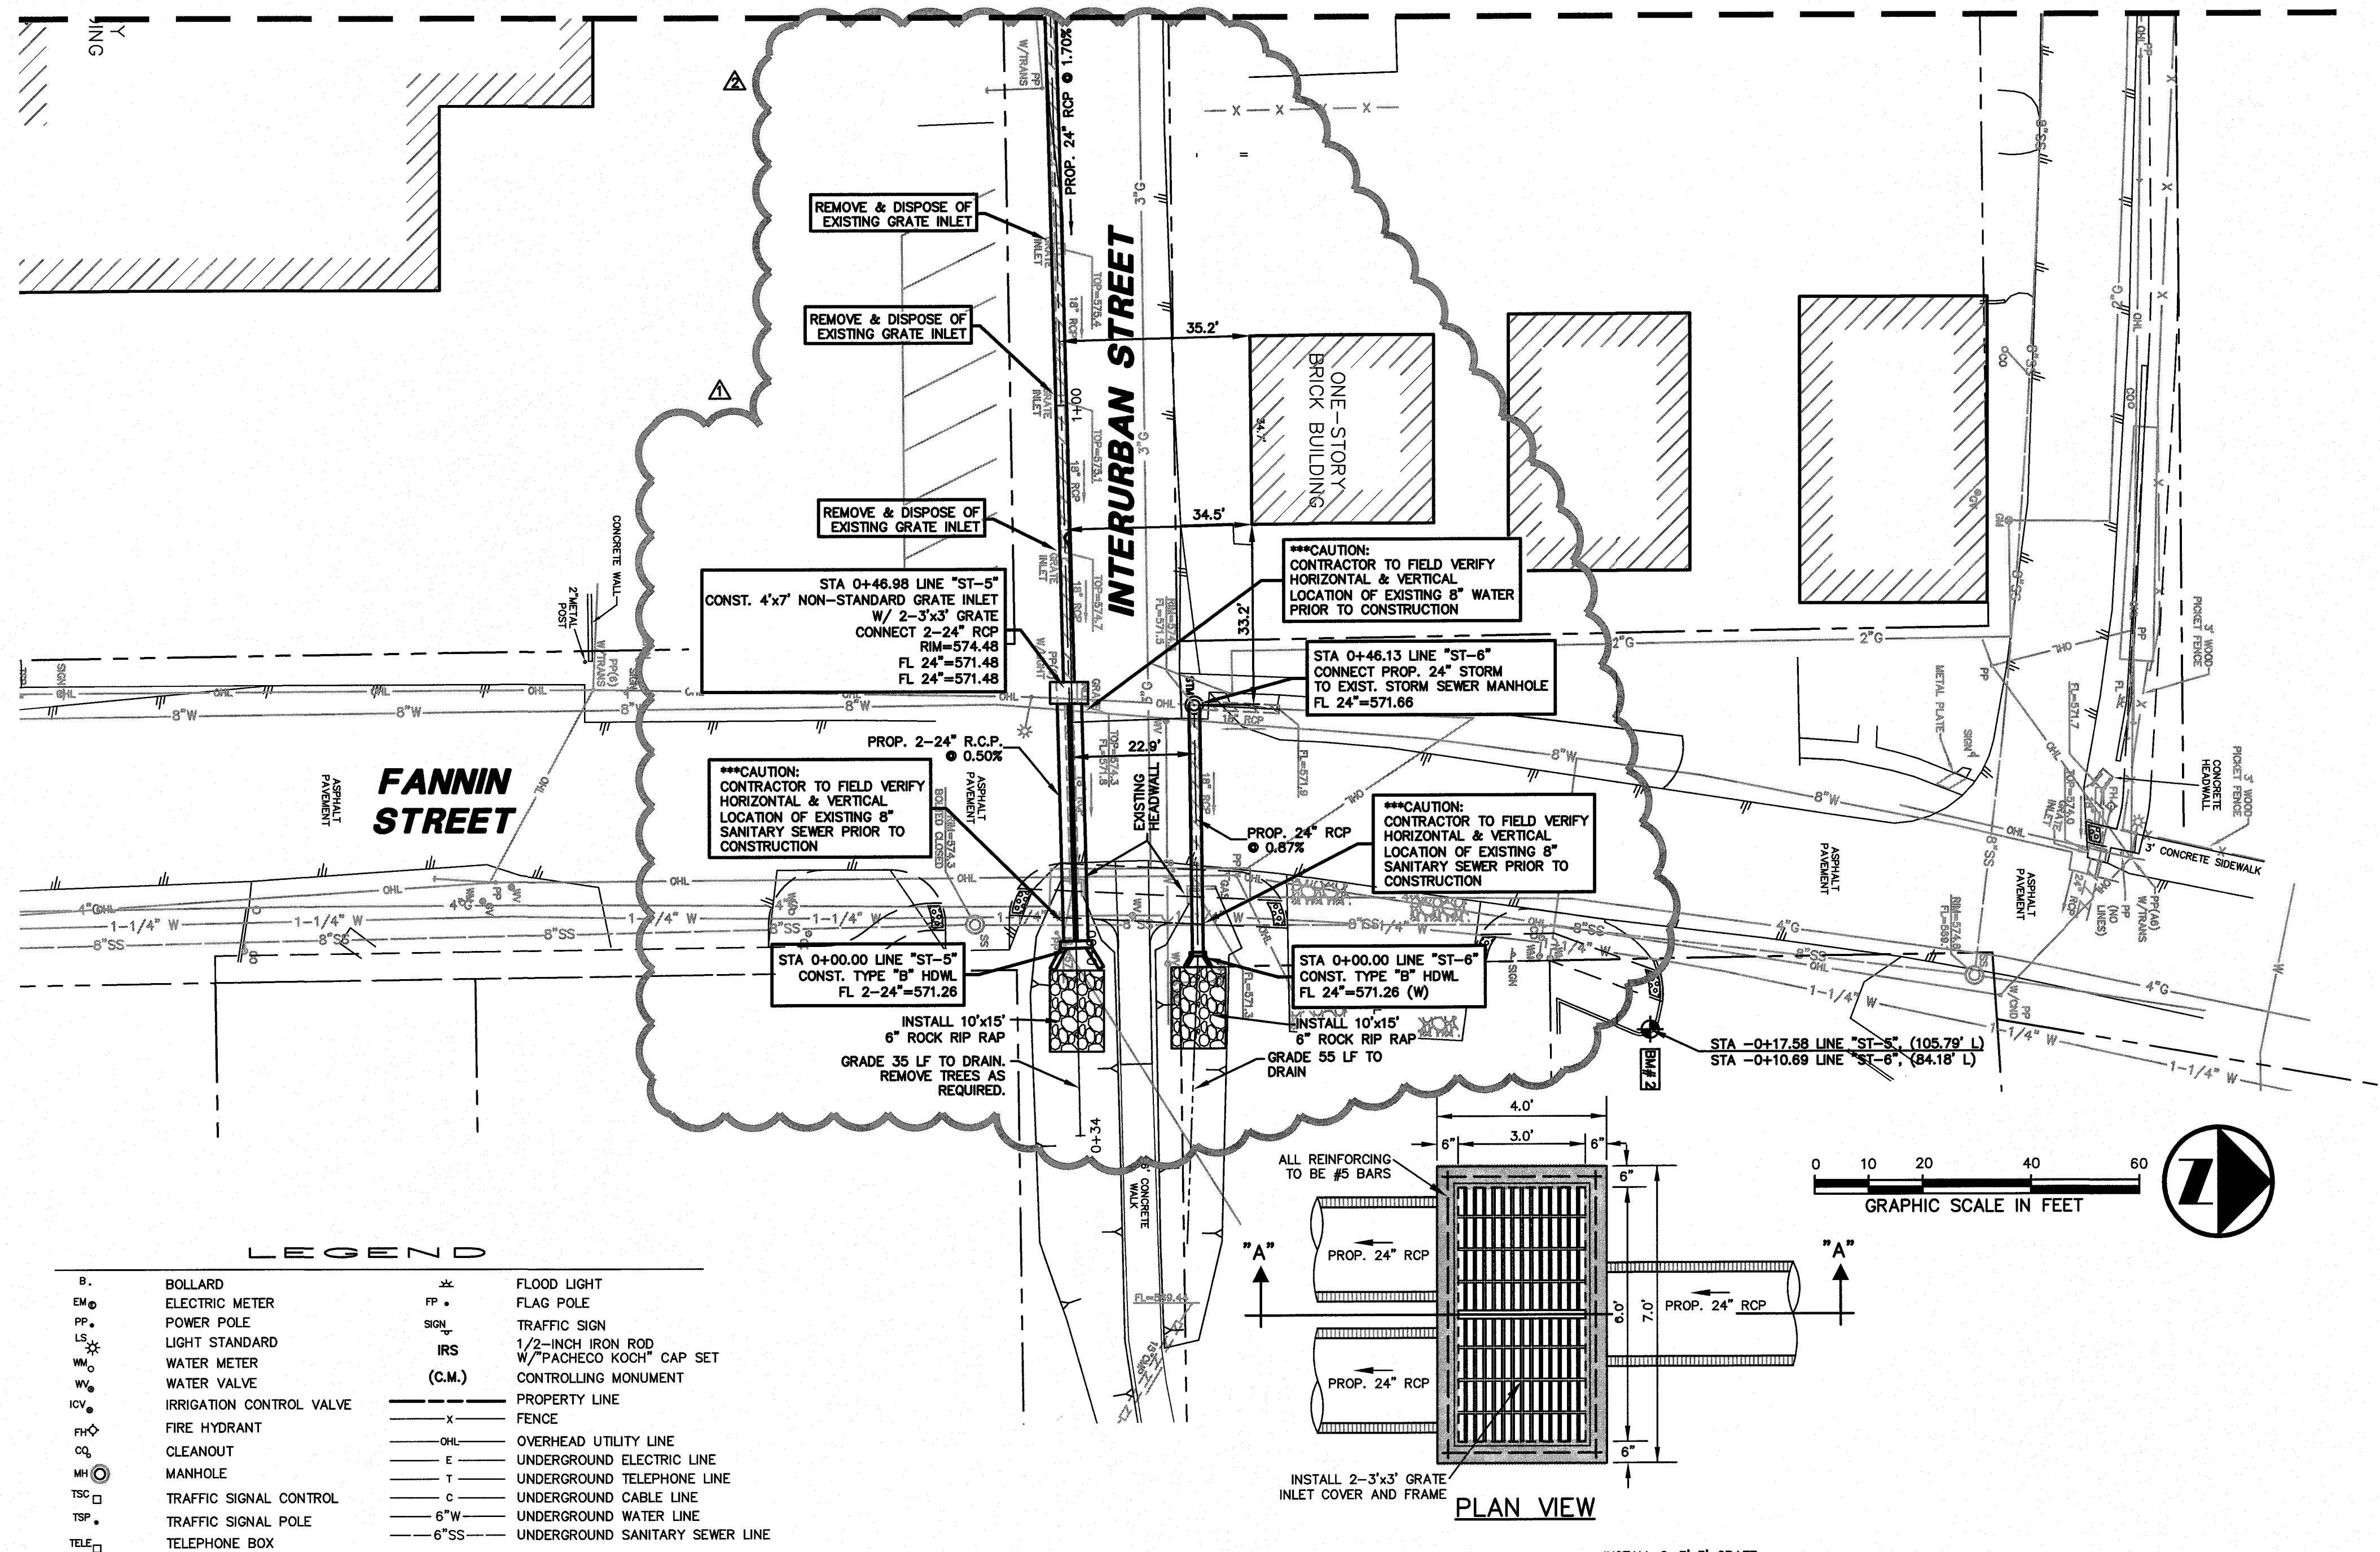

STATE OF TEXAS
 CHRISTOPHER M. JONES, P.E. 82681
 REGISTERED PROFESSIONAL ENGINEER

THE SEAL APPEARING ON THIS DOCUMENT WAS AUTHORIZED BY CHRISTOPHER M. JONES, P.E. 82681 ON 05/12/14. ALTERATION OF A SEALED DOCUMENT WITHOUT PROPER NOTIFICATION TO THE RESPONSIBLE ENGINEER IS AN OFFENSE UNDER THE TEXAS ENGINEERING PRACTICE ACT.

