

**PLANT AND MATERIALS LIST:** NOTE: CONTRACTOR TO VERIFY QUANTITIES PER PLANS


**TURF**

QNTY.	SYMBOL	COMMON NAME	BOTANIC NAME
		SSBG SOLID SOD BERMUDA GRASS	Cynodon dactylon

**EXISTING TREE**

QNTY.	SYMBOL	NOTE
		PER PLAN REFERENCE CIVIL DEMO PLANS FOR TREE PRESERVATION.

**sheet location**

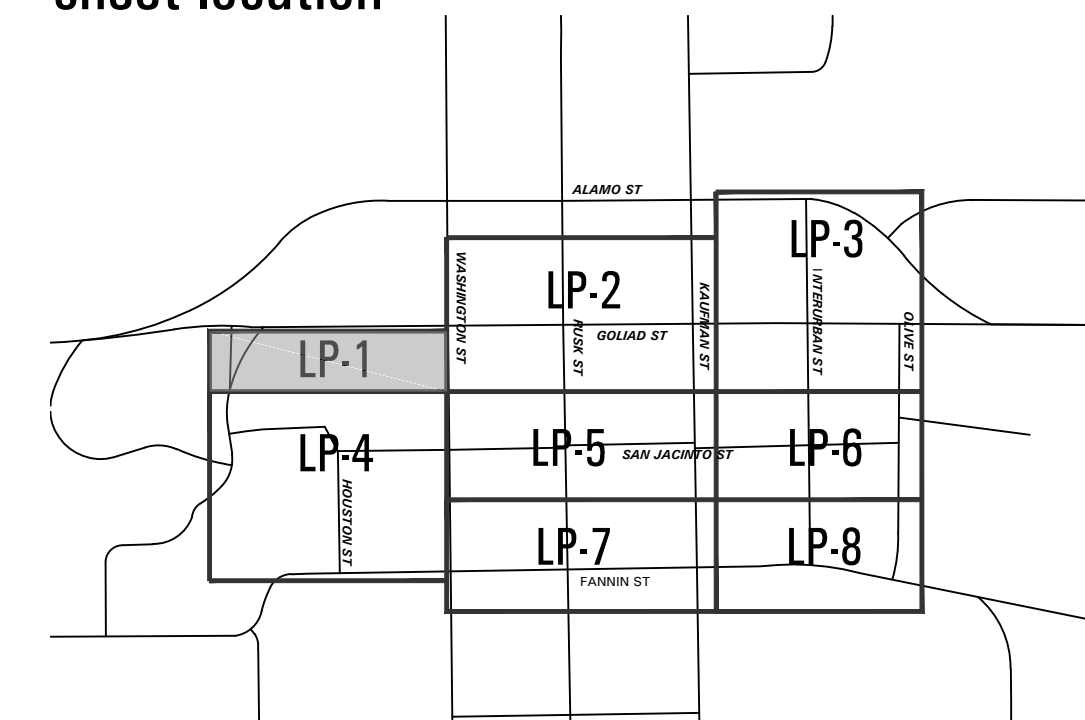

**Downtown Rockwall**  
 la terra studio Project #12024  
**streetscape improvements**  
 PHASE 2  
 rockwall, texas




submittals / revisions

no.	date	detail

la terra studio, inc.

12024  
 its project number  
 02.26.2014  
 date  
 rac; bhm  
 drawn by  
 mtb  
 checked by

registration

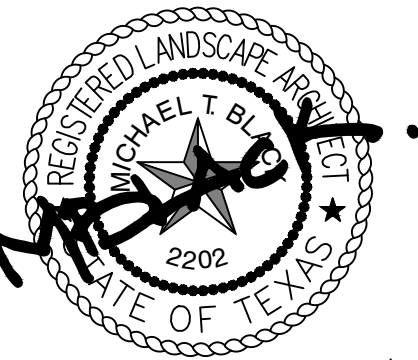

02.26.2014  
 sheet title

**Landscape Plan**  
 sheet number

**LP-1**  
**AS BUILT**  
 03/07/2016