

PLANT AND MATERIALS LIST: NOTE: CONTRACTOR TO VERIFY QUANTITIES PER PLANS

CANOPY TREES

| QNTY. | SYMBOL | COMMON NAME | BOTANIC NAME |
|-------|--------|------------------|---------------------|
| | CP | CHINESE PISTACHE | PISTACHIA CHINENSIS |

SHRUBS

| QNTY. | SYMBOL | COMMON NAME | BOTANIC NAME |
|-------|--------|-----------------------|-----------------------------|
| | CH | CARISSA HOLLY | ILEX CORNUTA 'CARISSA' |
| | IH | INDIAN HAWTHORN | RHAPHIOLEPIS INDICA 'CLARA' |
| | MF | MEXICAN FEATHER GRASS | STIPA TENISSIMA |

TURF


| QNTY. | SYMBOL | COMMON NAME | BOTANIC NAME |
|-------|--------|-------------------------|------------------|
| | SSBG | SOLID SOD BERMUDA GRASS | Cynodon dactylon |

EXISTING TREE

| QNTY. | SYMBOL | NOTE |
|-------|----------|---|
| | PER PLAN | REFERENCE CIVIL DEMO PLANS FOR TREE PRESERVATION. |



sheet location

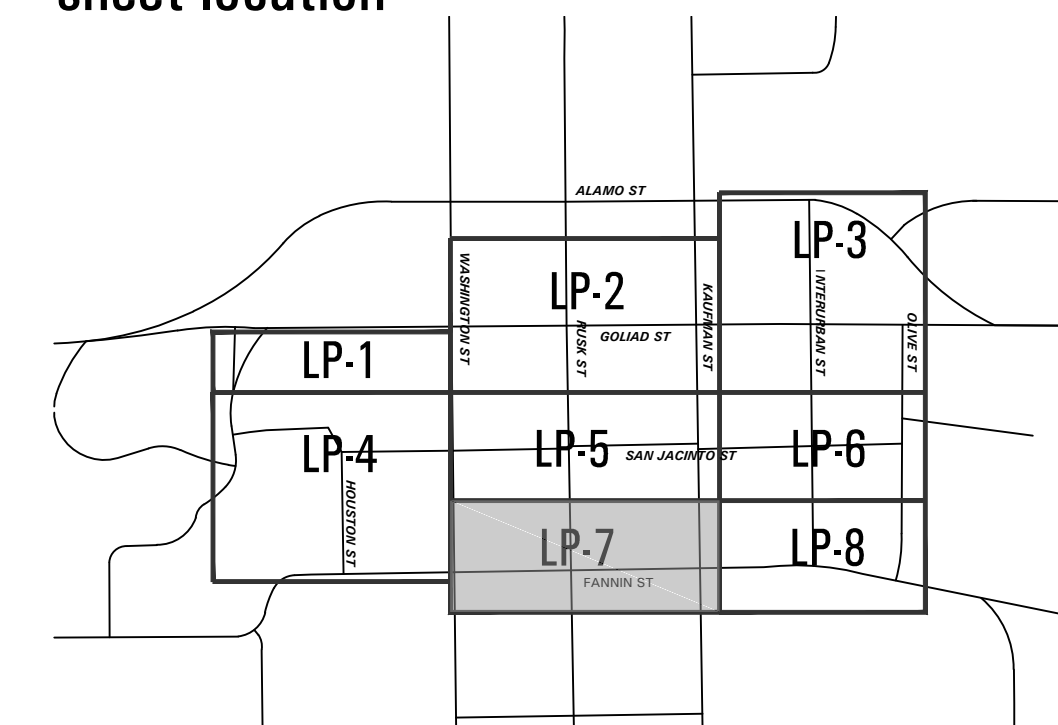

submittals / revisions

| no. | date | detail |
|-----|----------|----------|
| △ | 04/06/15 | RFI #171 |
| △ | 09/17/15 | LASI #22 |

la terra studio, inc.
 12024
 lts project number
 02.26.2014
 date
 rac; bhm
 drawn by
 mtb
 checked by

