


PLANT AND MATERIALS LIST: NOTE: CONTRACTOR TO VERIFY QUANTITIES PER PLANS

EXISTING TREE

QNTY.	SYMBOL	NOTE
		PER PLAN REFERENCE CIVIL DEMO PLANS FOR TREE PRESERVATION.

sheet location

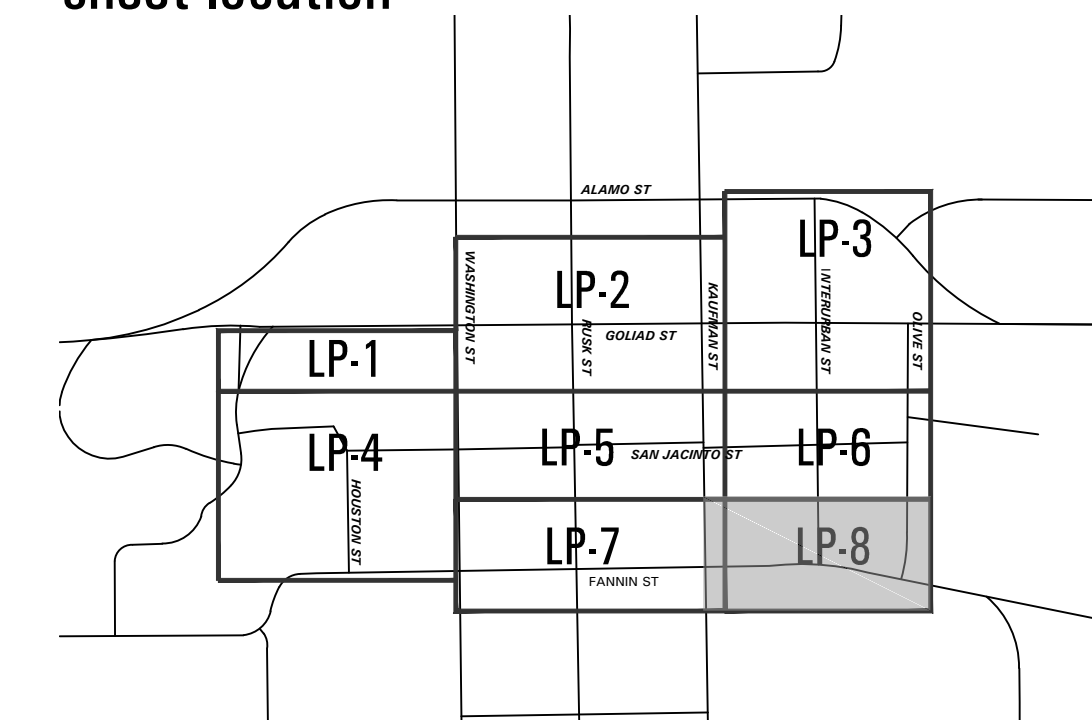

submittals / revisions

no.	date	detail

la terra studio, inc.

12024
 Its project number
 02.26.2014
 date
 rac; bhm
 drawn by
 mtb
 checked by

registration



02.26.2014
 sheet title

Landscape Plan
 sheet number

LP-8
AS BUILT
 03/07/2016