



submittals / revisions

no.	date	detail

la terra studio, inc.

12024
its project number
02.26.2014
date
rac; bhm
drawn by
mtb
checked by



02.26.2014
sheet title
Site Preparation Plan
sheet number


PP-4

AS BUILT
03/07/2016


~ MATCH LINE-SHEET PP-1 ~

~ MATCH LINE-SHEET PP-5 ~


~ MATCH LINE-SHEET PP-7 ~

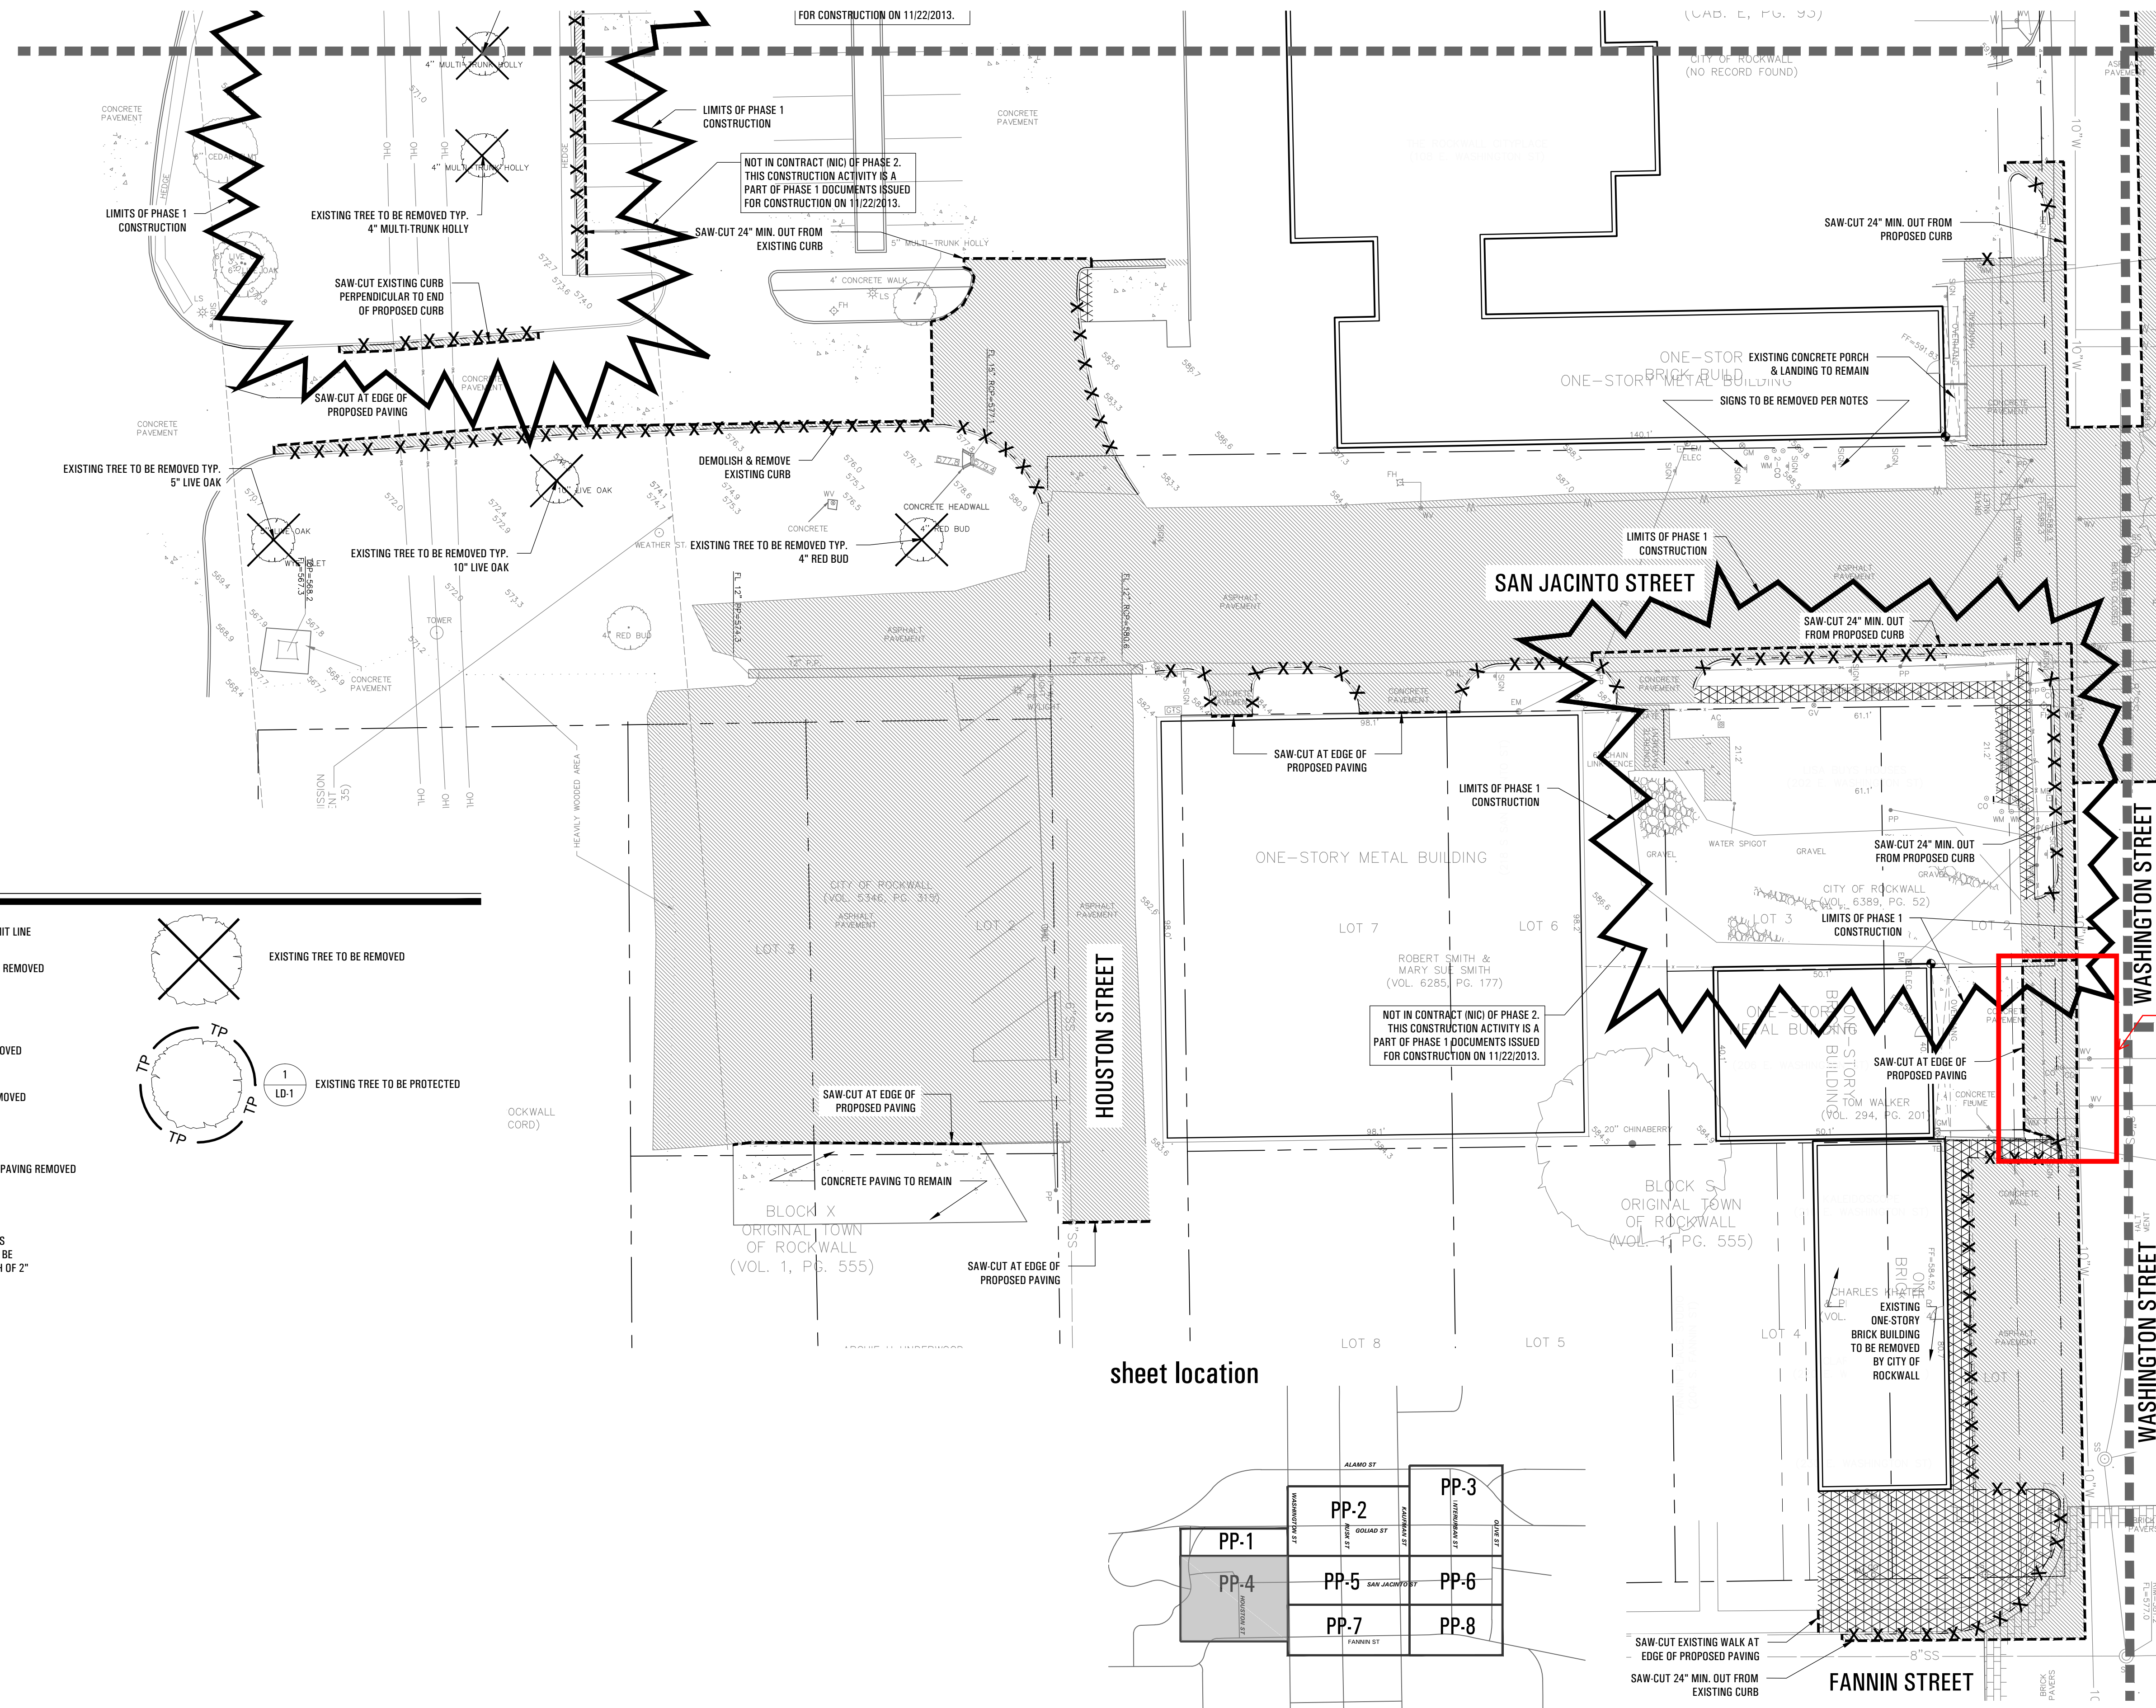

DEMOLITION LEGEND:

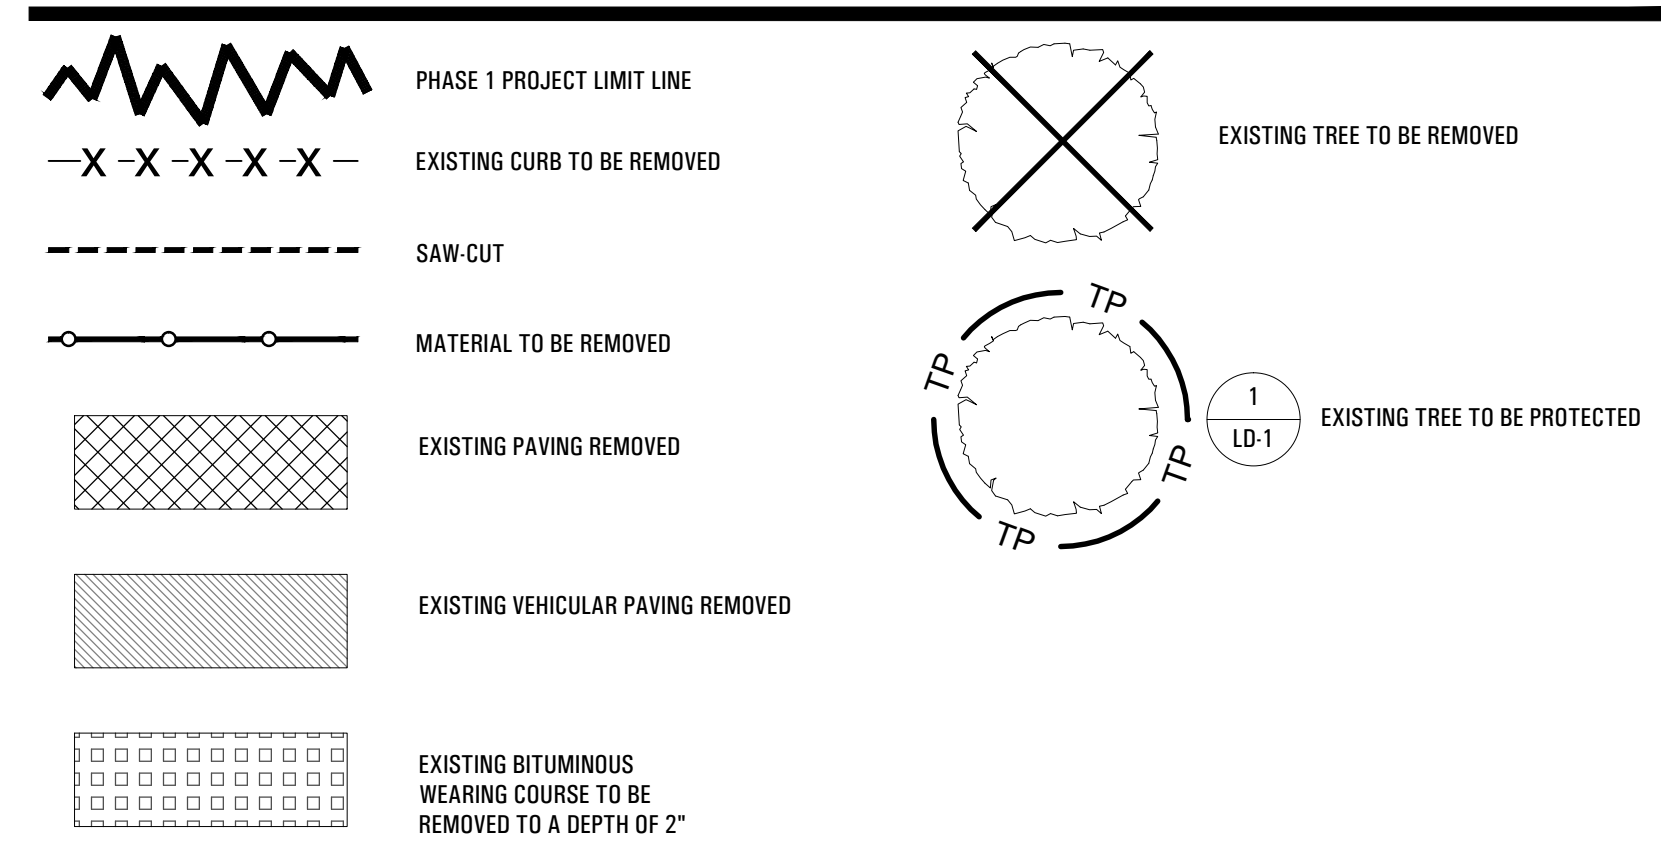

sheet location

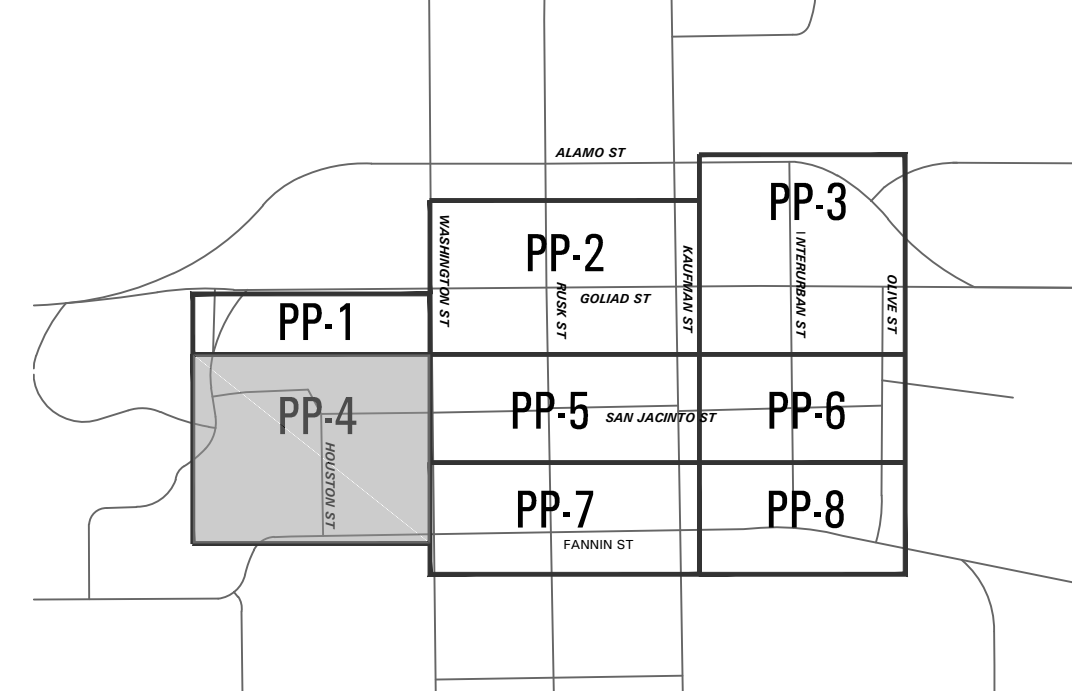

Call 1.800.DIG-TESS
www.digtess.org **Dig Safely**
SHEET NOTES
2 Working Days BEFORE You Dig!
811
Know what's below. Call before you dig.

