



NOT IN CONTRACT (NIC) OF PHASE 2. THIS CONSTRUCTION ACTIVITY IS A PART OF PHASE 1 DOCUMENTS ISSUED FOR CONSTRUCTION ON 11/22/2013.

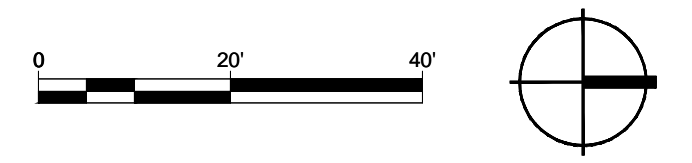

DEMOLITION LEGEND:

- PHASE 1 PROJECT LIMIT LINE
- EXISTING CURB TO BE REMOVED
- SAW-CUT
- MATERIAL TO BE REMOVED
- EXISTING PAVING REMOVED
- EXISTING VEHICULAR PAVING REMOVED
- EXISTING BITUMINOUS WEARING COURSE TO BE REMOVED TO A DEPTH OF 2"
- EXISTING TREE TO BE REMOVED
- EXISTING TREE TO BE PROTECTED

sheet location

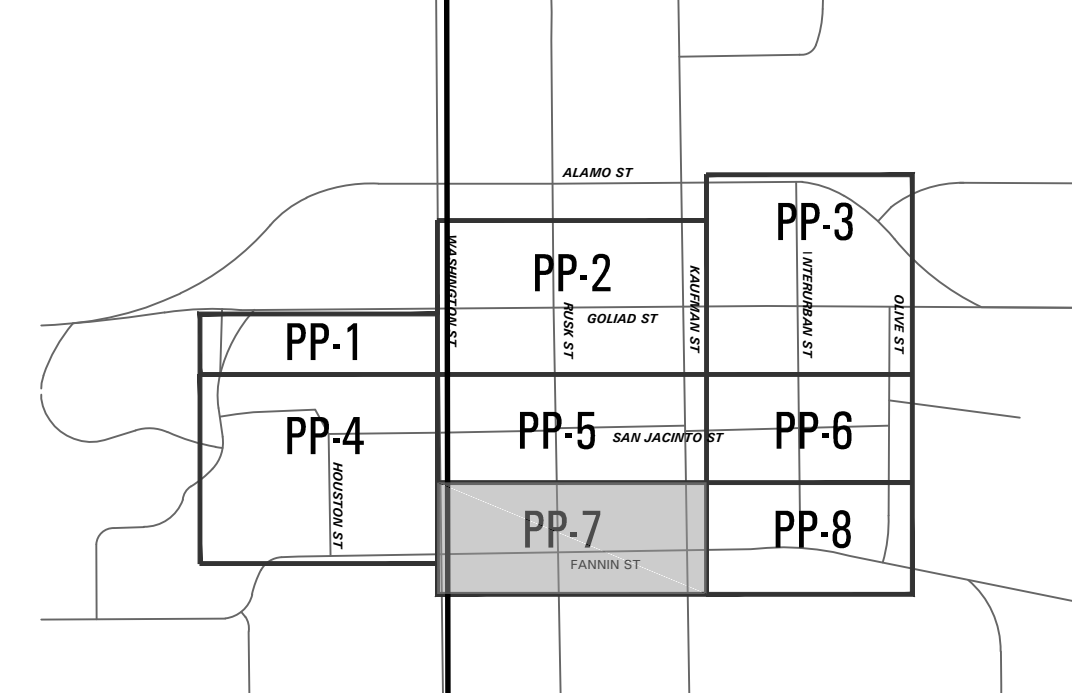

Call 1.800.DIG-TESS 2 Working Days BEFORE You Dig!
 www.digtess.org **Dig Safely**
 SHEET NOTES Know what's below. Call before you dig.

submittals / revisions

no.	date	detail
▲	05/16/14	RFI #44
▲	07/14/14	RFI #94

la terra studio, inc.
 12024
 Its project number
 02.26.2014
 date
 rac; bhm
 drawn by
 mtb
 checked by



02.26.2014
 sheet title
Site Preparation Plan
 sheet number

PP-7
AS BUILT
 03/07/2016