




1 TWO STEP STAIR
SCALE: 1" = 1'-0"

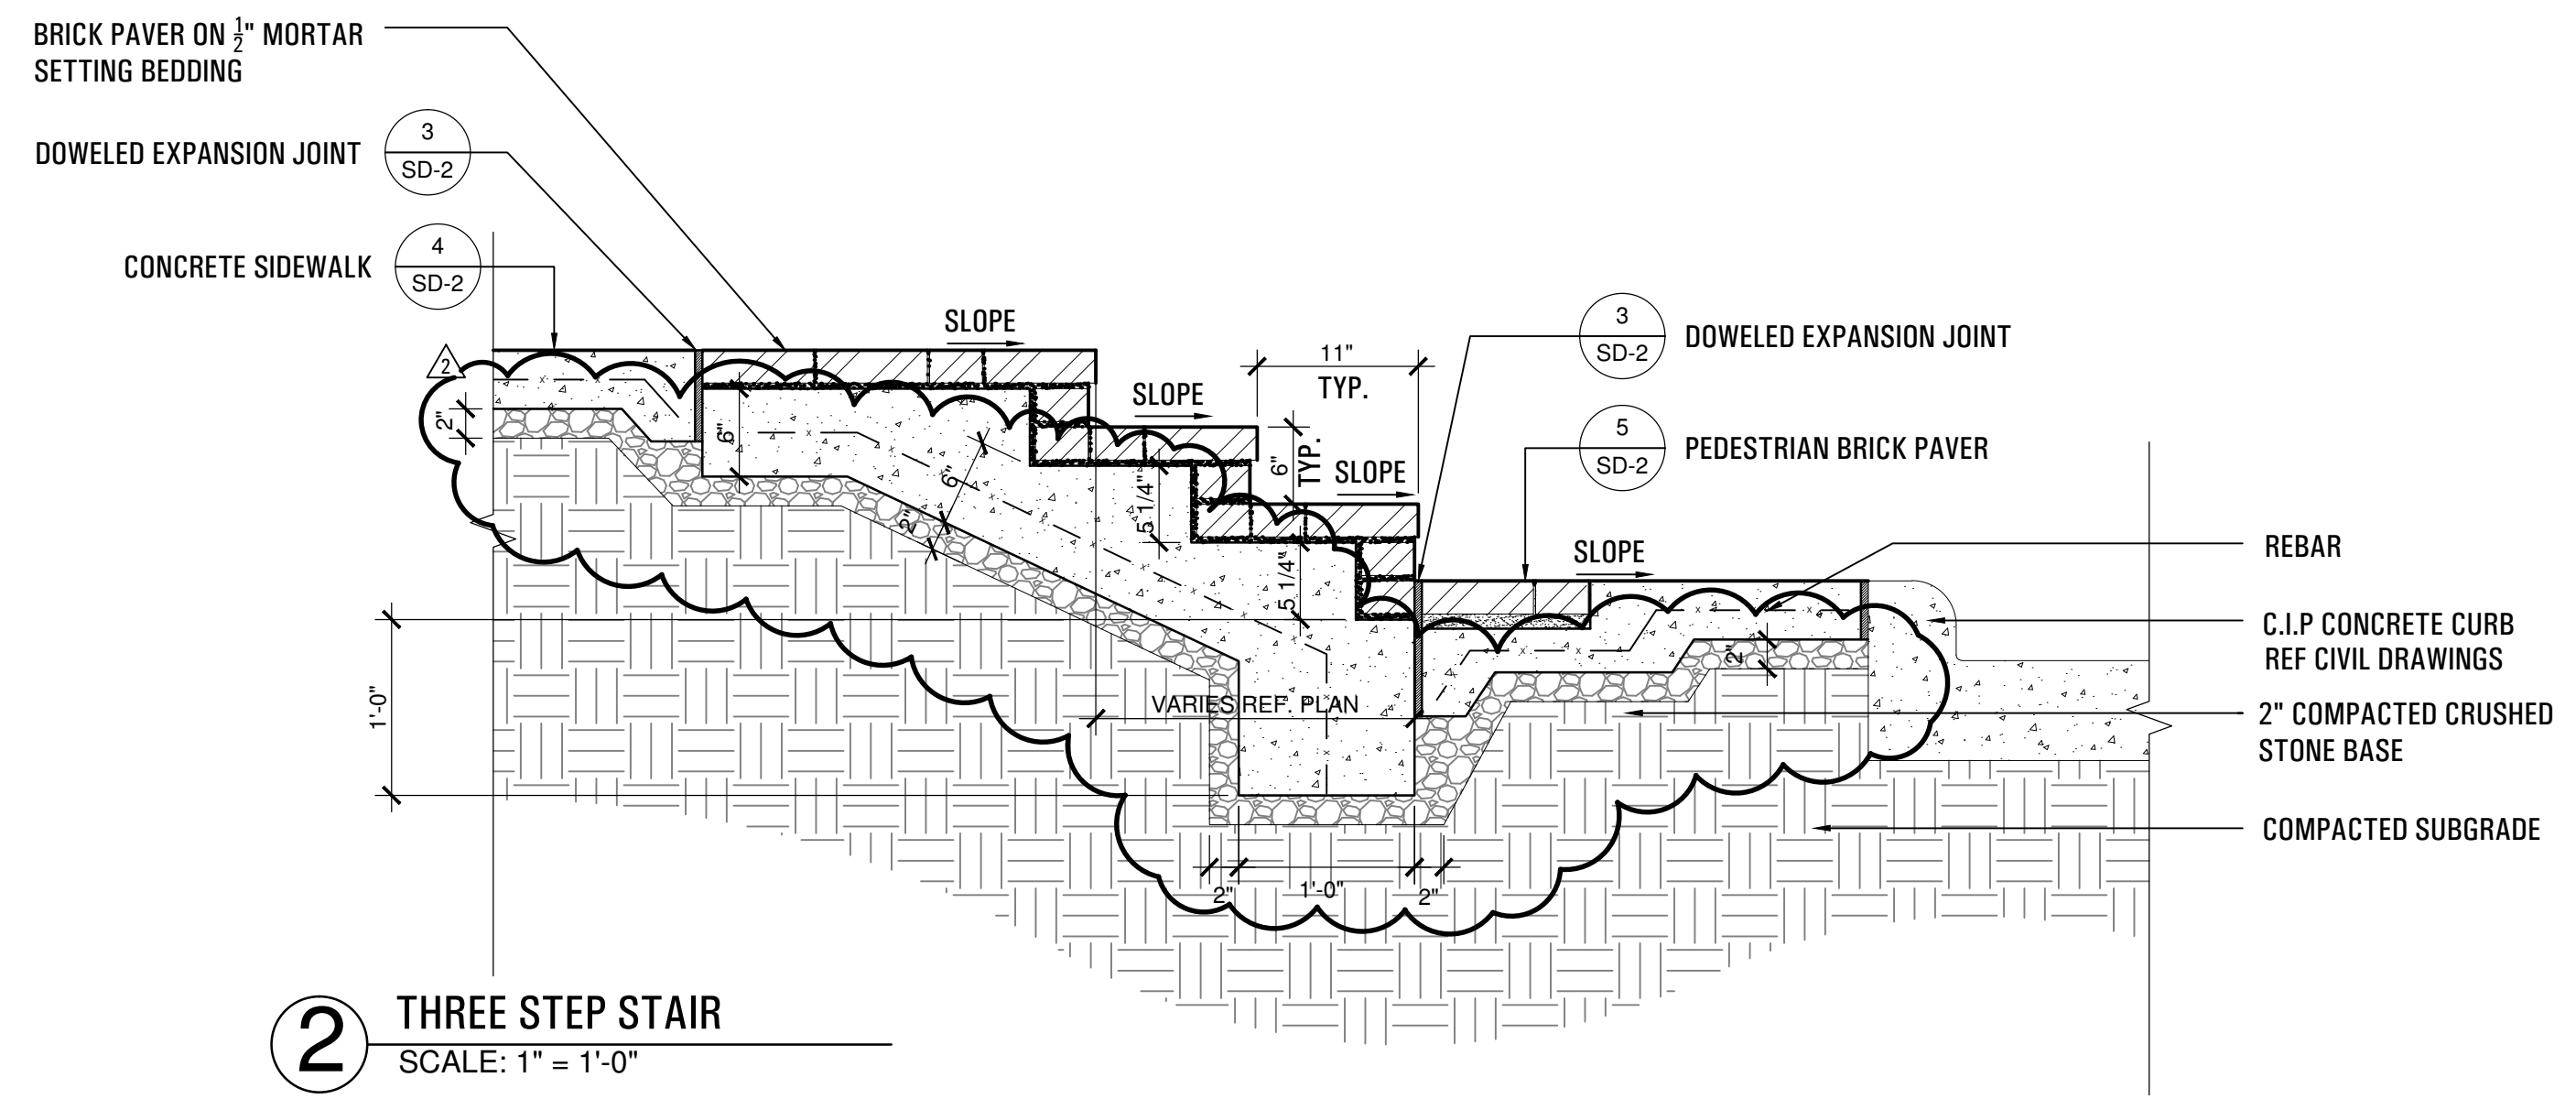

2 THREE STEP STAIR
SCALE: 1" = 1'-0"

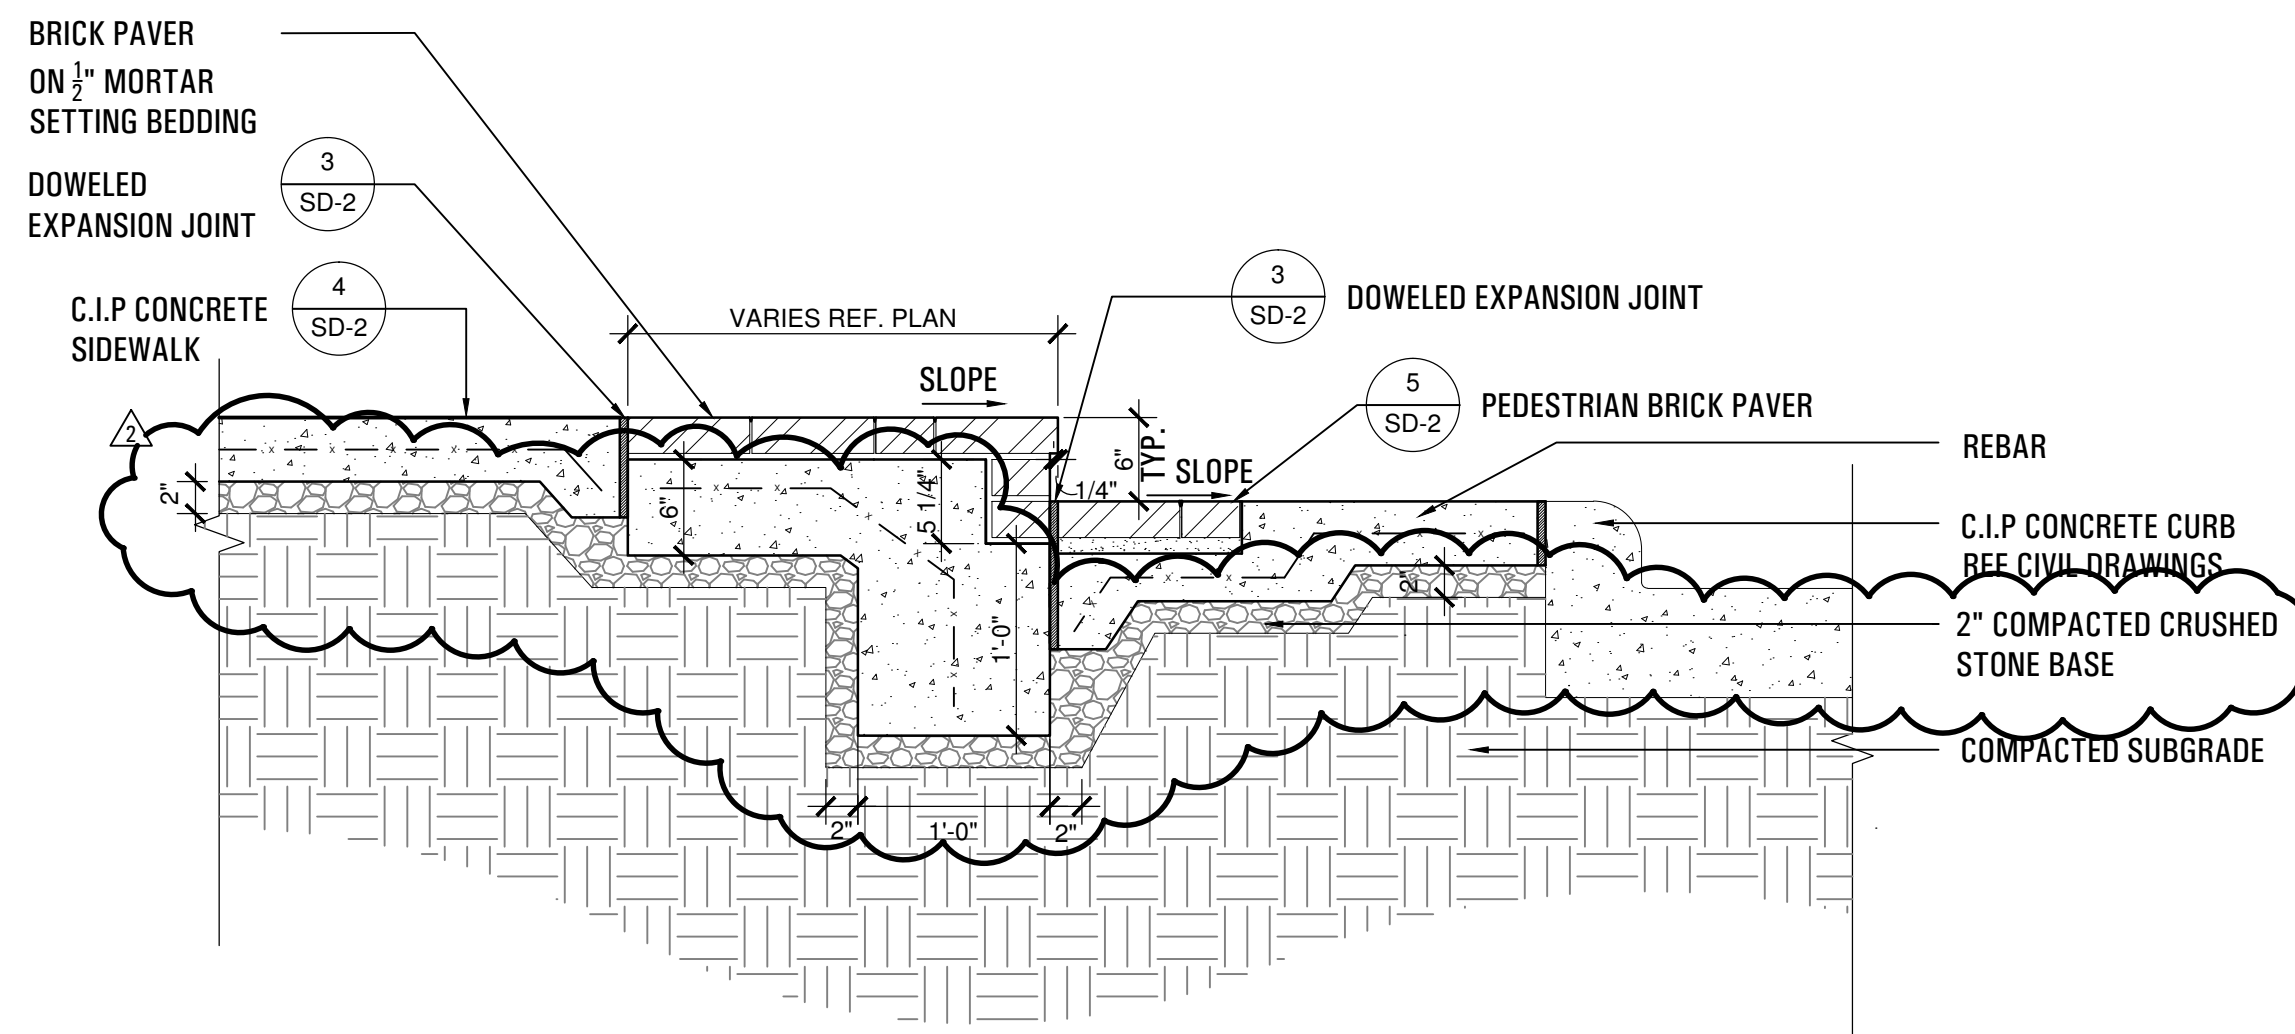


3 ONE STEP STAIR
SCALE: 1" = 1'-0"

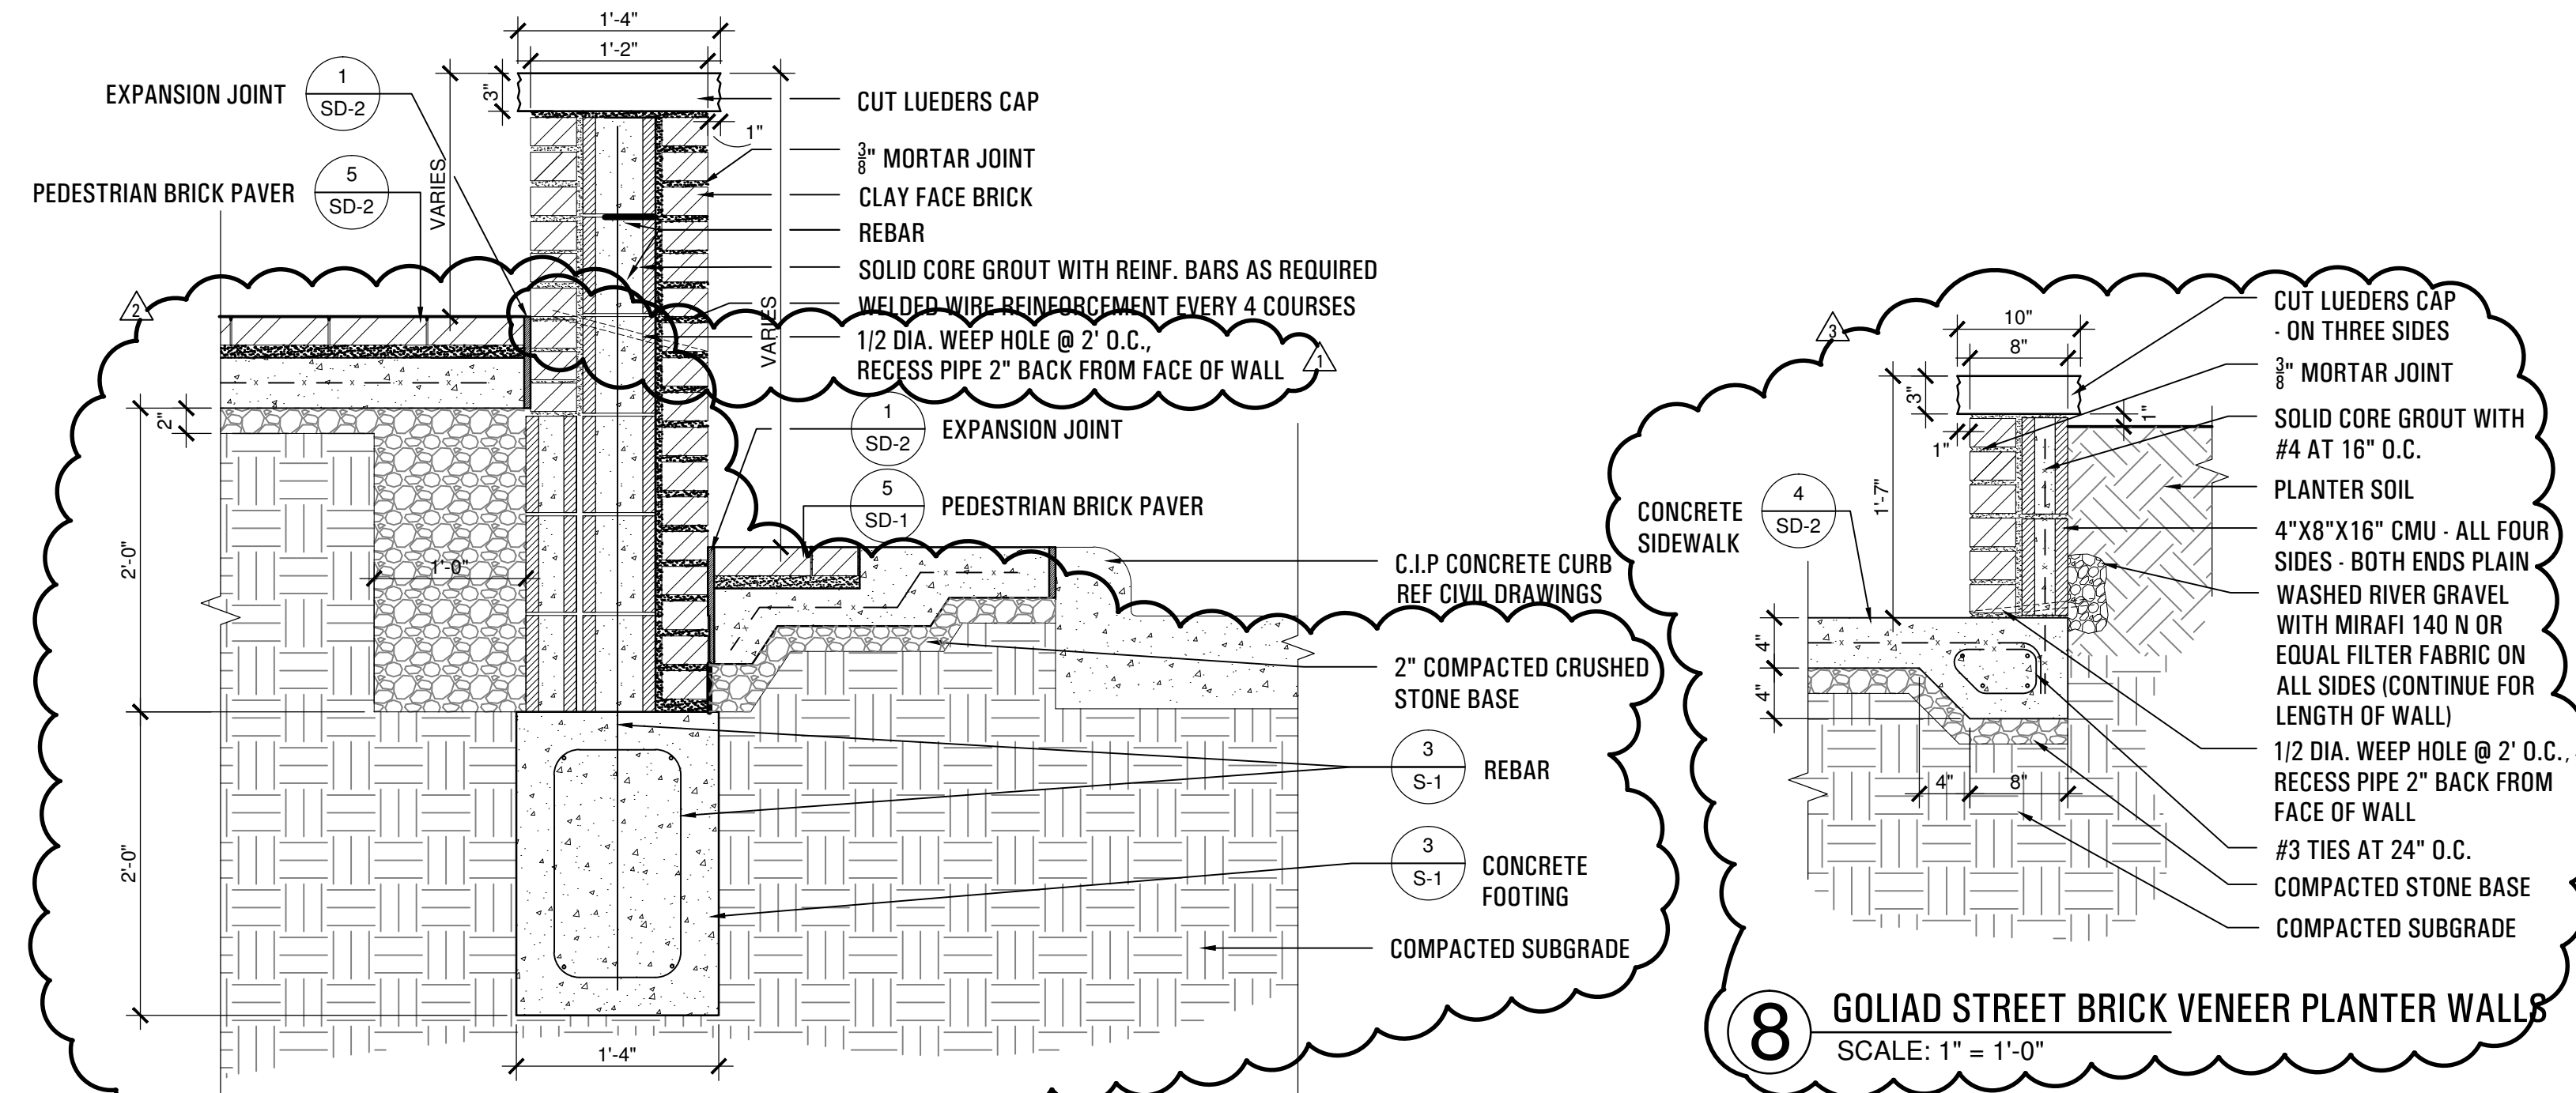


4 BRICK VENEER WALL
SCALE: 1" = 1'-0"


8 GOLIAD STREET BRICK VENEER PLANTER WALLS
SCALE: 1" = 1'-0"

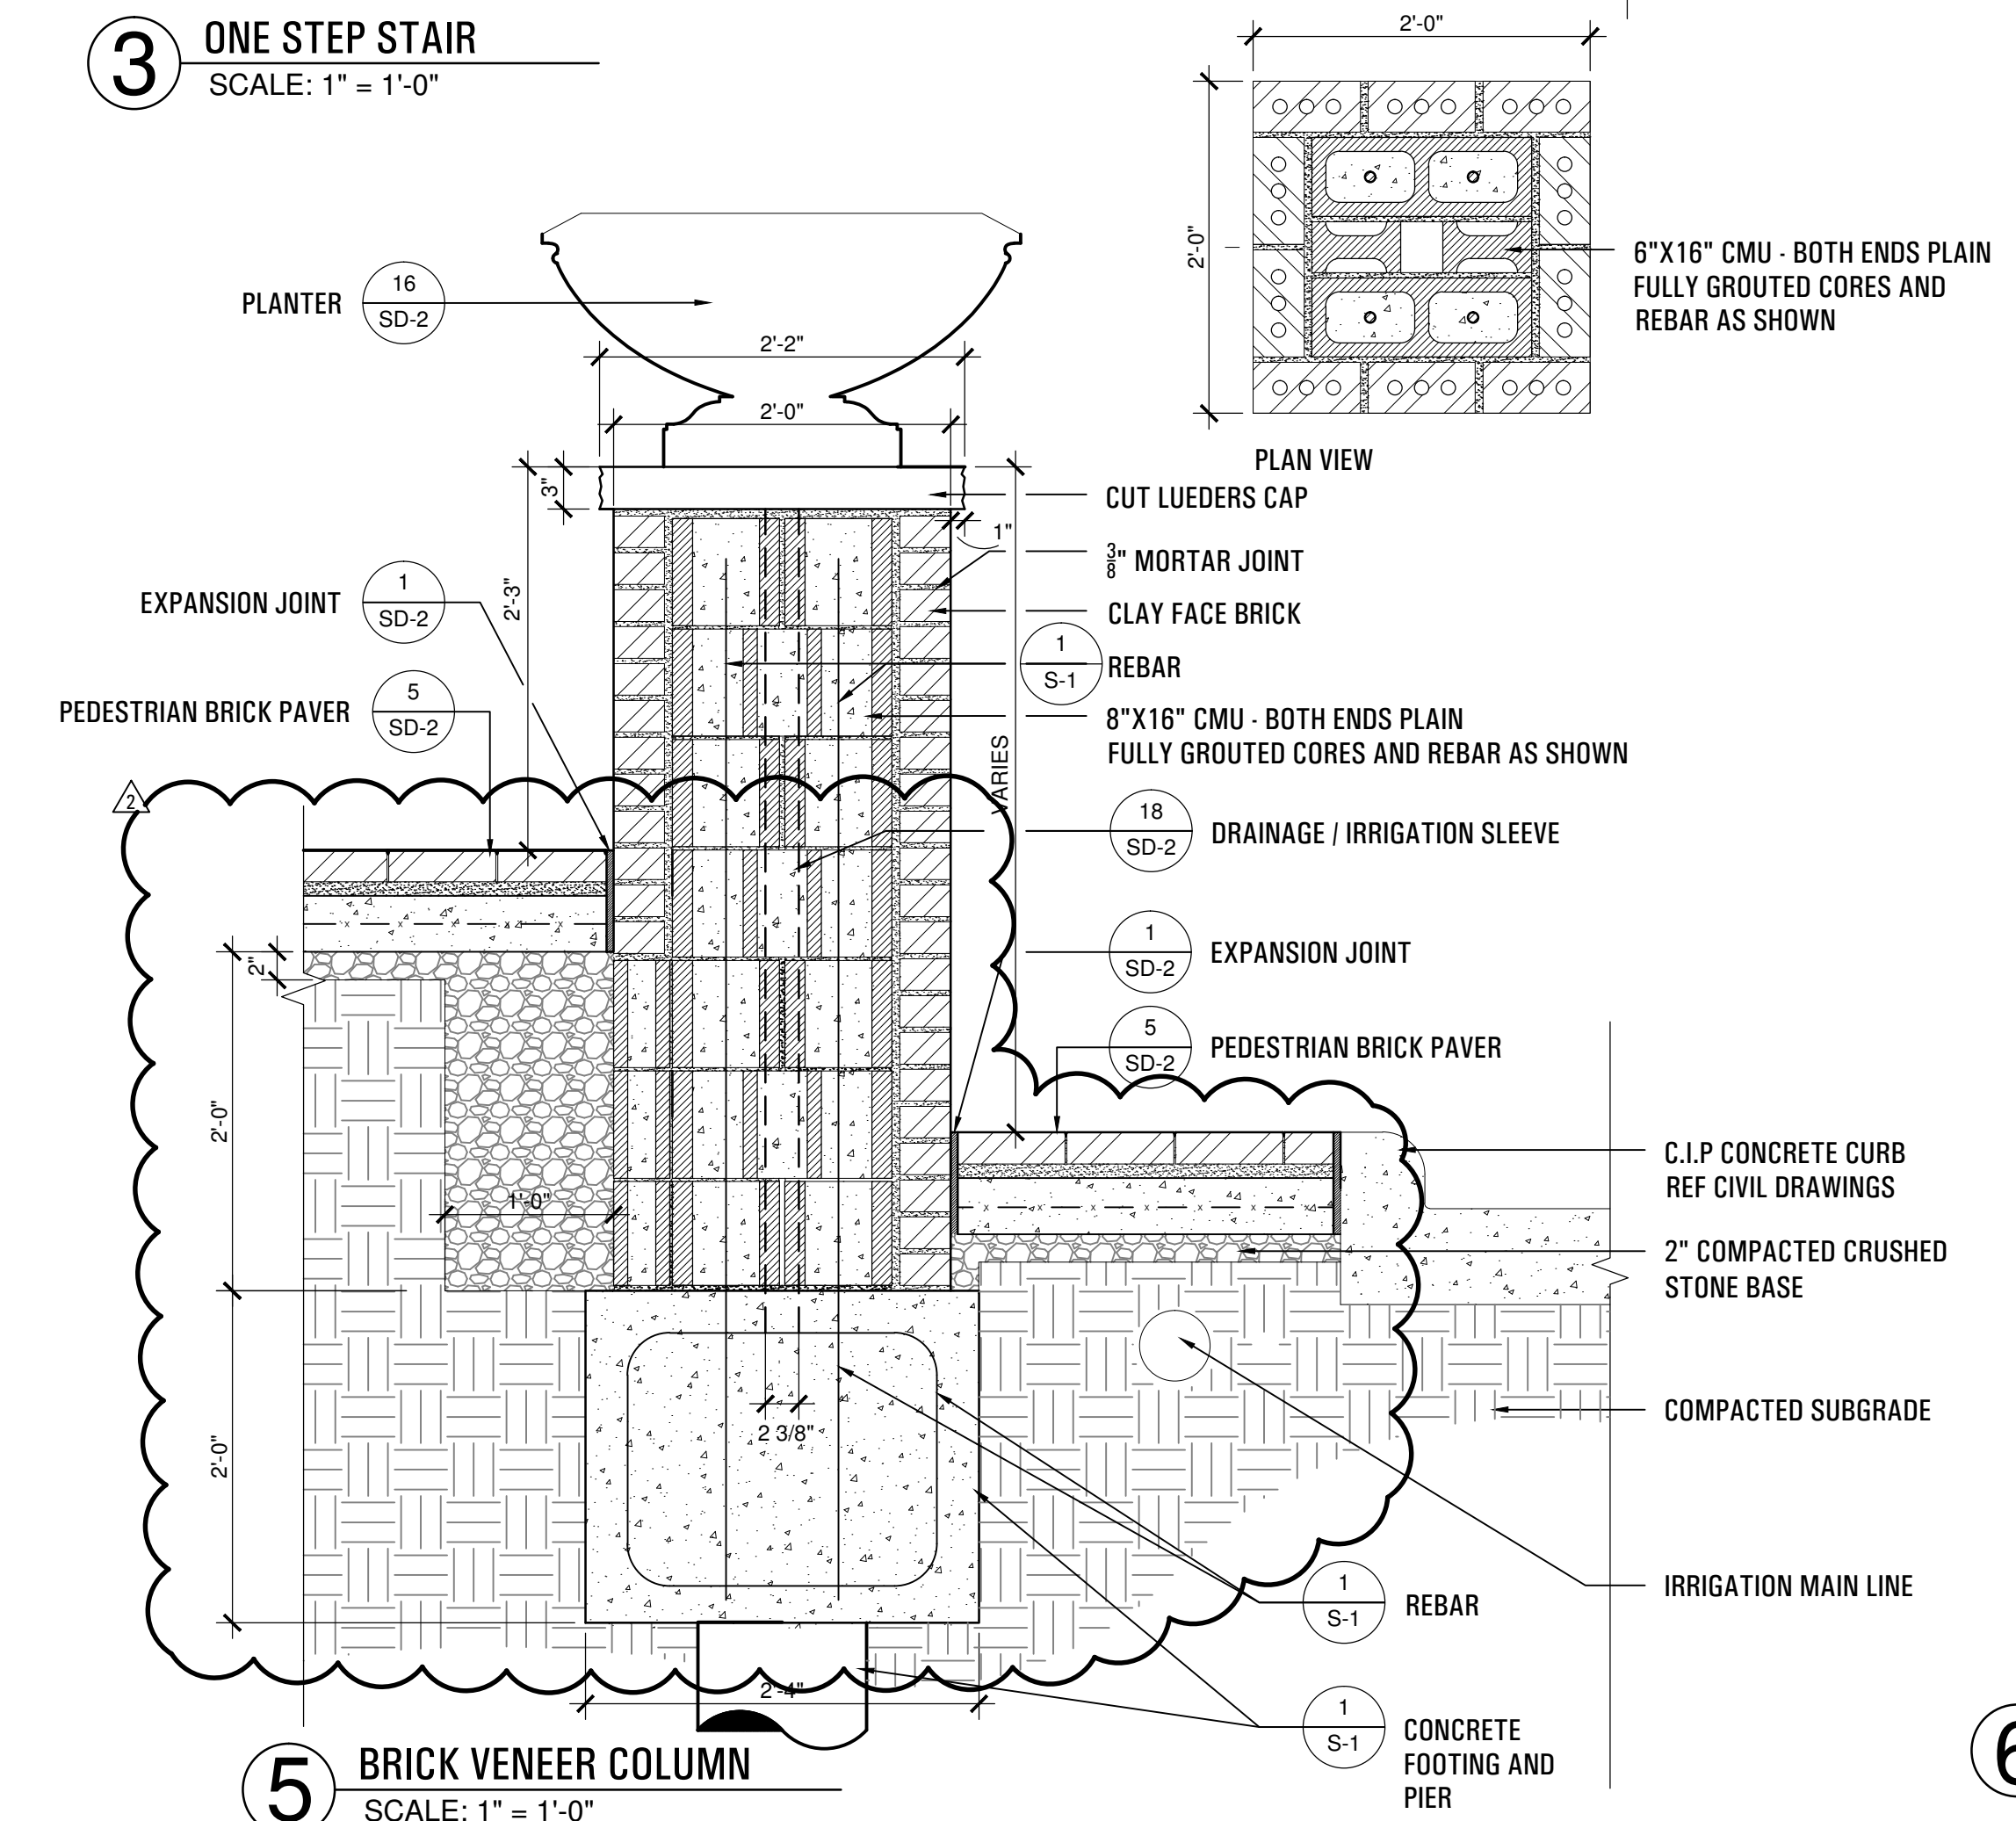

5 BRICK VENEER COLUMN
SCALE: 1" = 1'-0"

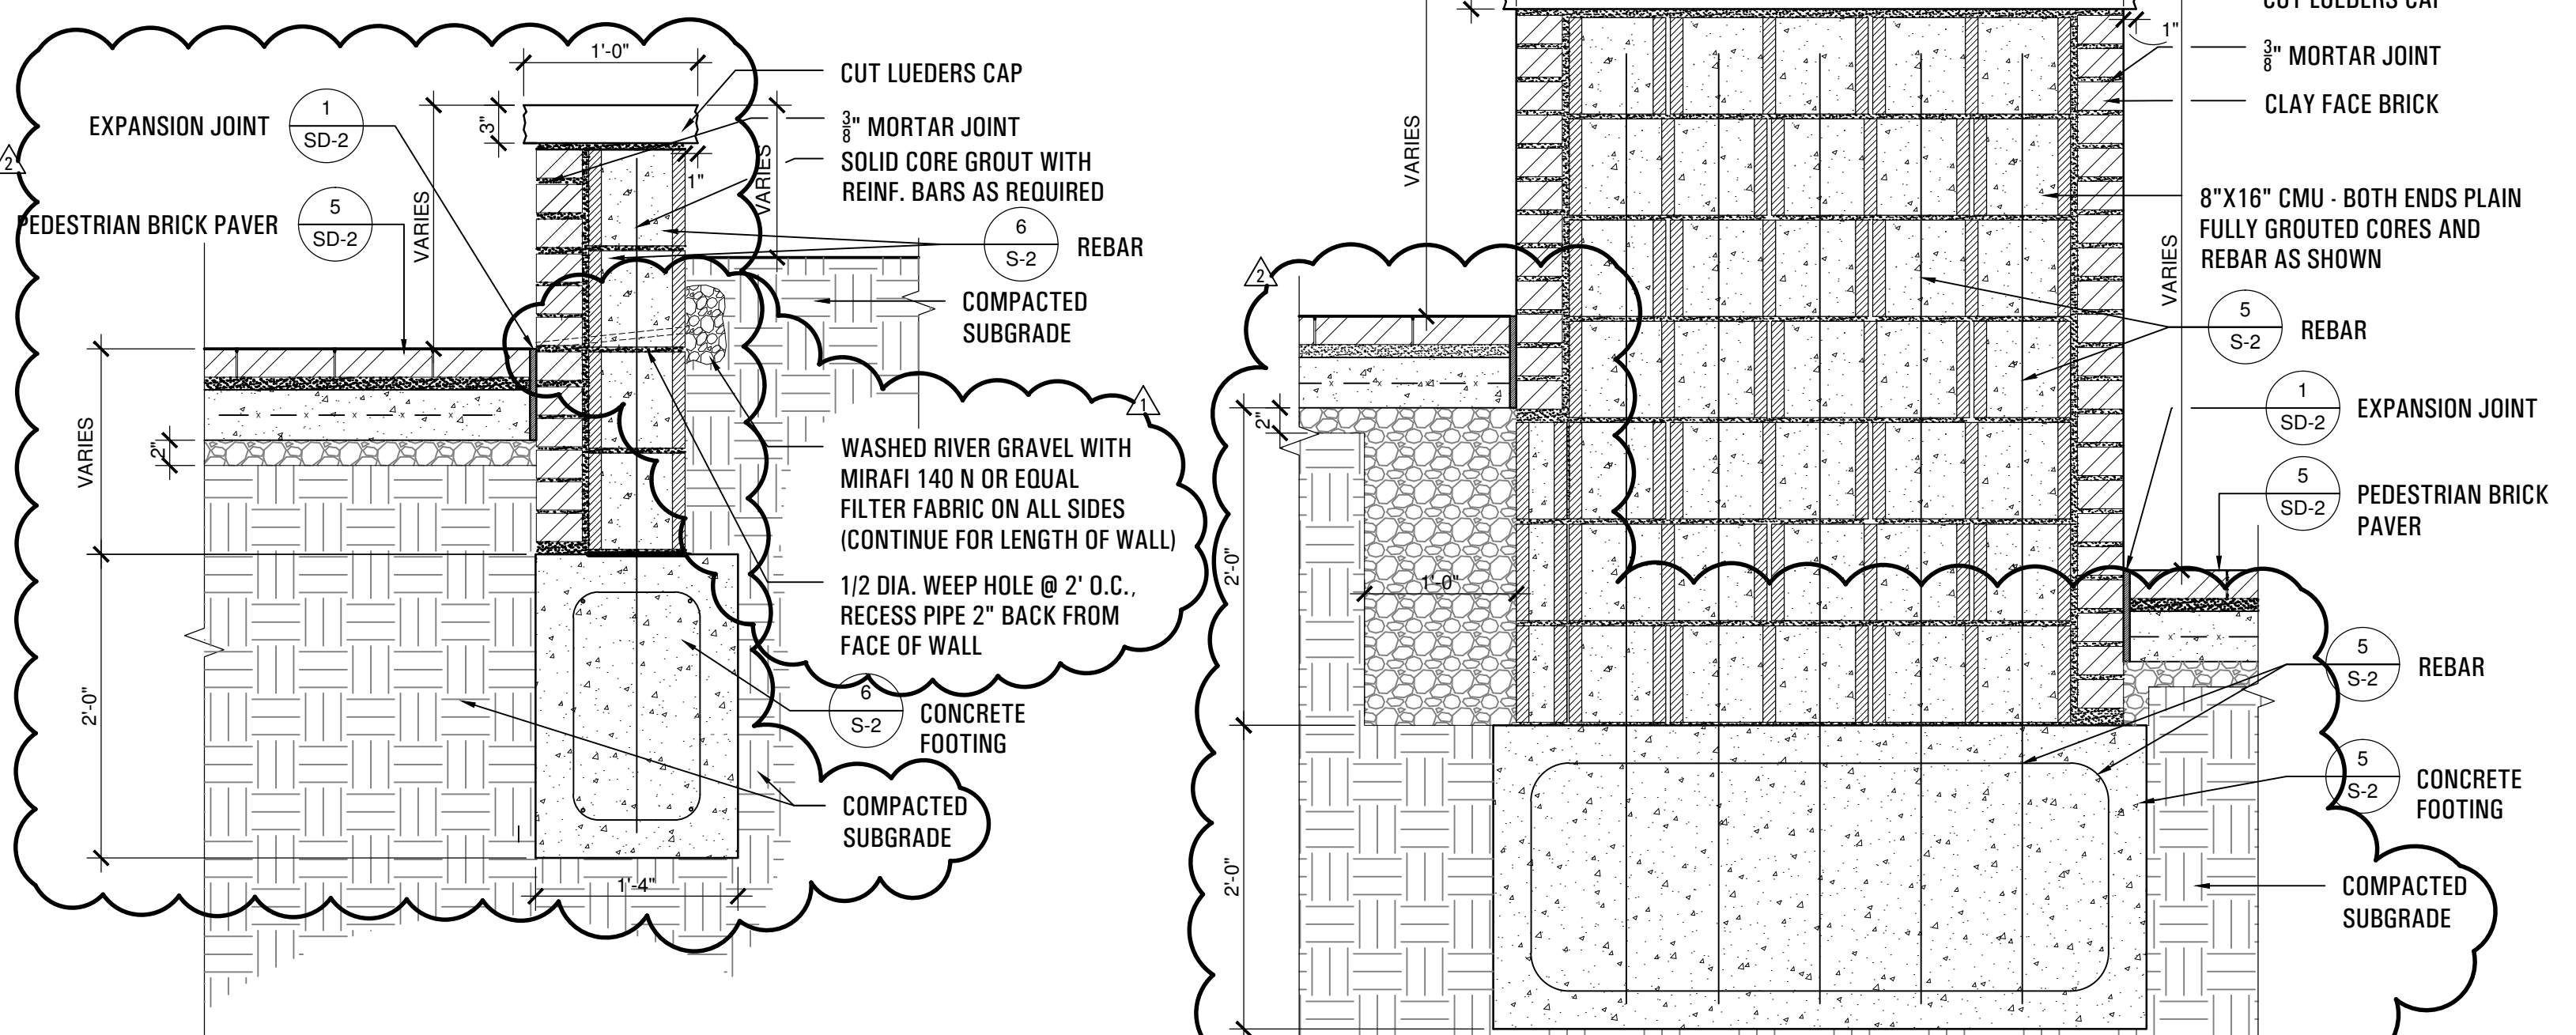

6 BRICK VENEER PLANTER WALL
SCALE: 1" = 1'-0"

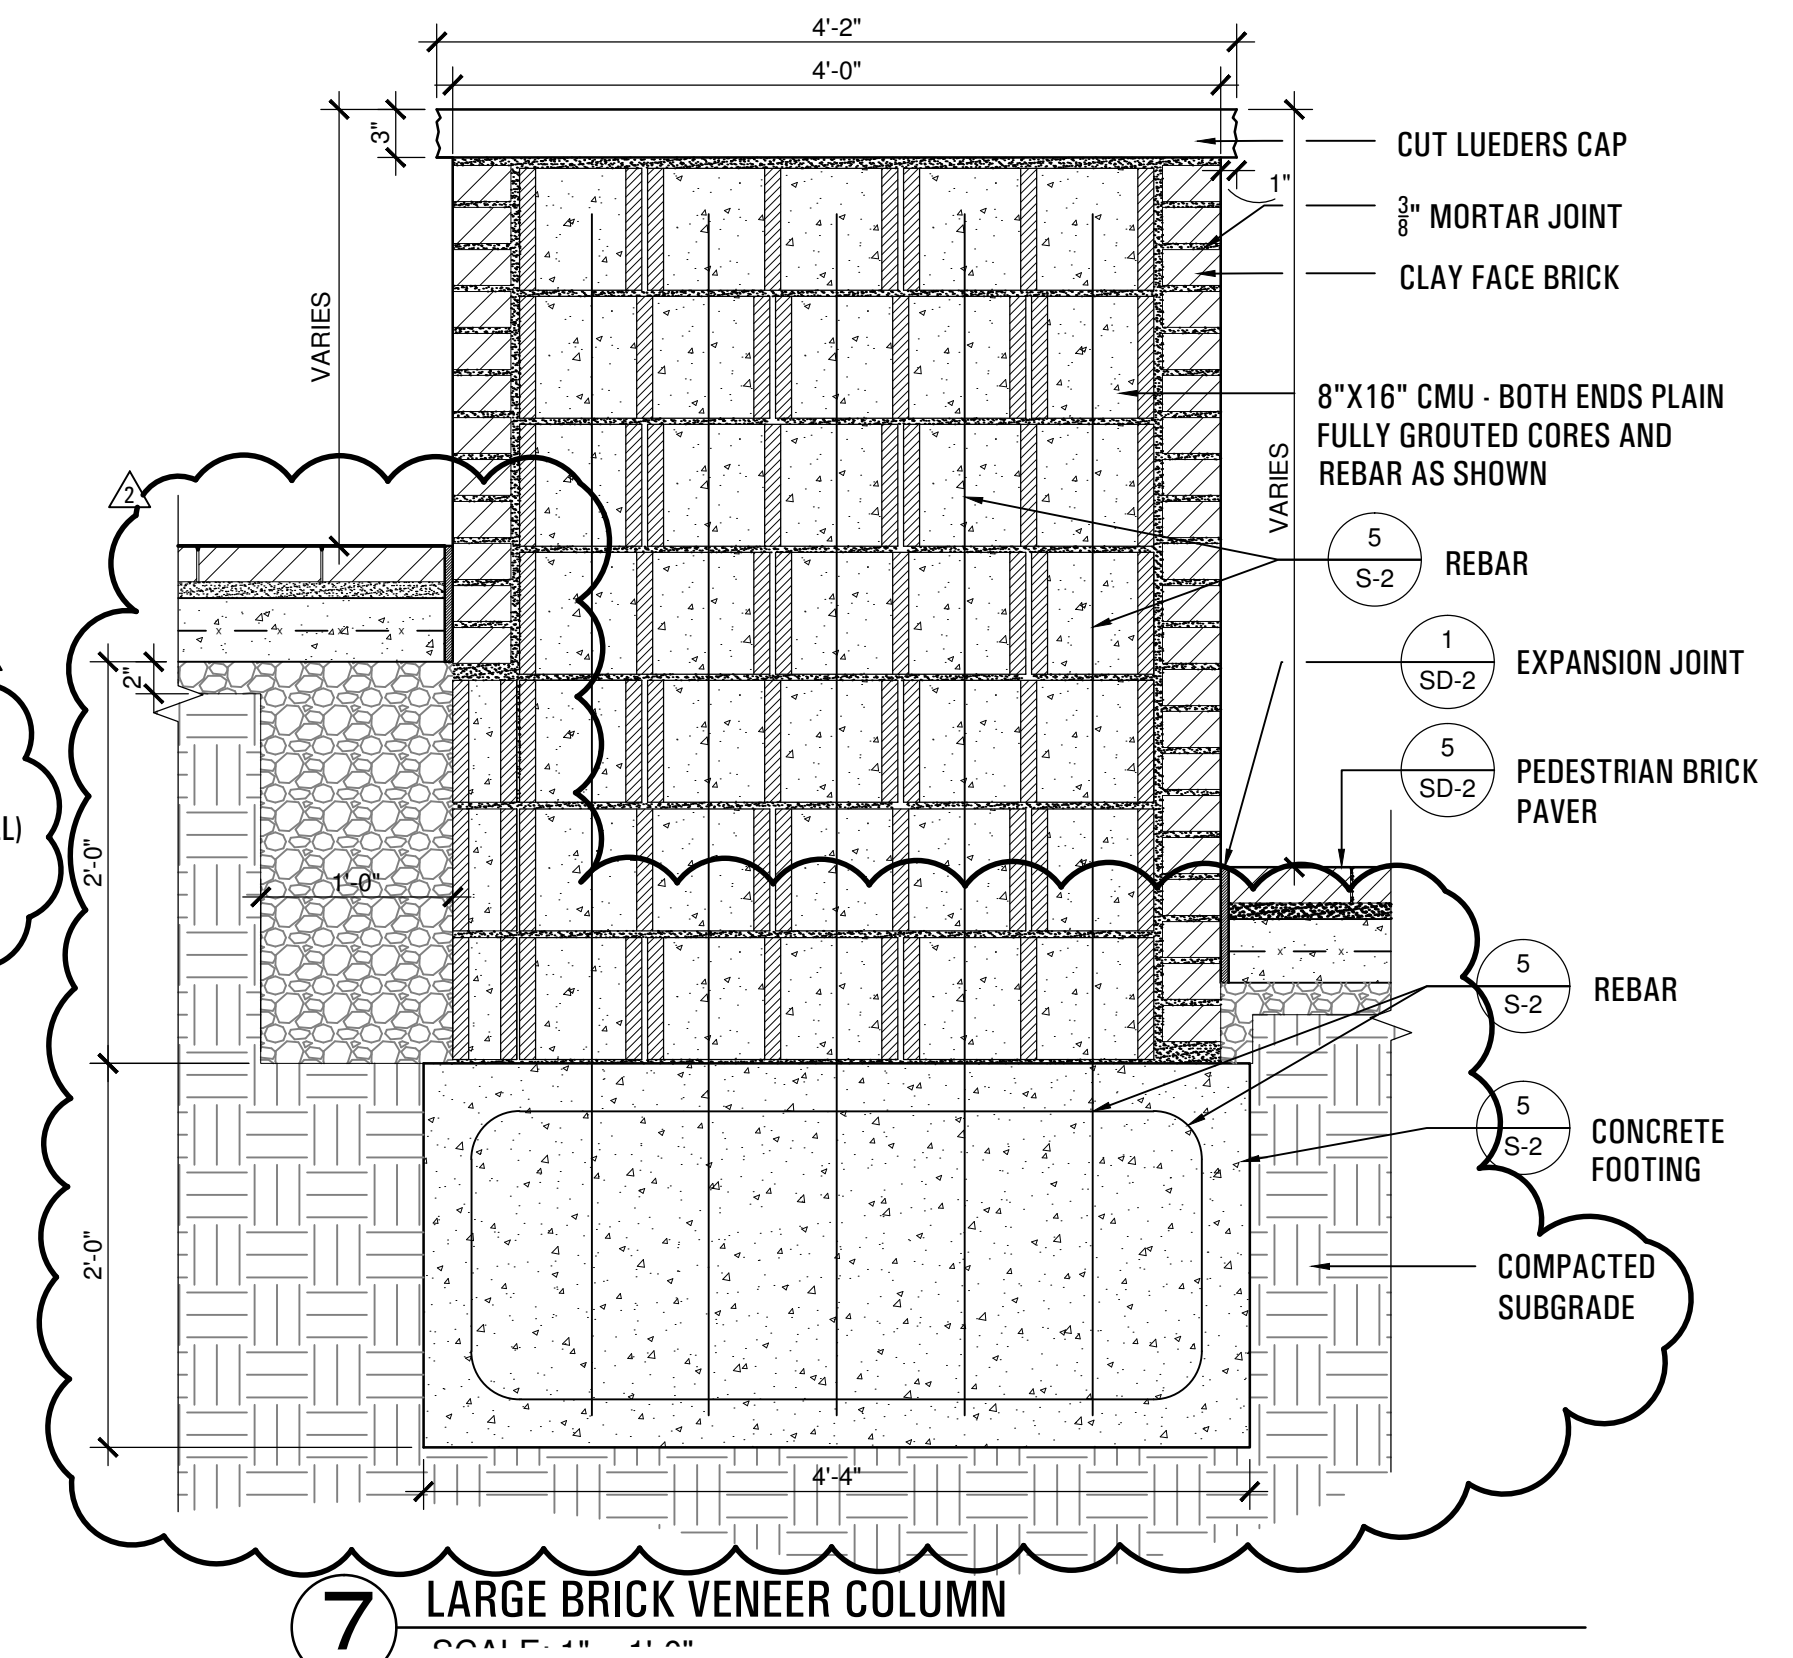

7 LARGE BRICK VENEER COLUMN
SCALE: 1" = 1'-0"



submittals / revisions

no.	date	detail
▲	03/20/14	RFI #4
▲	04/10/14	RFI #53
▲	07/14/14	RFI #100

la terra studio, inc.
12024
its project number
02.26.2014
date
rac; bhm
drawn by
mtb
checked by

