



submittals / revisions

no.	date	detail
1	4-8-14	RFI #70
2	7-3-14	RFI #103

la terra studio, inc.

12024
Its project number
4.15.2014
date
bgp
drawn by
bgp
checked by

registration





7-03-14

sheet title
FOUNDATION PLAN
sheet number

FP-1

SAN JACINTO STREET

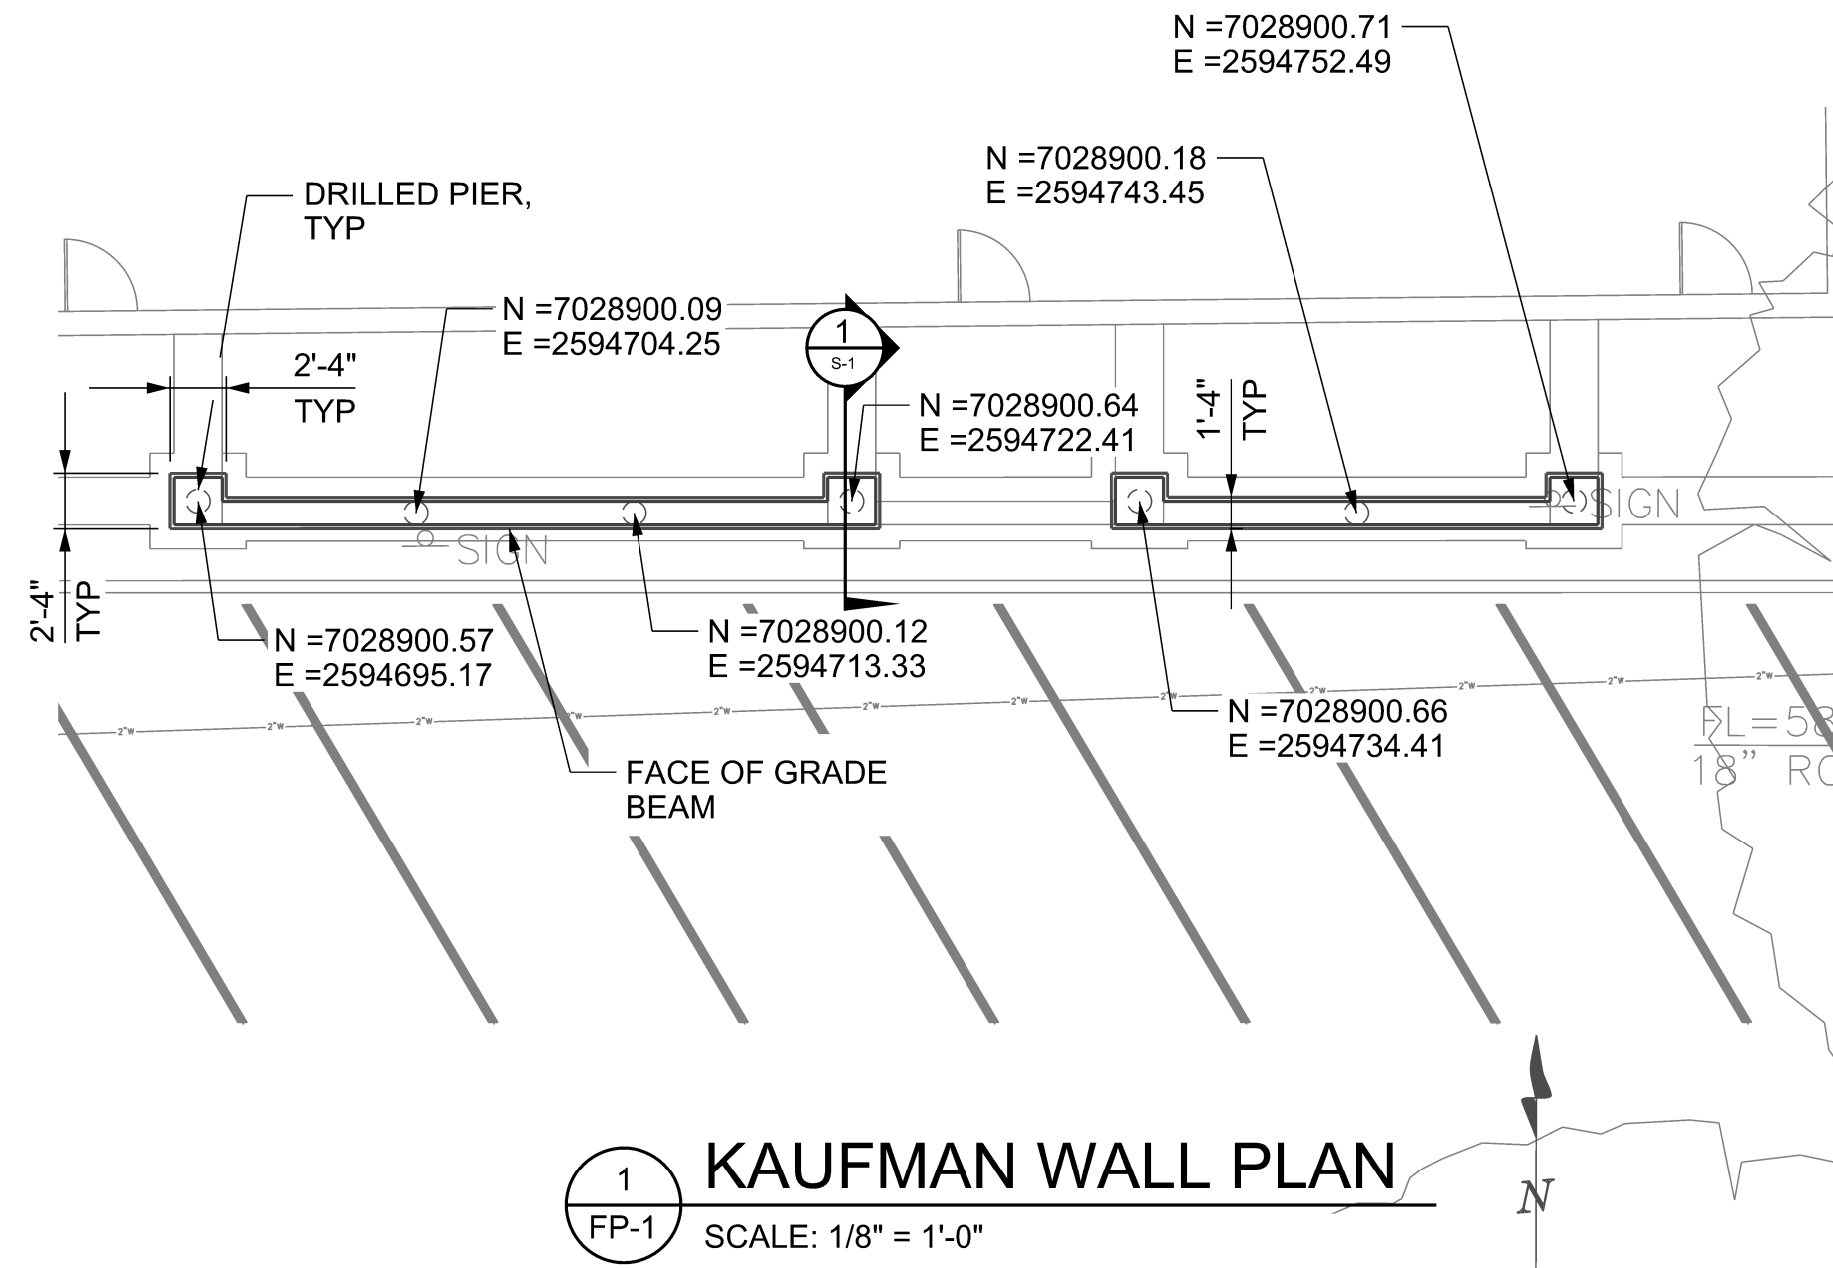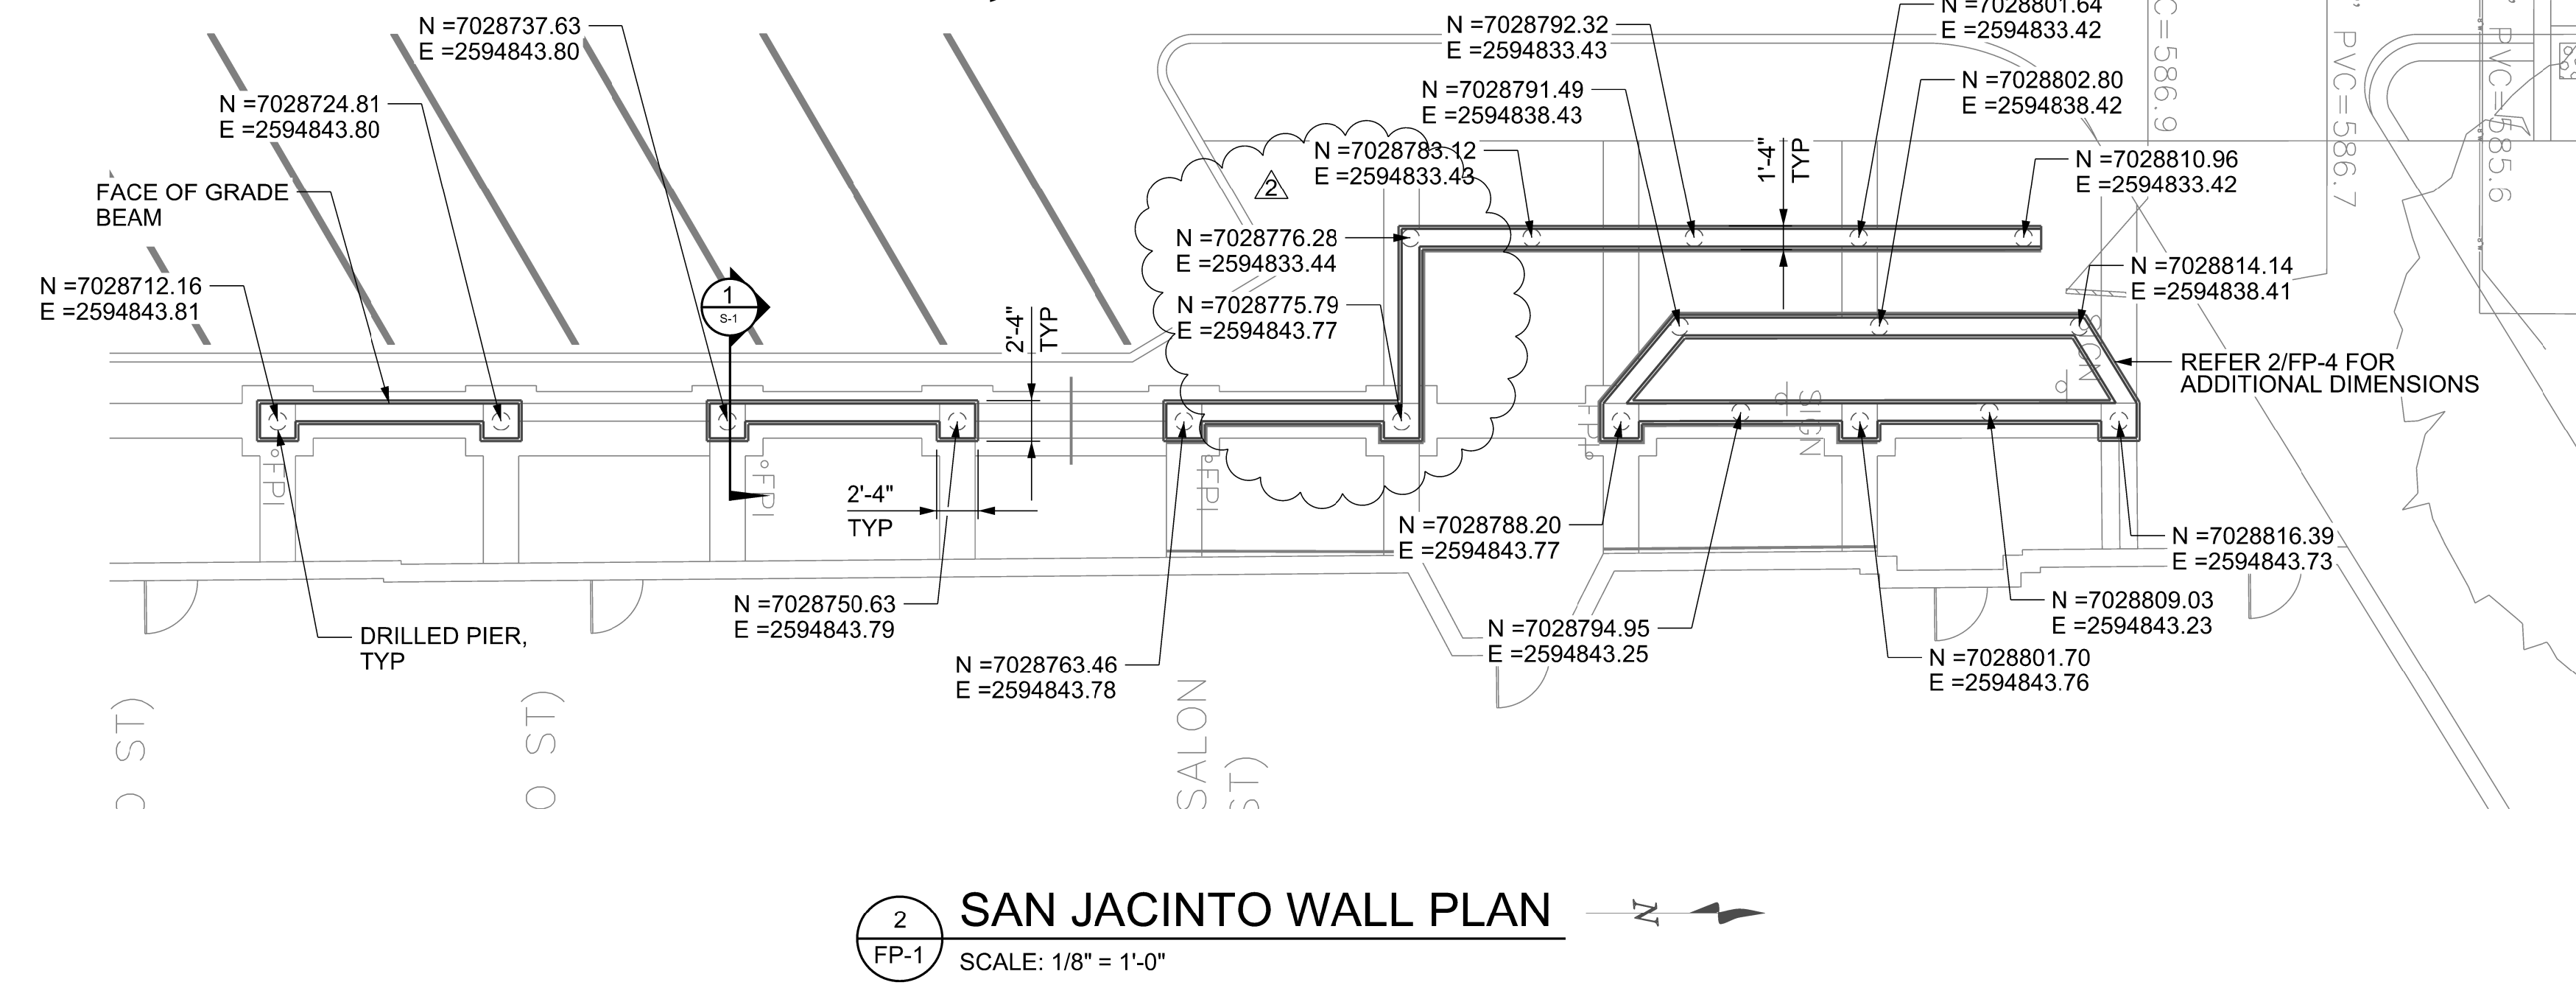

GOLIAD STREET

