



submittals / revisions

no.	date	detail
1	4-15-14	RFI #39
2	7-03-14	RFI #103

la terra studio, inc.

12024  
Its project number  
4.15.2014  
date  
bgp  
drawn by  
bgp  
checked by


registration




7-03-14  
sheet title  
**FOUNDATION PLAN**  
sheet number

**FP-2**

# RUSK STREET

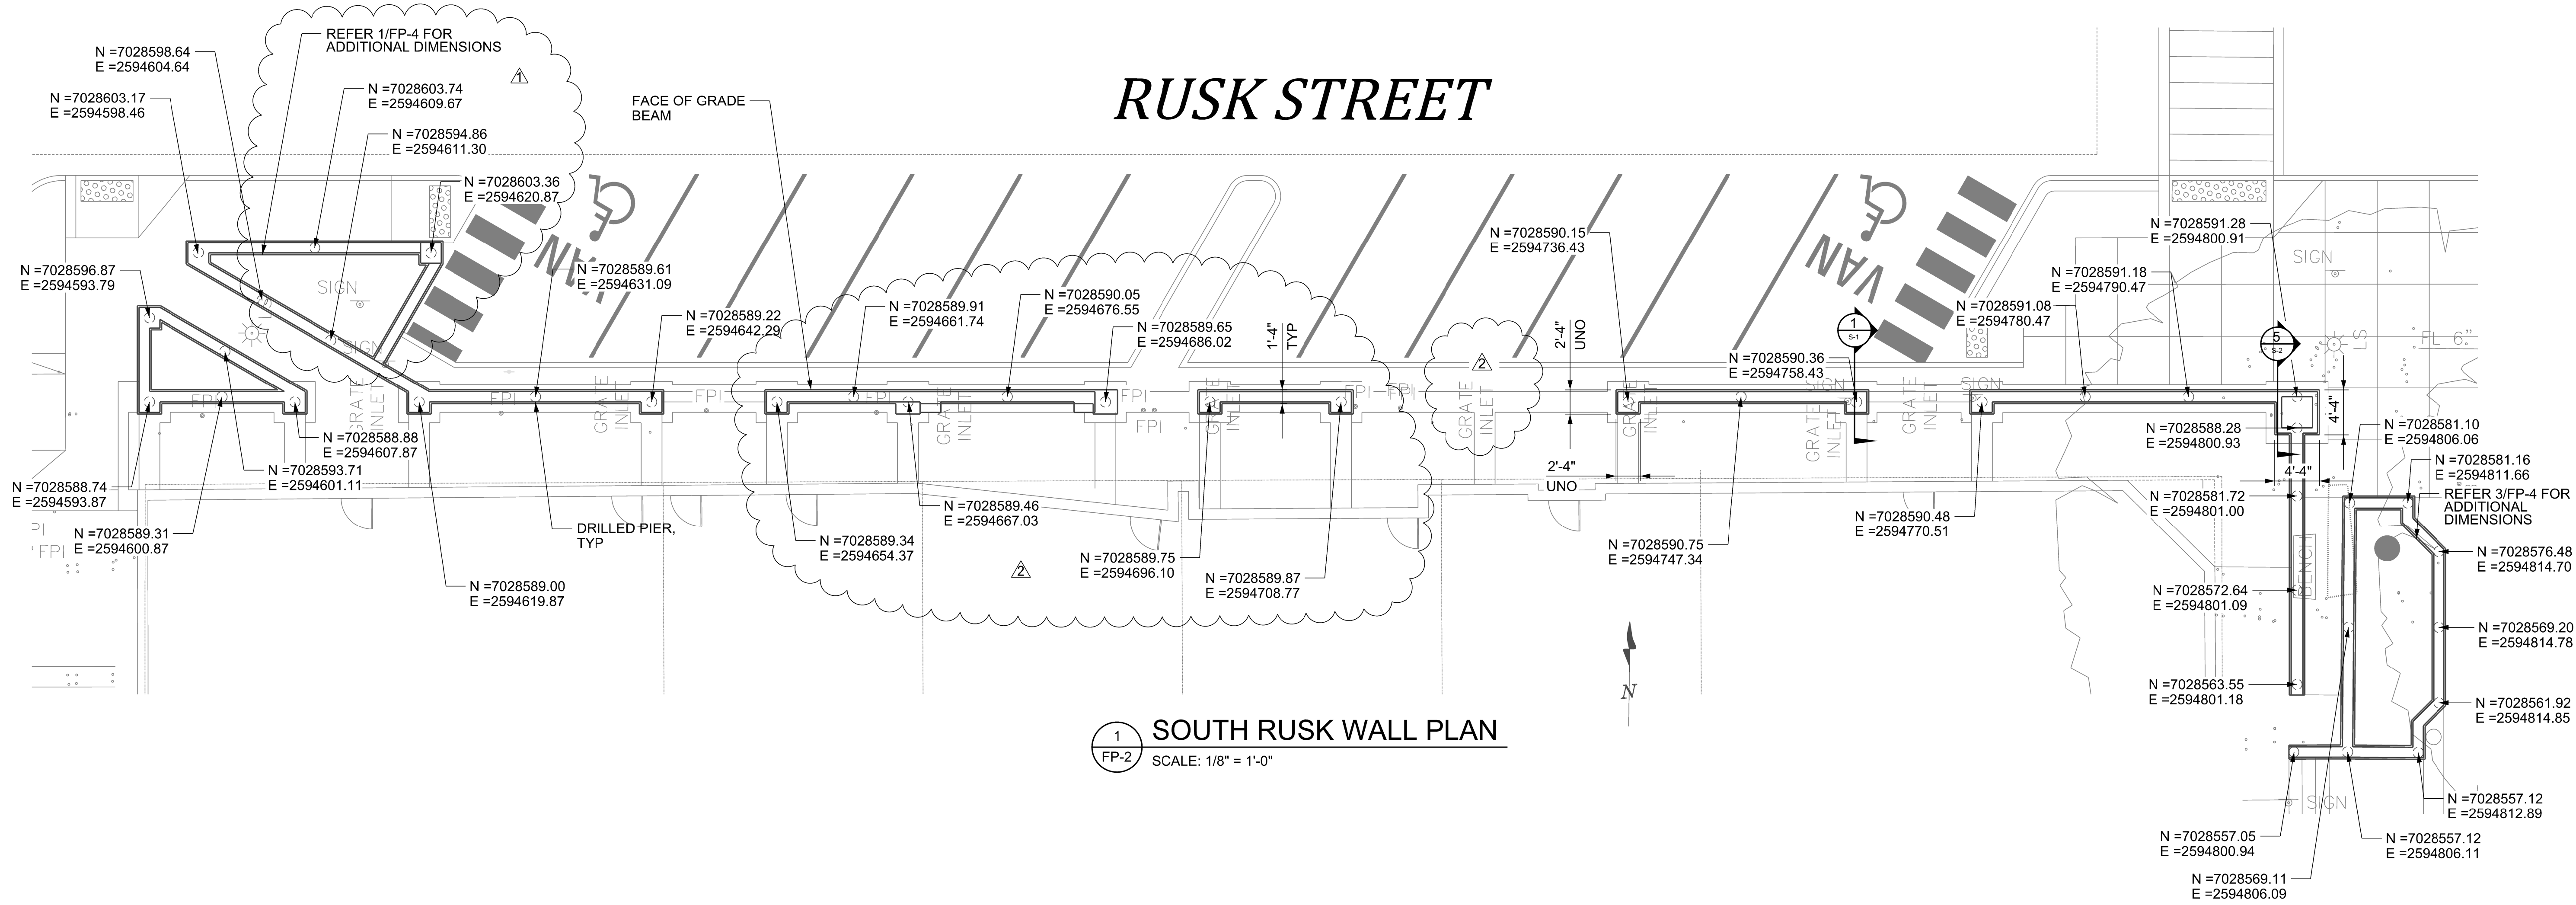

# RUSK STREET

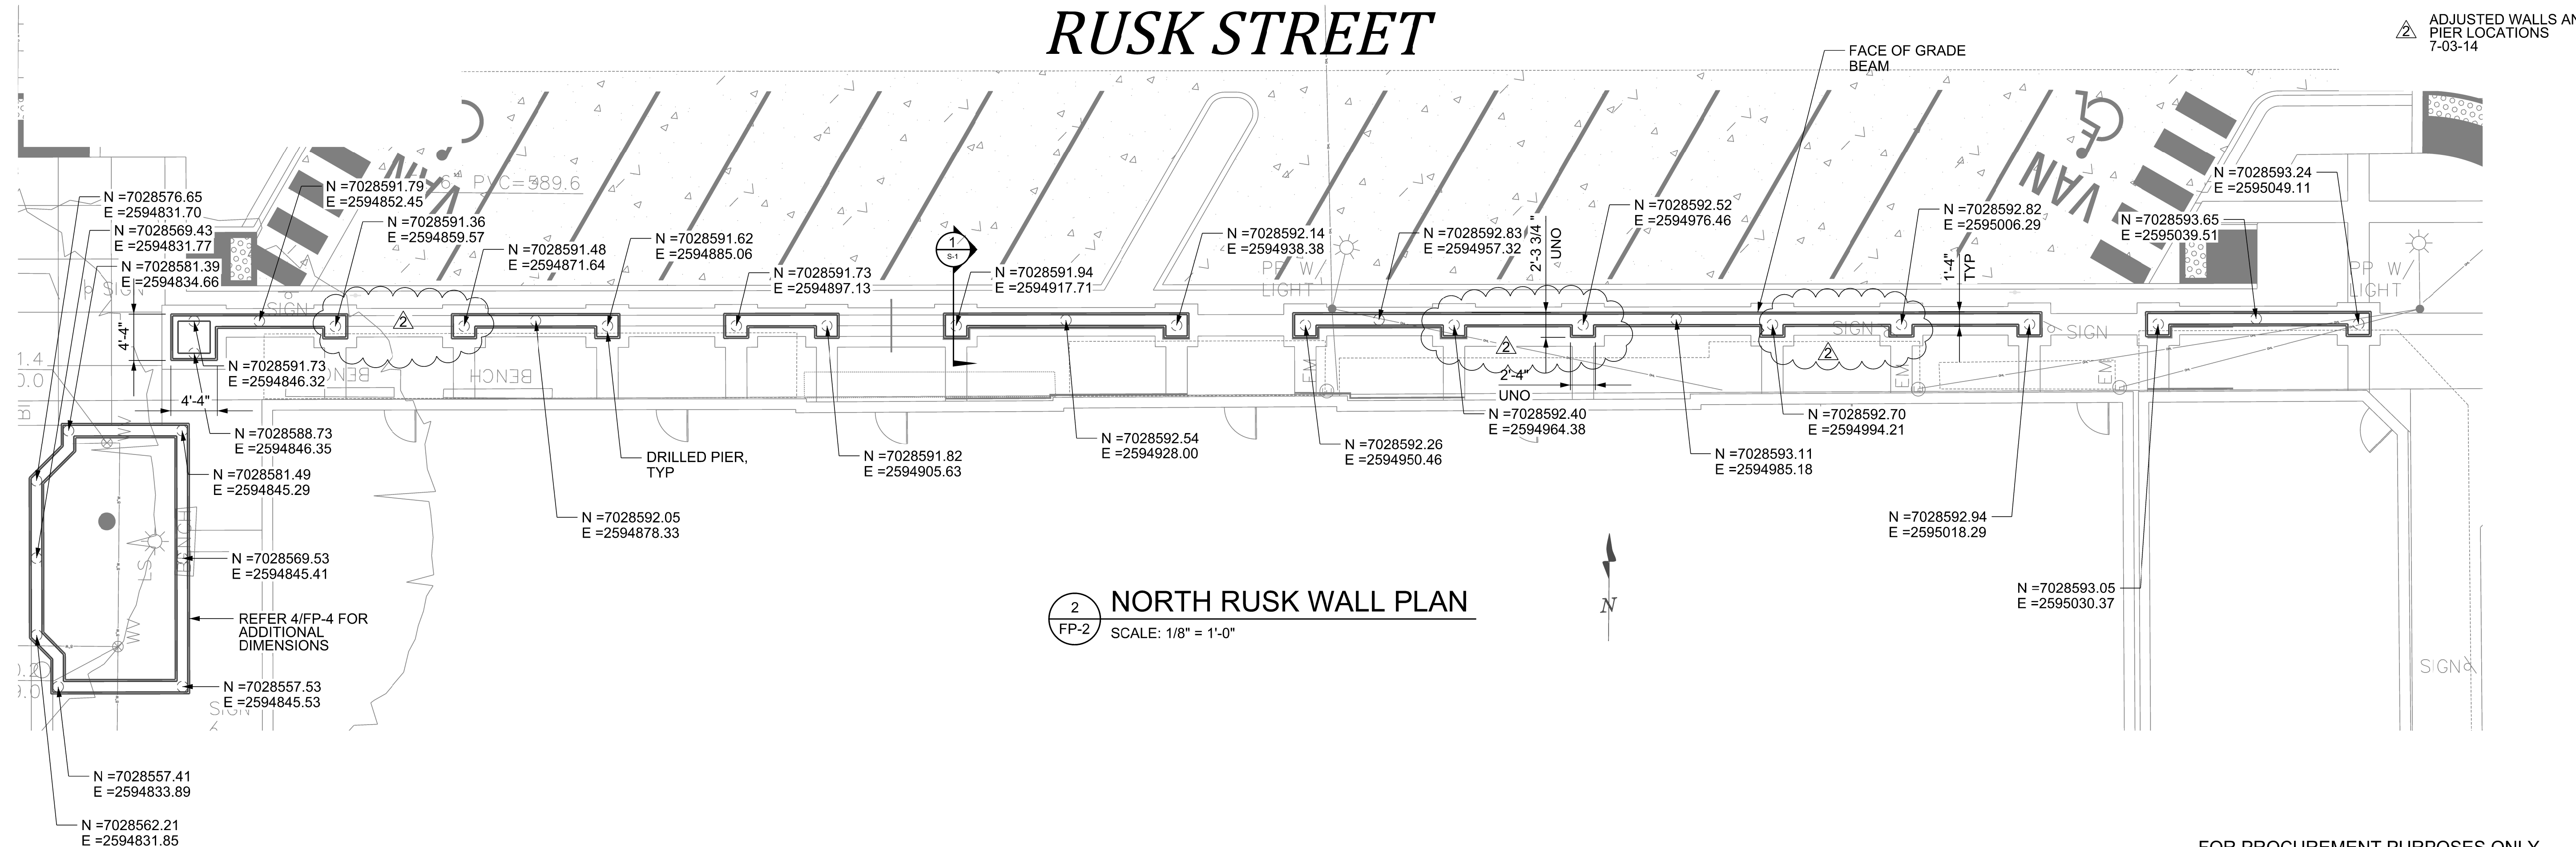

FOR PROCUREMENT PURPOSES ONLY  
**PIERCE ENGINEERING**  
STRUCTURAL ENGINEERING  
BUS.: (940) 937-8600 132 N. MAIN STREET  
FIRM REG #: F-9186 CHILDRESS, TX 79201