


1 ENLARGEMENT PLAN
SCALE: 1" = 10'-0"

SITE PLAN LEGEND:

	EDGE OF PAVEMENT
	CONCRETE SIDEWALK PAVEMENT
	CONCRETE VEHICULAR PAVEMENT
	TYPICAL LIGHT FIXTURE

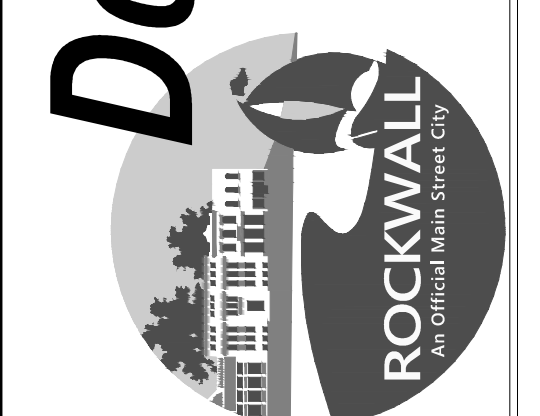

submittals / revisions

no.	date	detail
△	07/25/14	RFI #104

la terra studio, inc.

12024
Its project number
02.26.2014
date
rac; bhm
drawn by
mtb
checked by

registration

sheet title

Enlargement Plan
sheet number

EP-4