




© 2013 la terra studio, inc. All Rights Reserved FILE:R:\12024-Downtown Rockwall PS&E - Rockwall\CAD\ISHEET\12024-Str Details_5.dwg

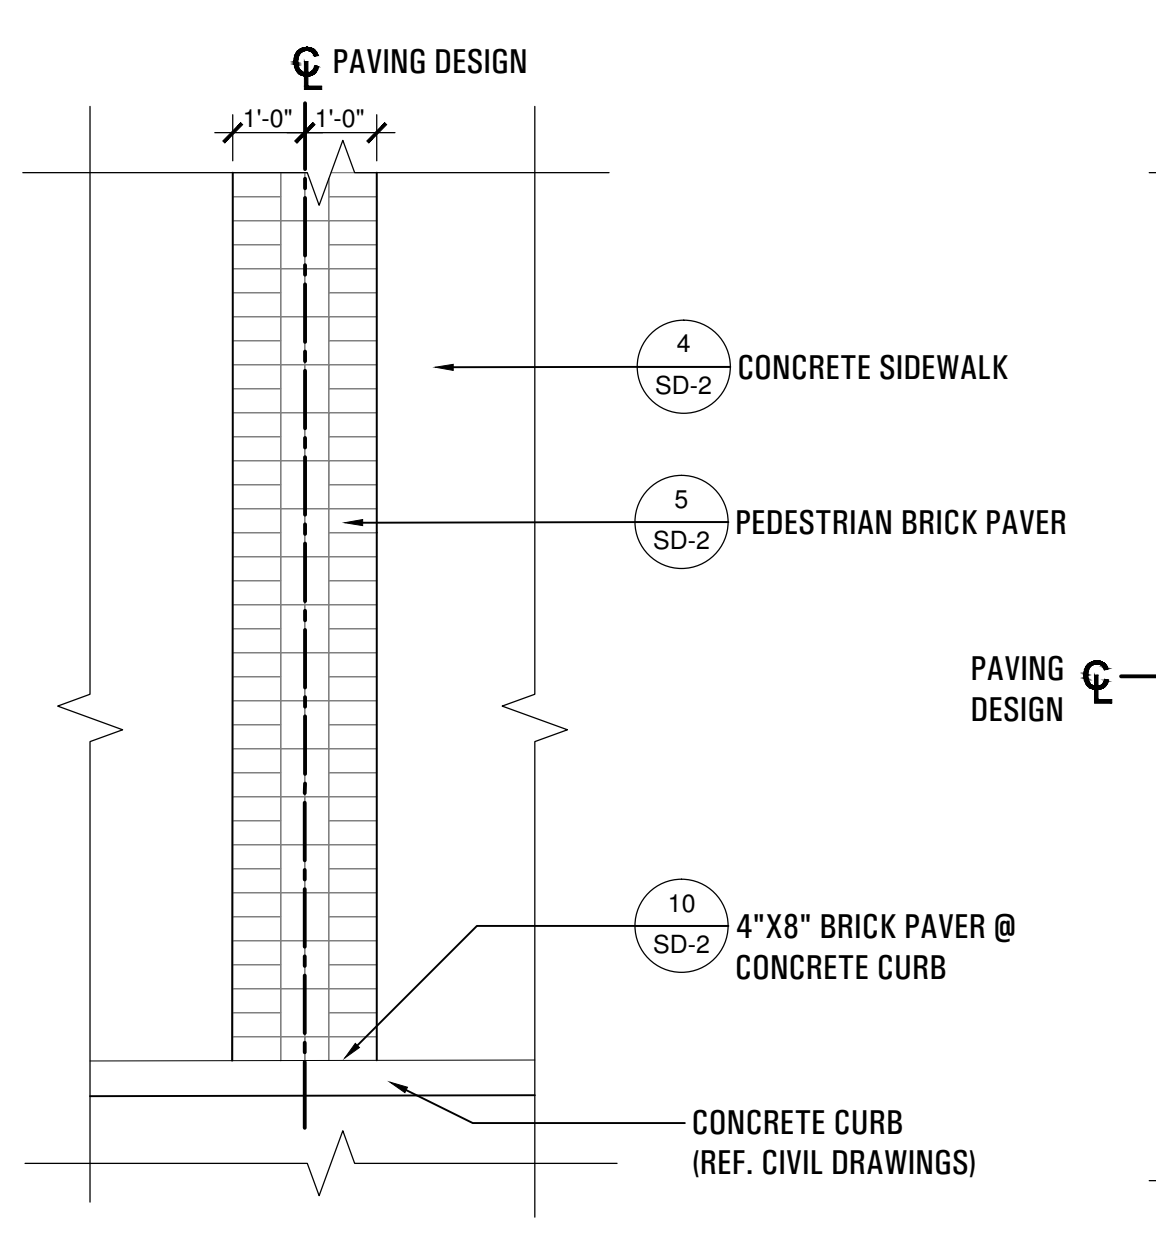


1 PAVER BAND LAYOUT PLAN
SCALE: 3/8" = 1'-0"
NOTE: ALL PAPER BAND COLOR TO BE MINGEL SEE SPECIFICATIONS

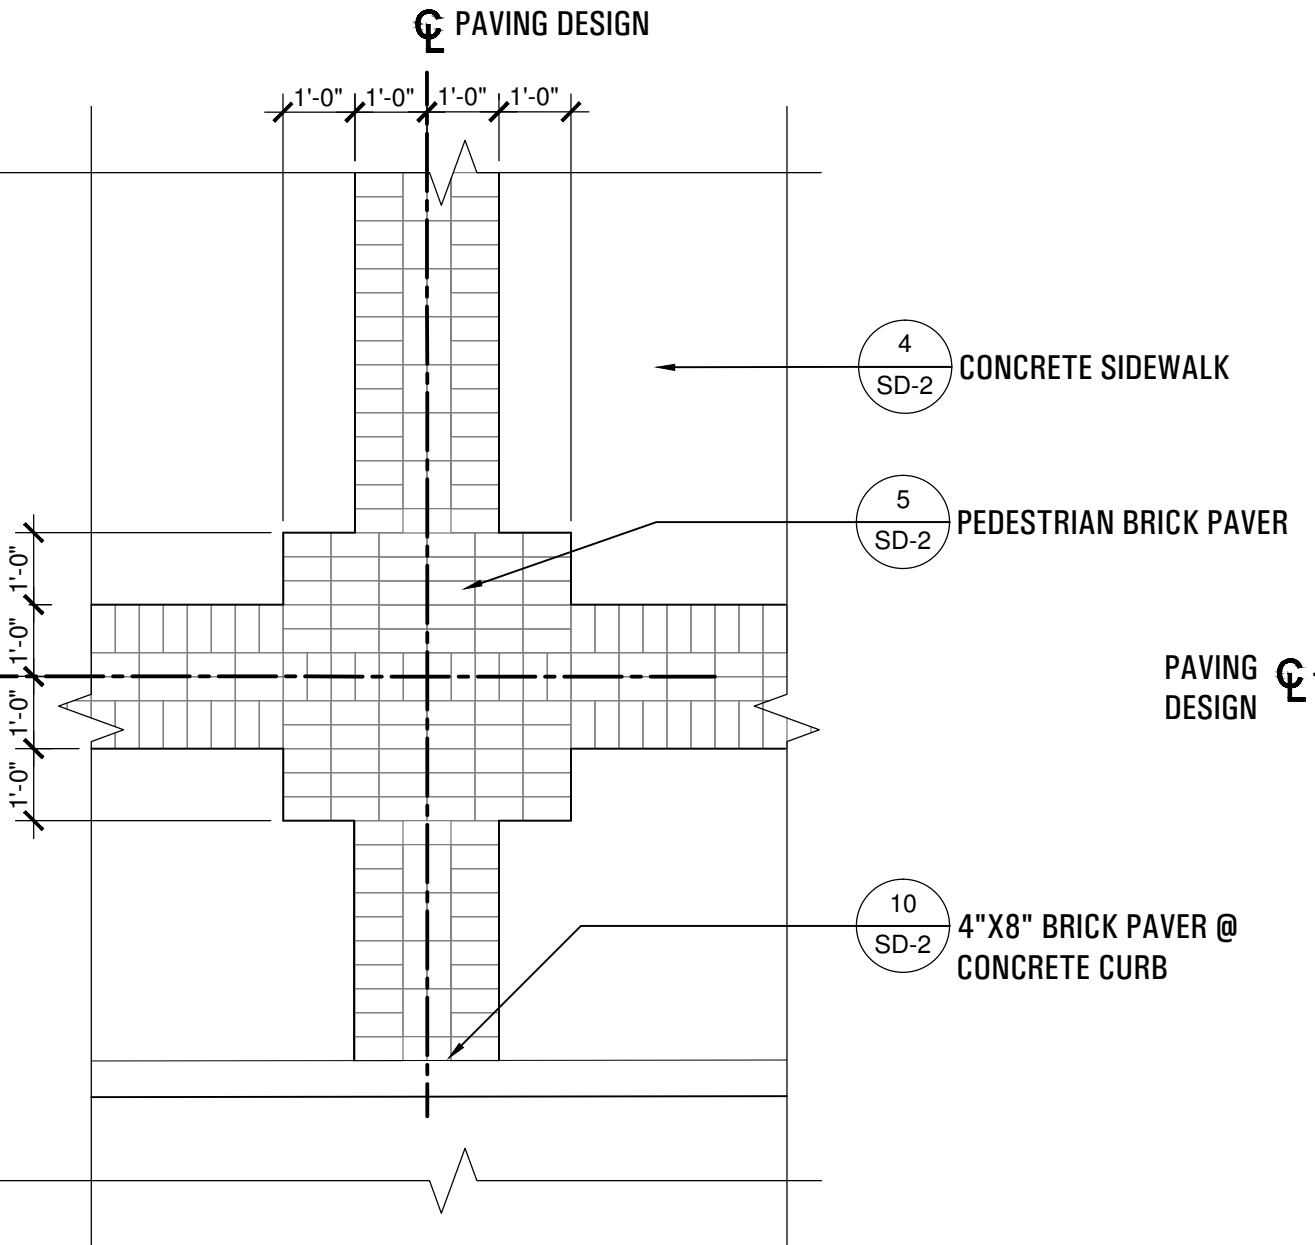


2 EXTENDED PAVER LAYOUT PLAN
SCALE: 3/8" = 1'-0"
NOTE: ALL PAPER BAND COLOR TO BE MINGEL SEE SPECIFICATIONS

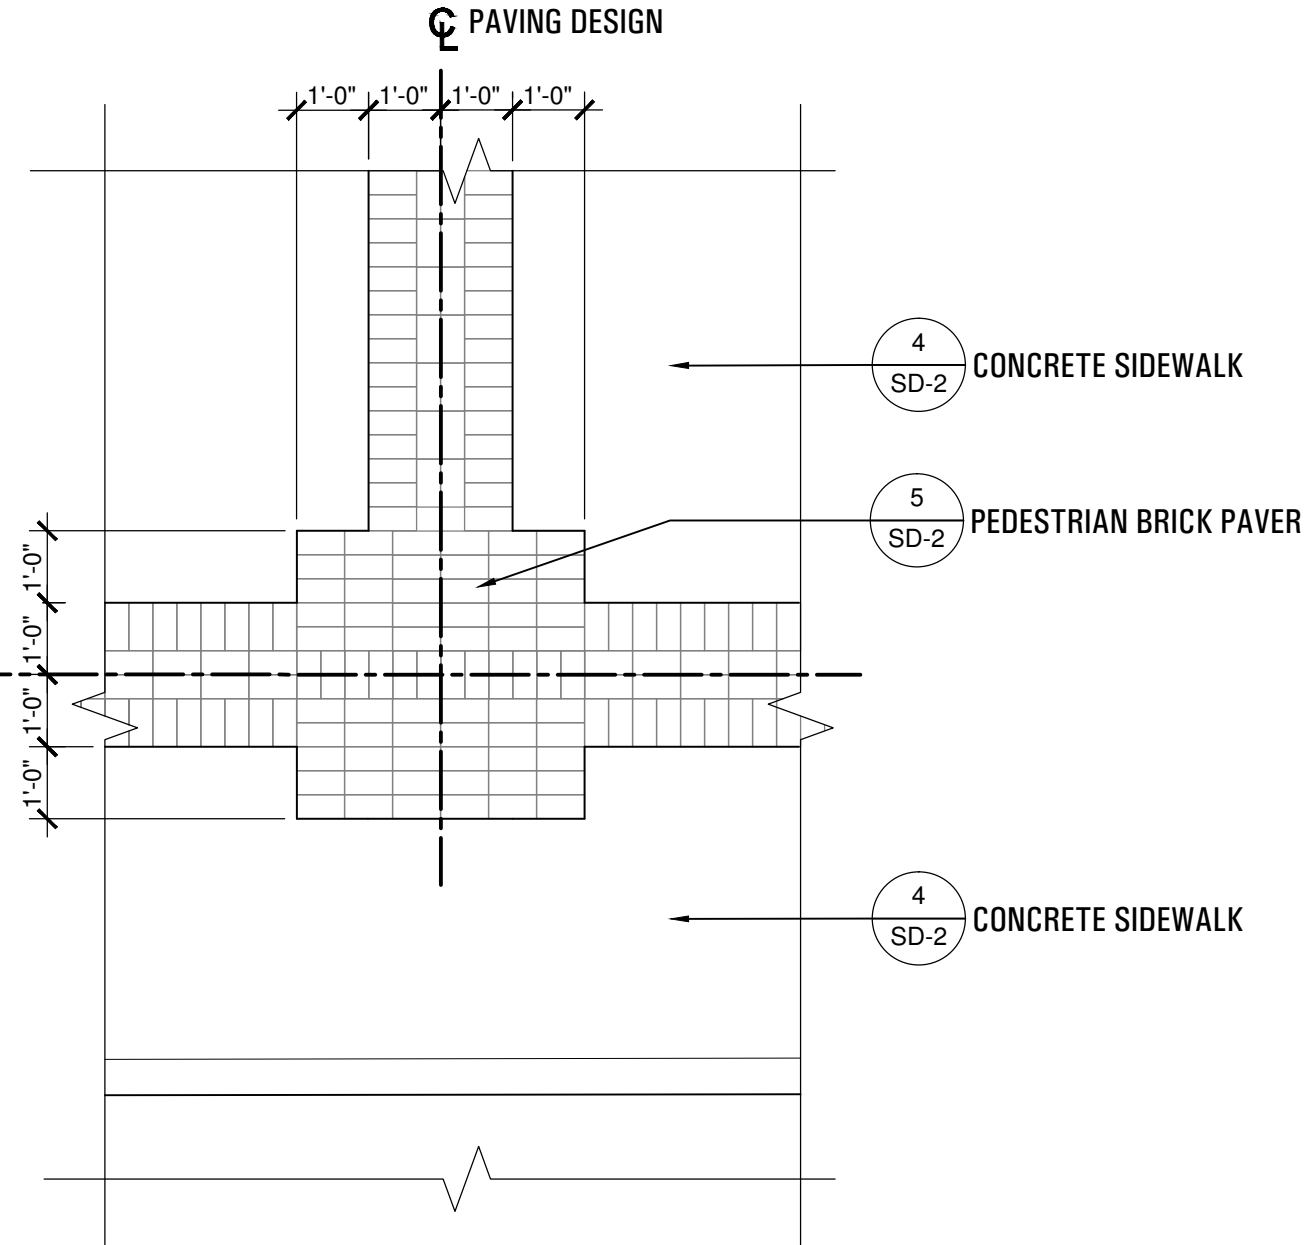


3 PAVER LAYOUT PLAN
SCALE: 3/8" = 1'-0"
NOTE: ALL PAPER BAND COLOR TO BE MINGEL SEE SPECIFICATIONS

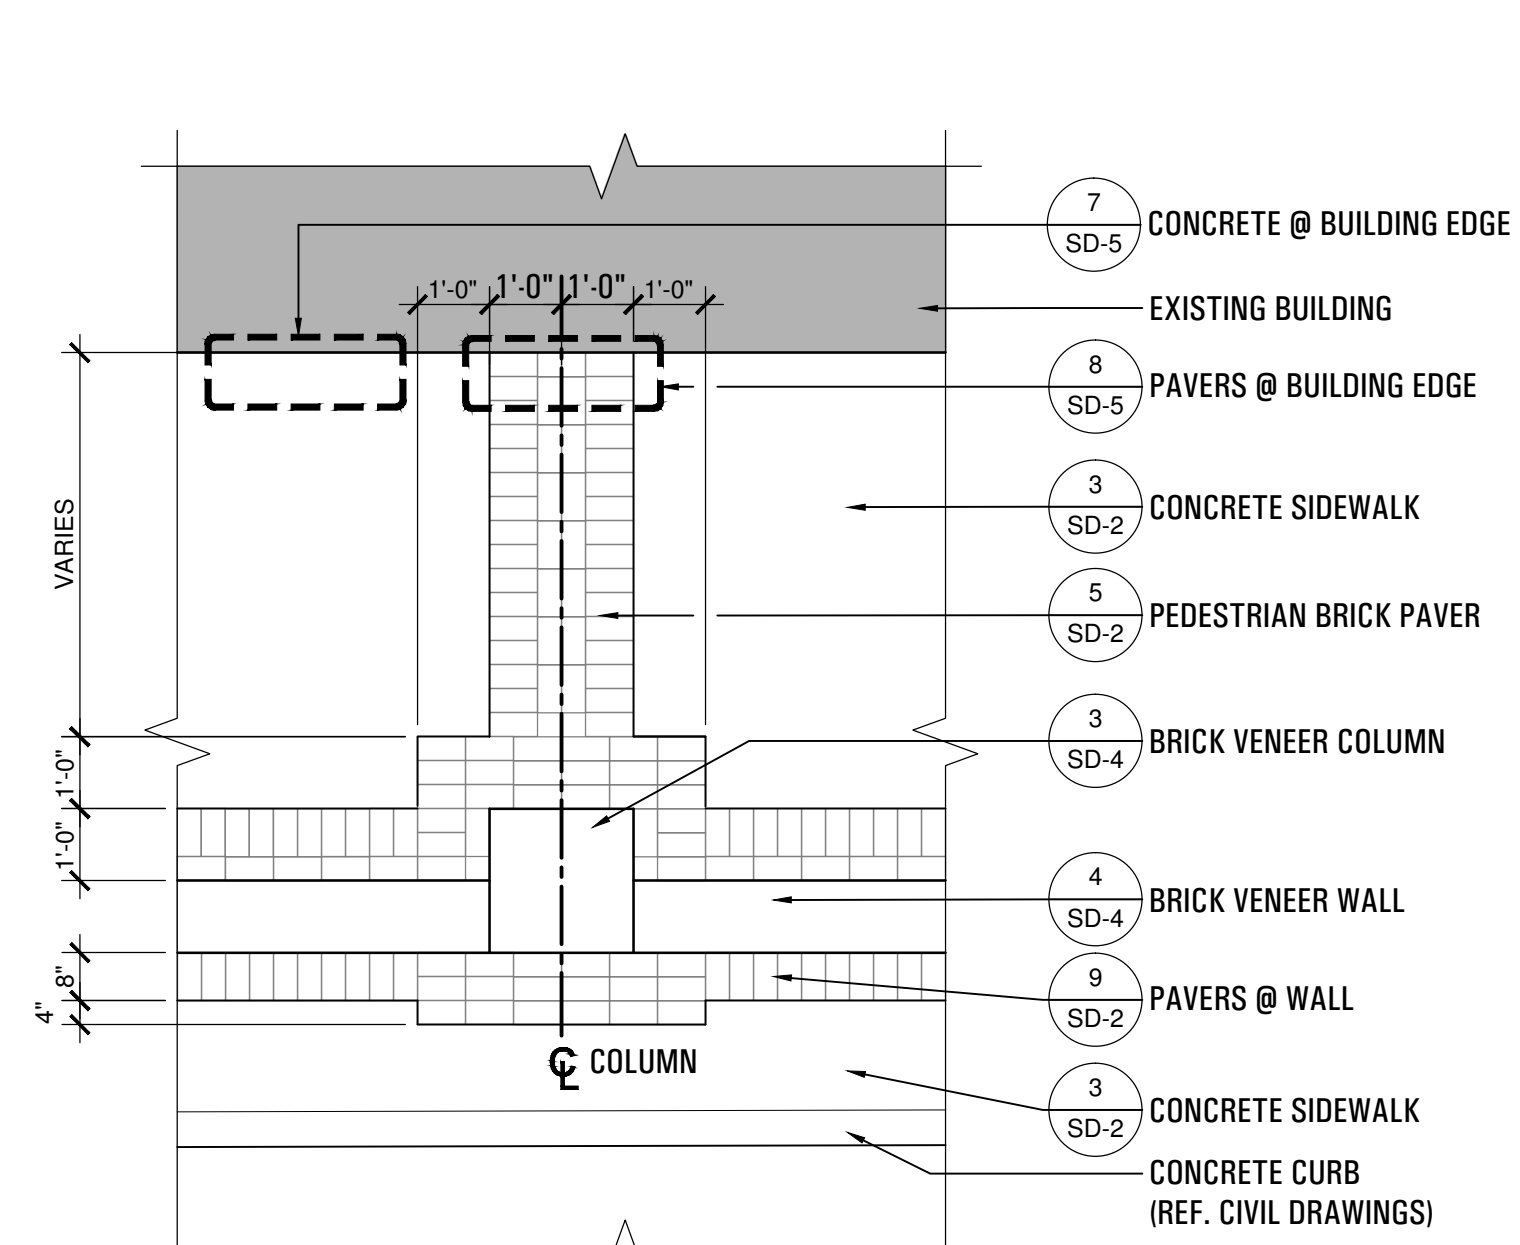


4 PAVER LAYOUT PLAN @ WALL
SCALE: 3/8" = 1'-0"
NOTE: ALL PAPER BAND COLOR TO BE MINGEL SEE SPECIFICATIONS

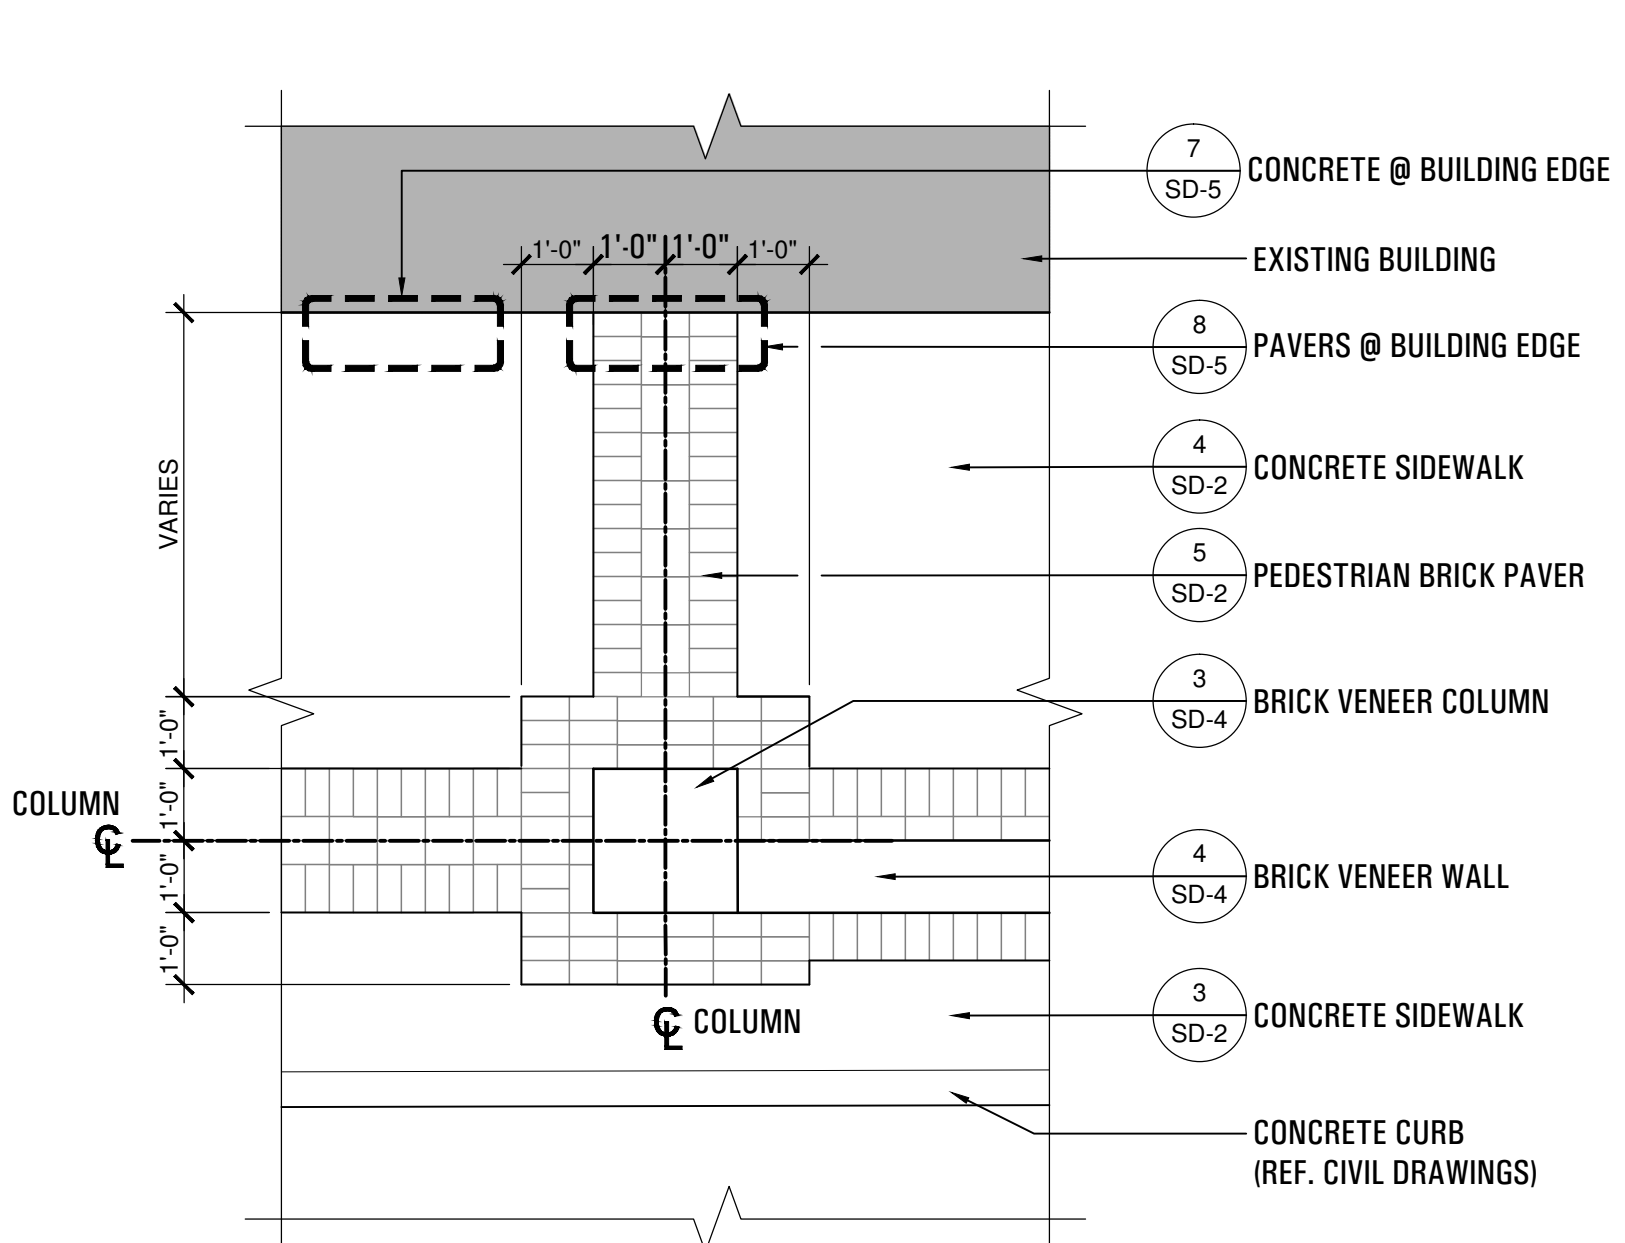


5 PAVER LAYOUT PLAN @ WALL TERMINATION
SCALE: 3/8" = 1'-0"
NOTE: ALL PAPER BAND COLOR TO BE MINGEL SEE SPECIFICATIONS

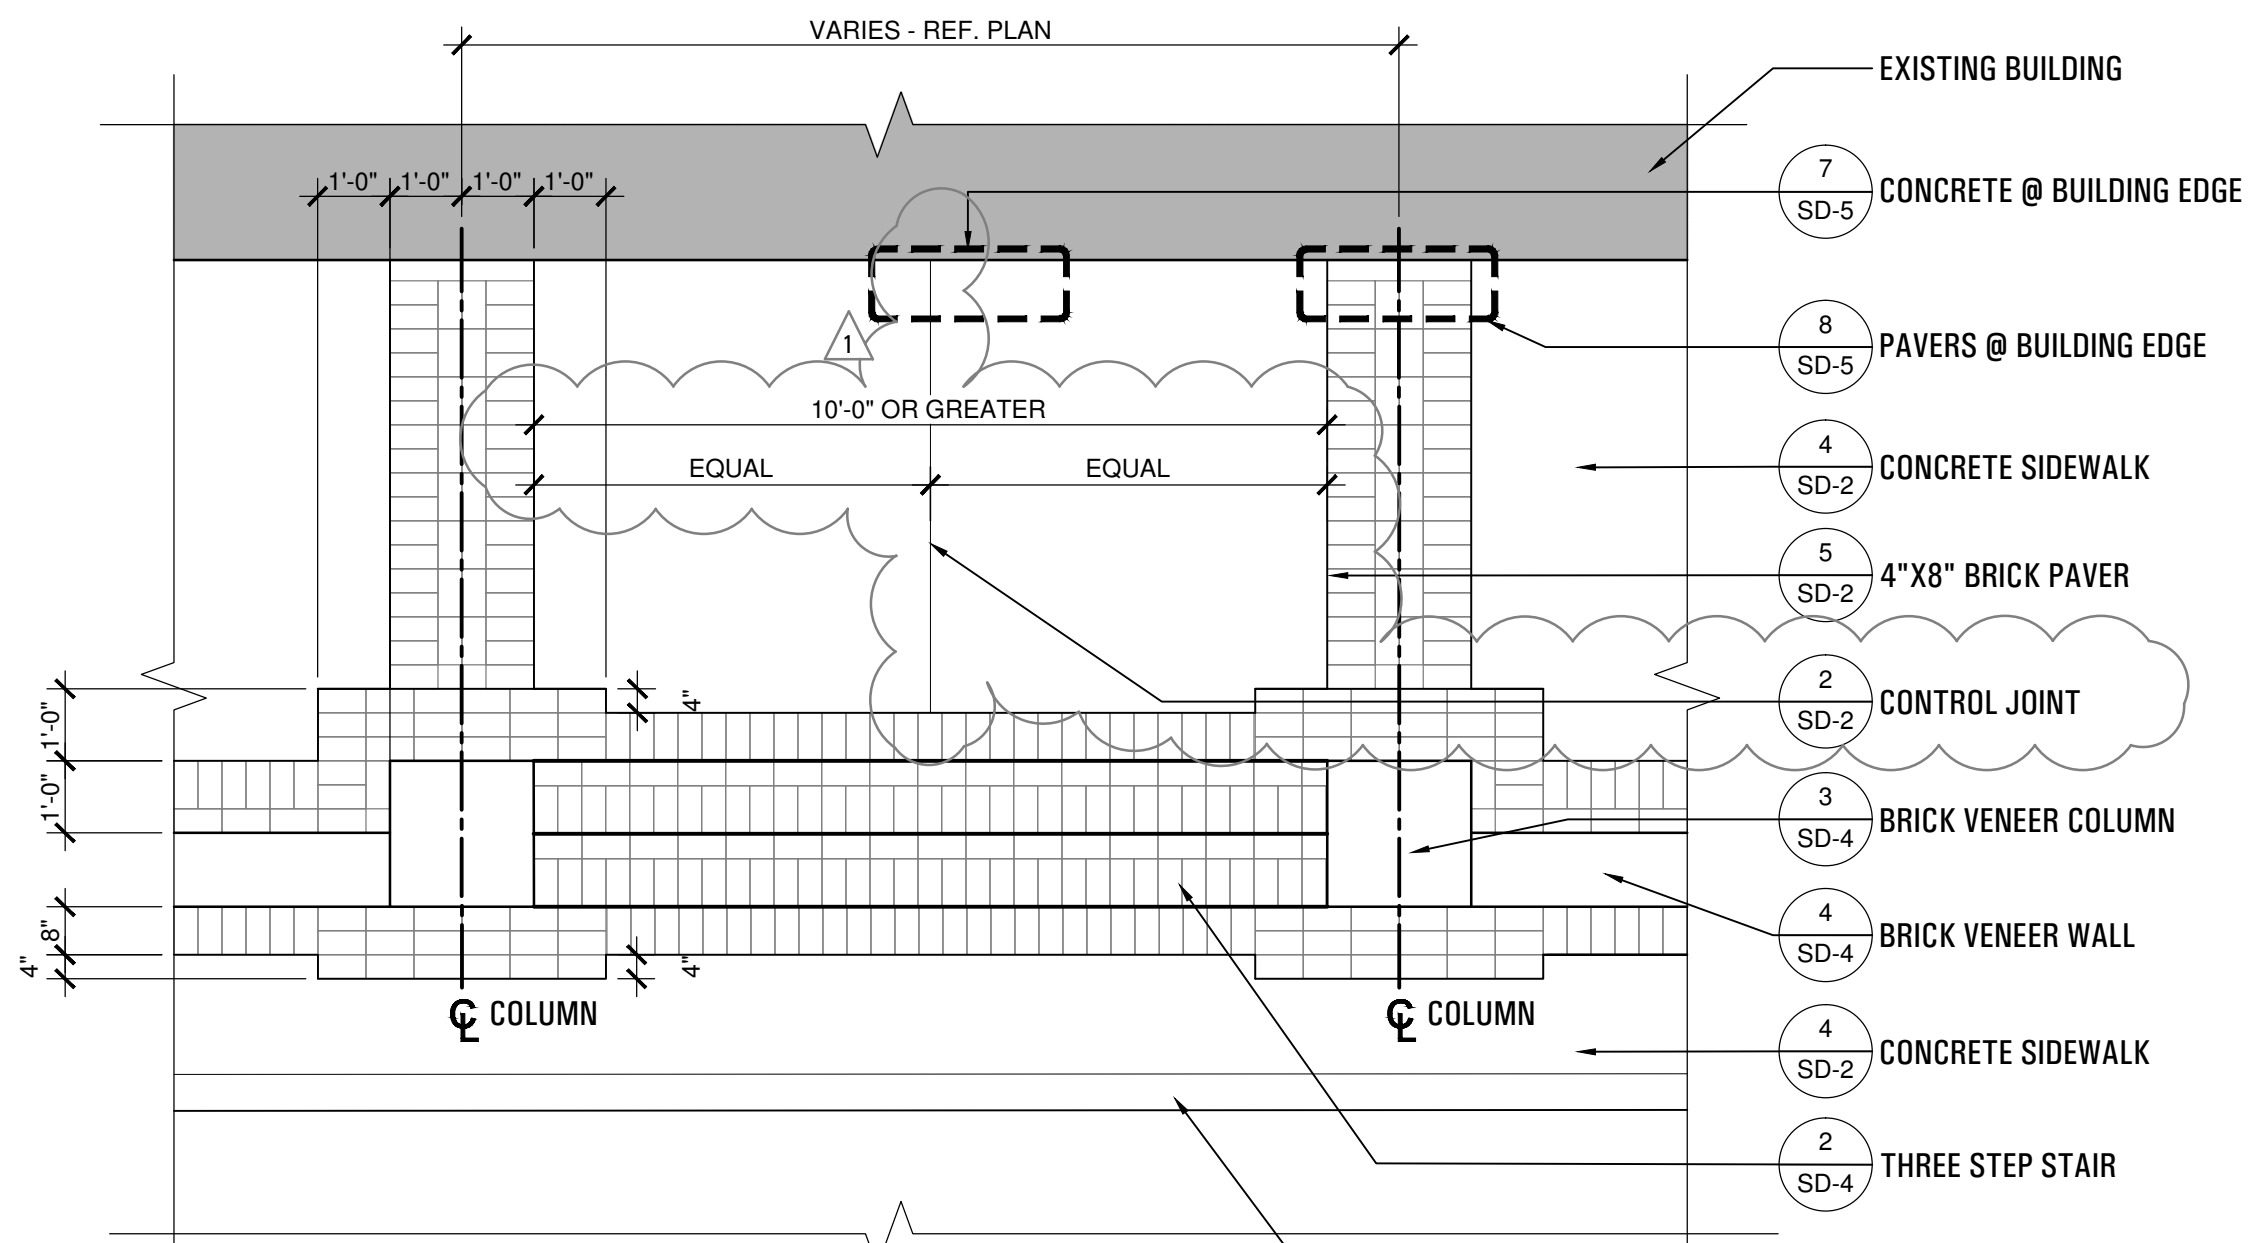


6 PAVER LAYOUT PLAN @ STEPS
SCALE: 3/8" = 1'-0"
NOTE: ALL PAPER BAND COLOR TO BE MINGEL SEE SPECIFICATIONS

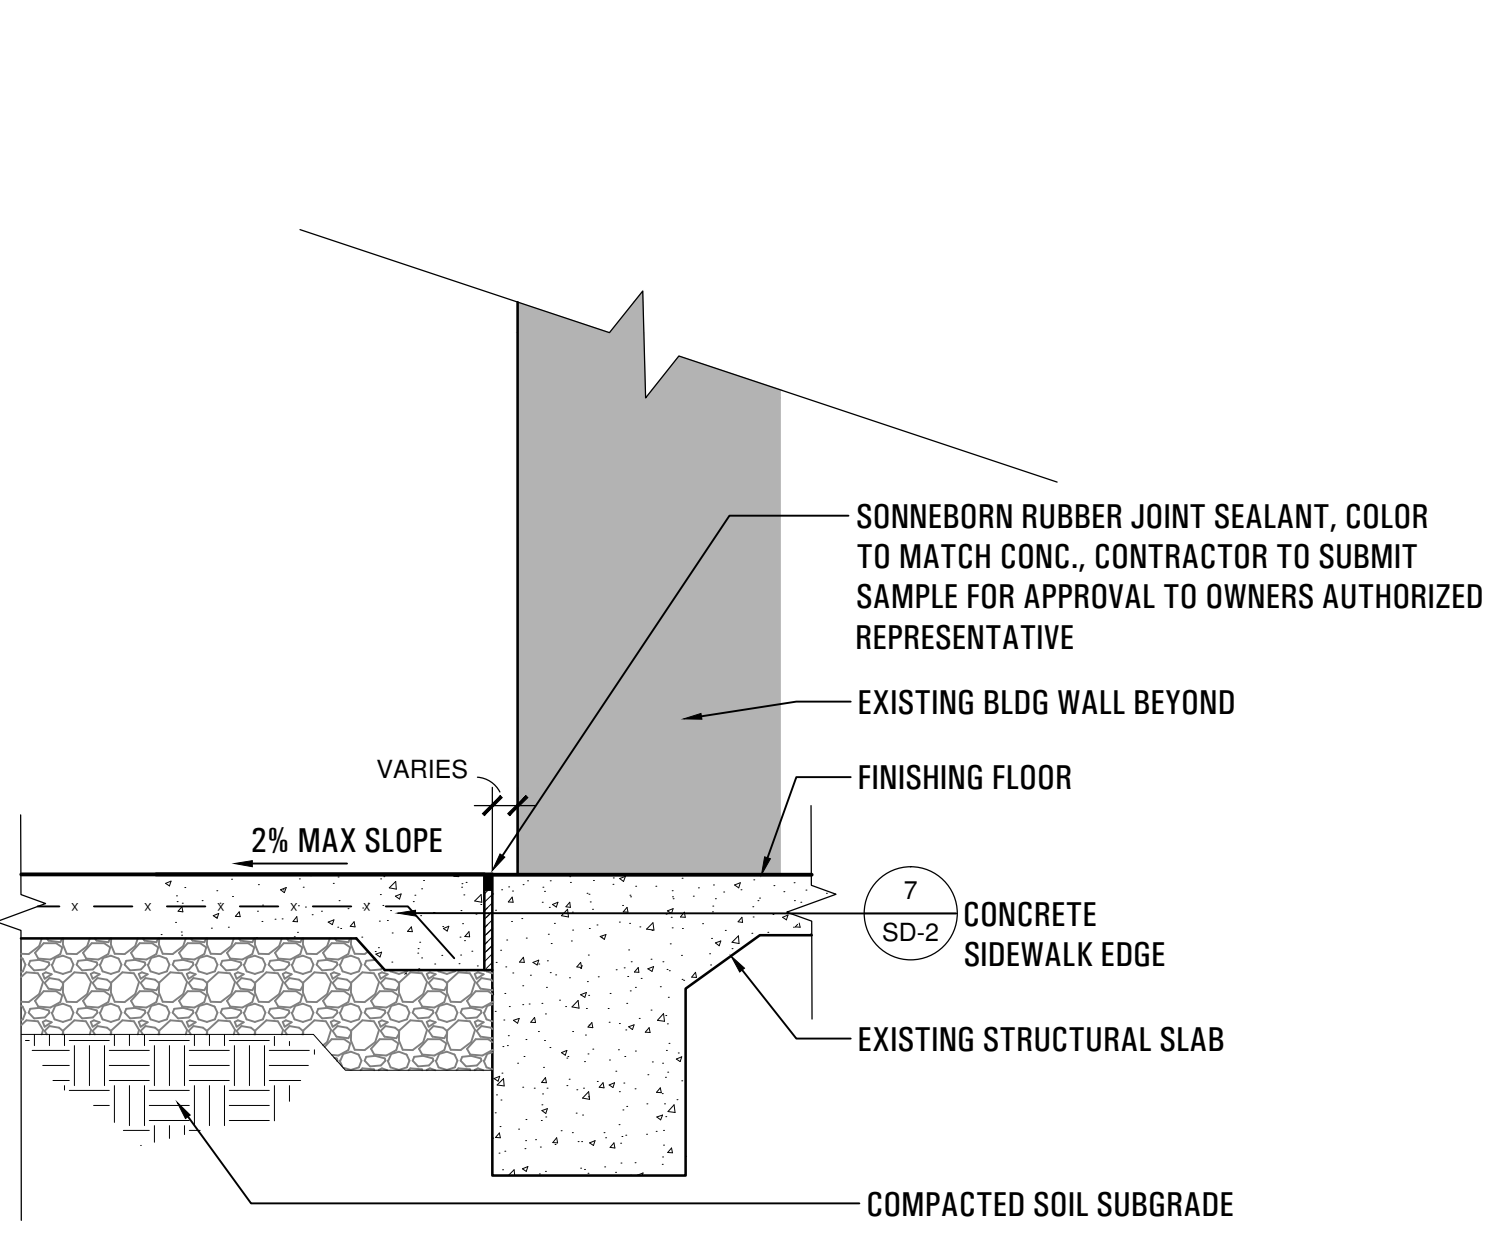


7 CONCRETE WALK @ BUILDING EDGE
SCALE: 1" = 1'-0"

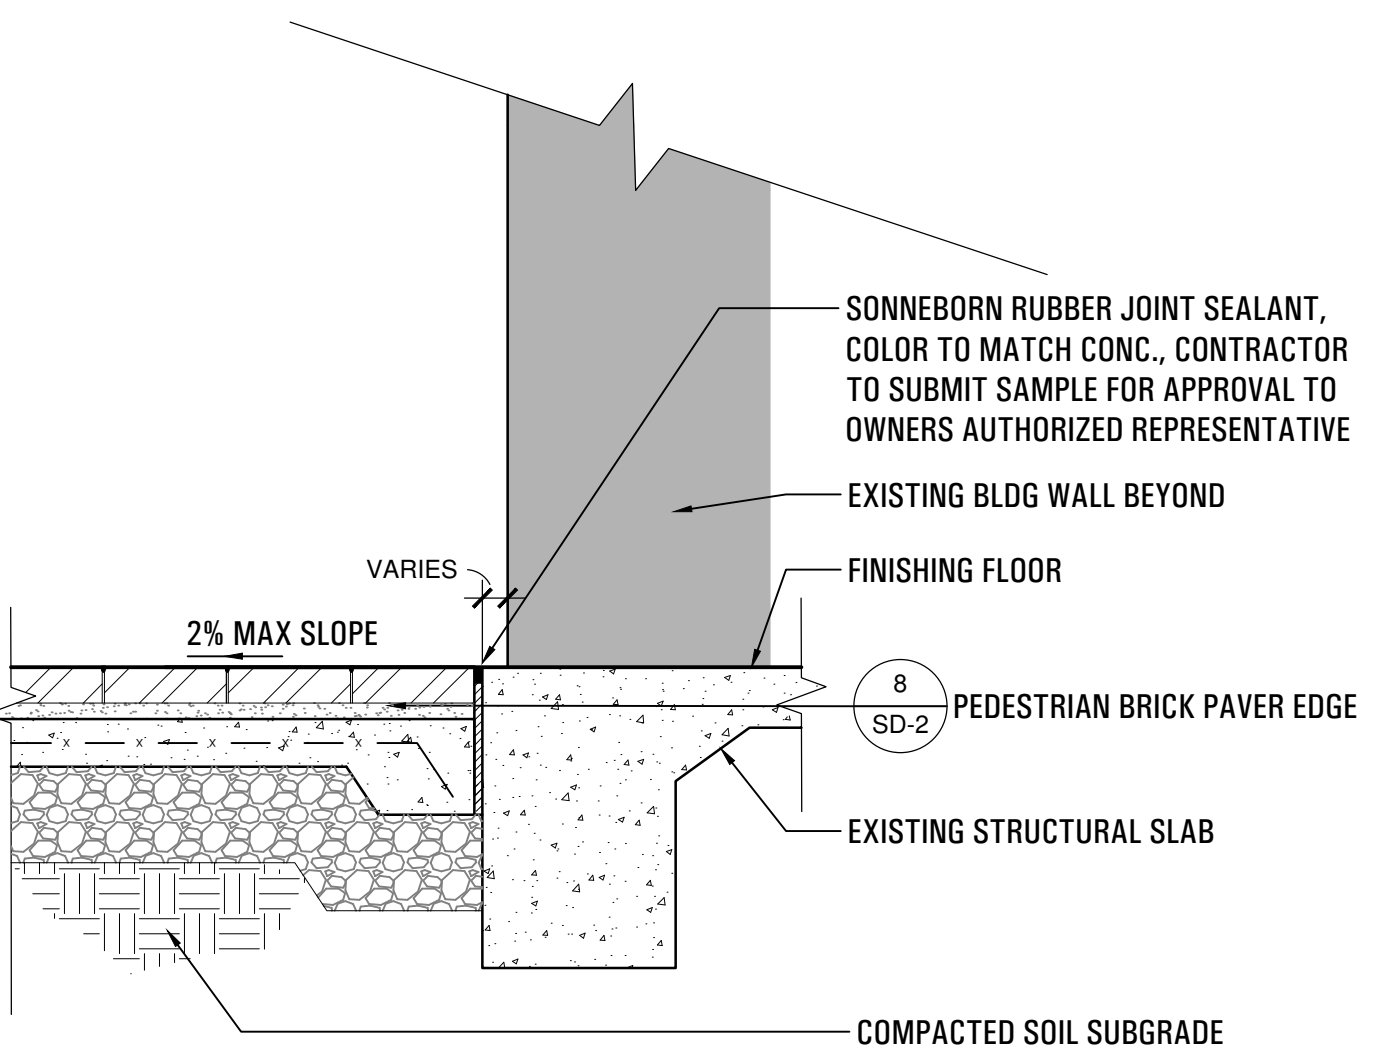


8 PAVERS @ BUILDING EDGE
SCALE: 1" = 1'-0"

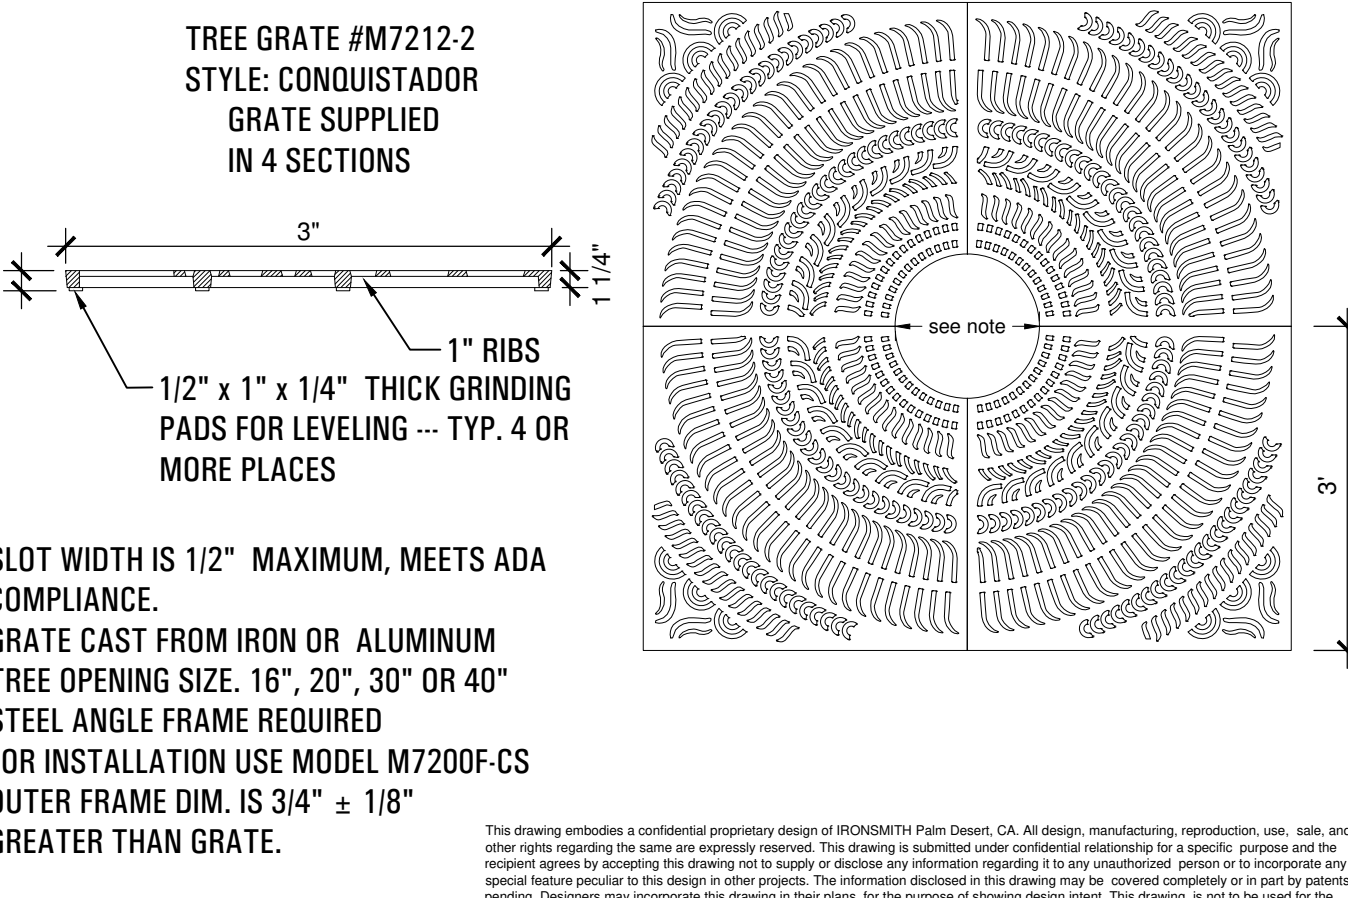


9 TREE GRATE
N.T.S.

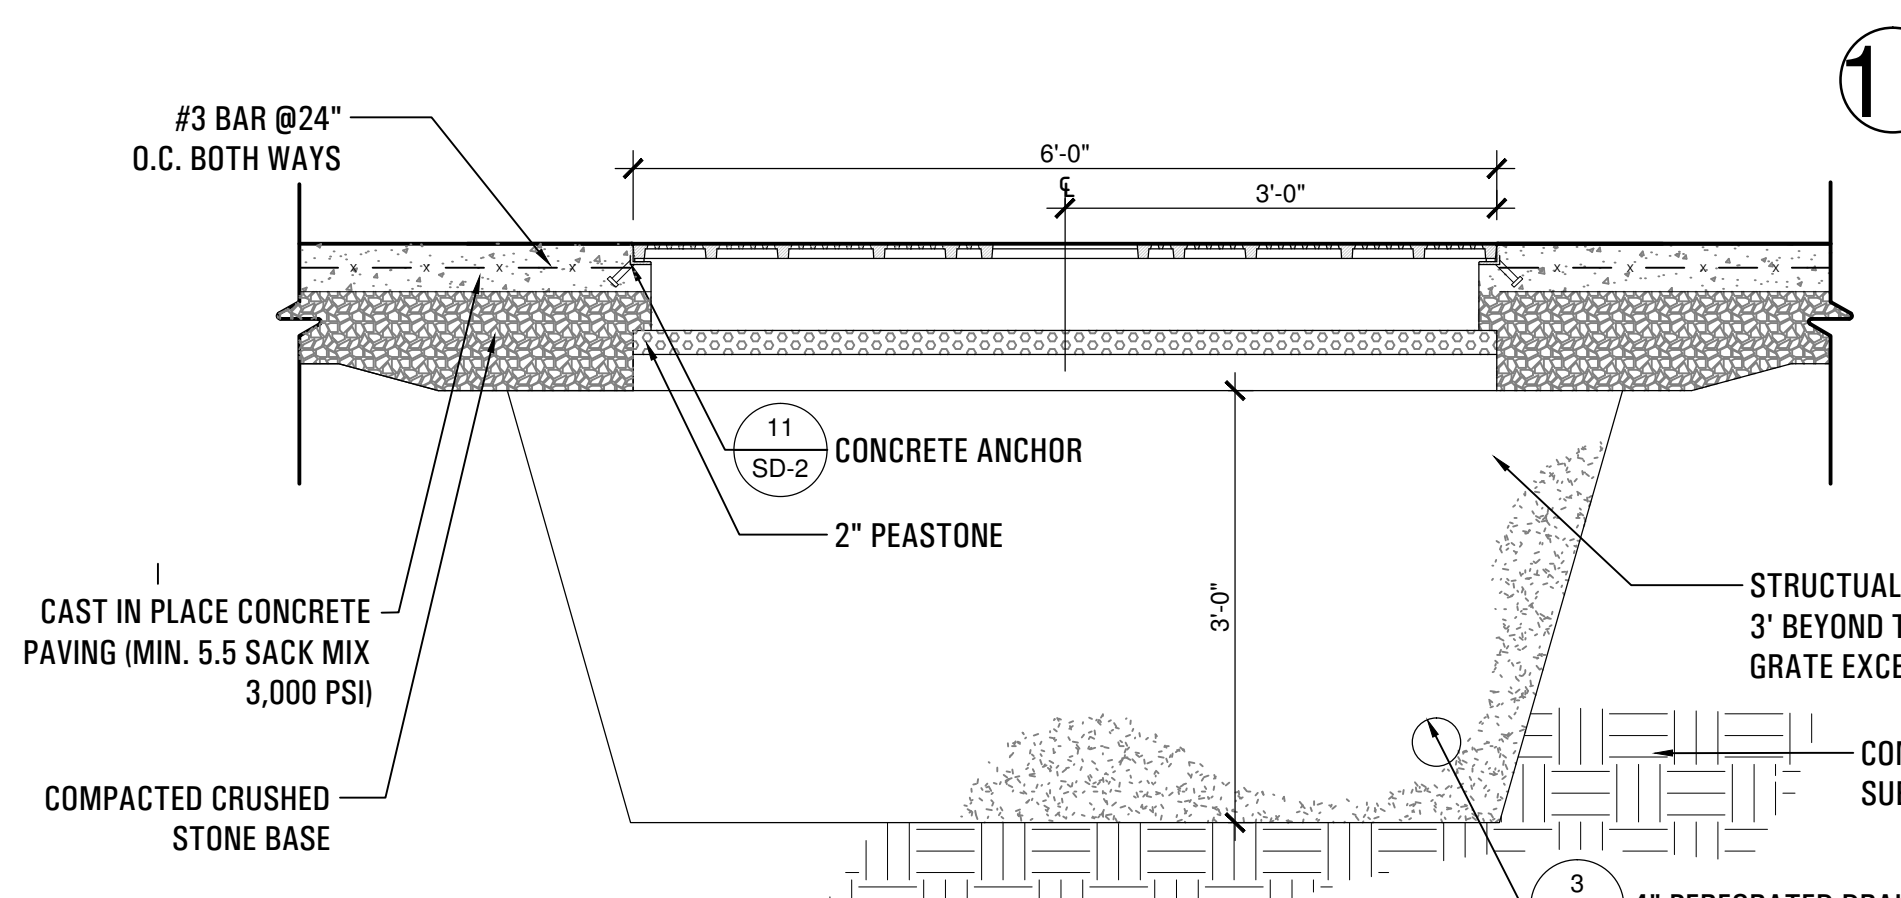

10 TREE WELL WITH GRATE
SCALE: 3/4" = 1'-0"

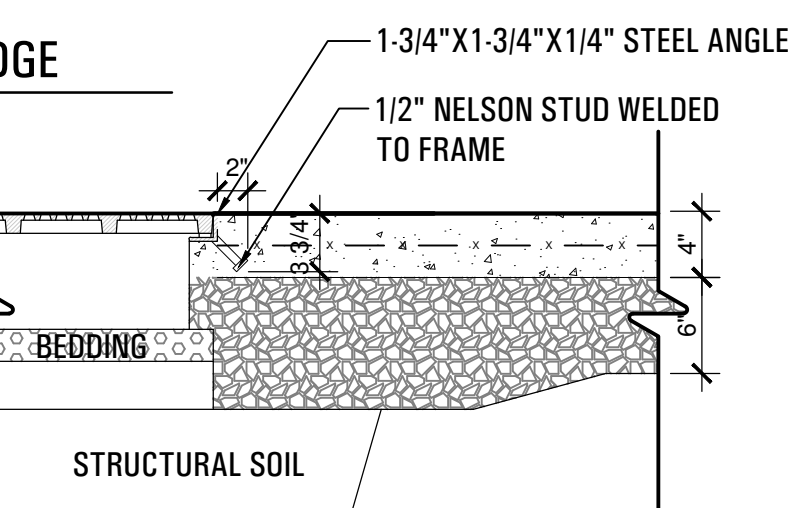

11 TREE GRATE WITH CONCRETE ANCHOR
SCALE: 1" = 1'-0"

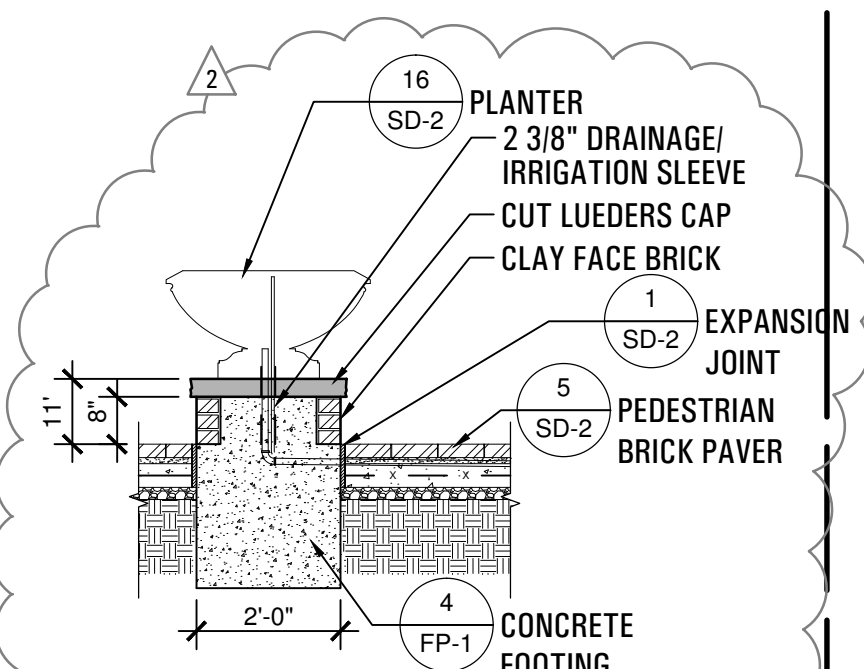

12 BRICK VENEER PLINTH
SCALE: 3/8" = 1'-0"



submittals / revisions

no.	date	detail
1	8/17/14	6 PAVER LAYOUT PLAN
2	7/25/14	RFI # 104

la terra studio, inc.

12024
its project number
02.26.2014
date
rac; bhm
drawn by
mtb
checked by

