


GRADING PLAN LEGEND:

- PHASE 1 PROJECT LIMIT LINE
- EXISTING GRADE CONTOUR
- FINISH GRADE CONTOUR
- FINISH SPOT GRADE
- SEE CIVIL FOR CROSS REFERENCE OF PROPOSED ELEVATION
- TOP STEP
- BOTTOM STEP
- TOP OF WALL
- BOTTOM OF WALL
- TOP OF CURB
- GUTTER
- FINISH FLOOR
- TOP OF COLUMN

sheet location

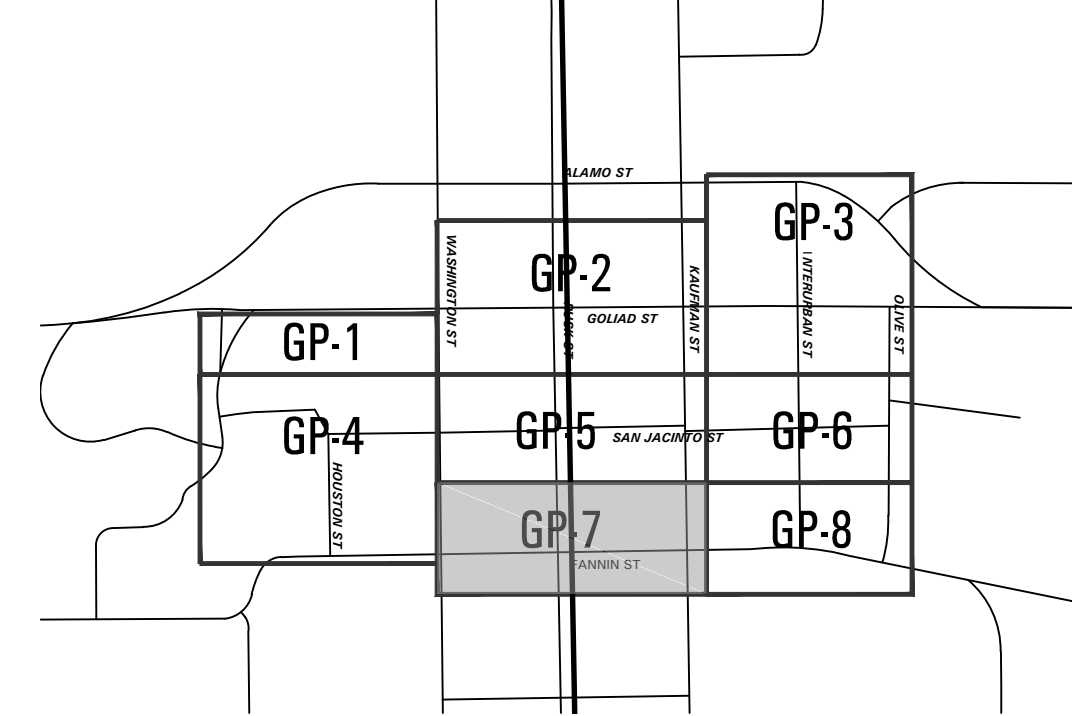

Downtown Rockwall
 la terra studio Project #12024
streetscape improvements
 PHASE 2
 rockwall, texas



submittals / revisions

no.	date	detail
△	05/08/14	RFI #20, #42, #43, #54
△	05/16/14	RFI #37
△	07/18/14	RFI #108

la terra studio, inc.

12024
 its project number
 02.26.2014
 date
 rac; bhm
 drawn by
 mth
 checked by



Grading Plan
 sheet number
GP-7