




SAN JACINTO STREET

1 RETAINING WALL PLAN
FP-3 SCALE: 1/8" = 1'-0"



SAN JACINTO STREET

2 BRICK VENEER PLANTER SOUTHWEST
FP-3 SCALE: 1/4" = 1'-0"

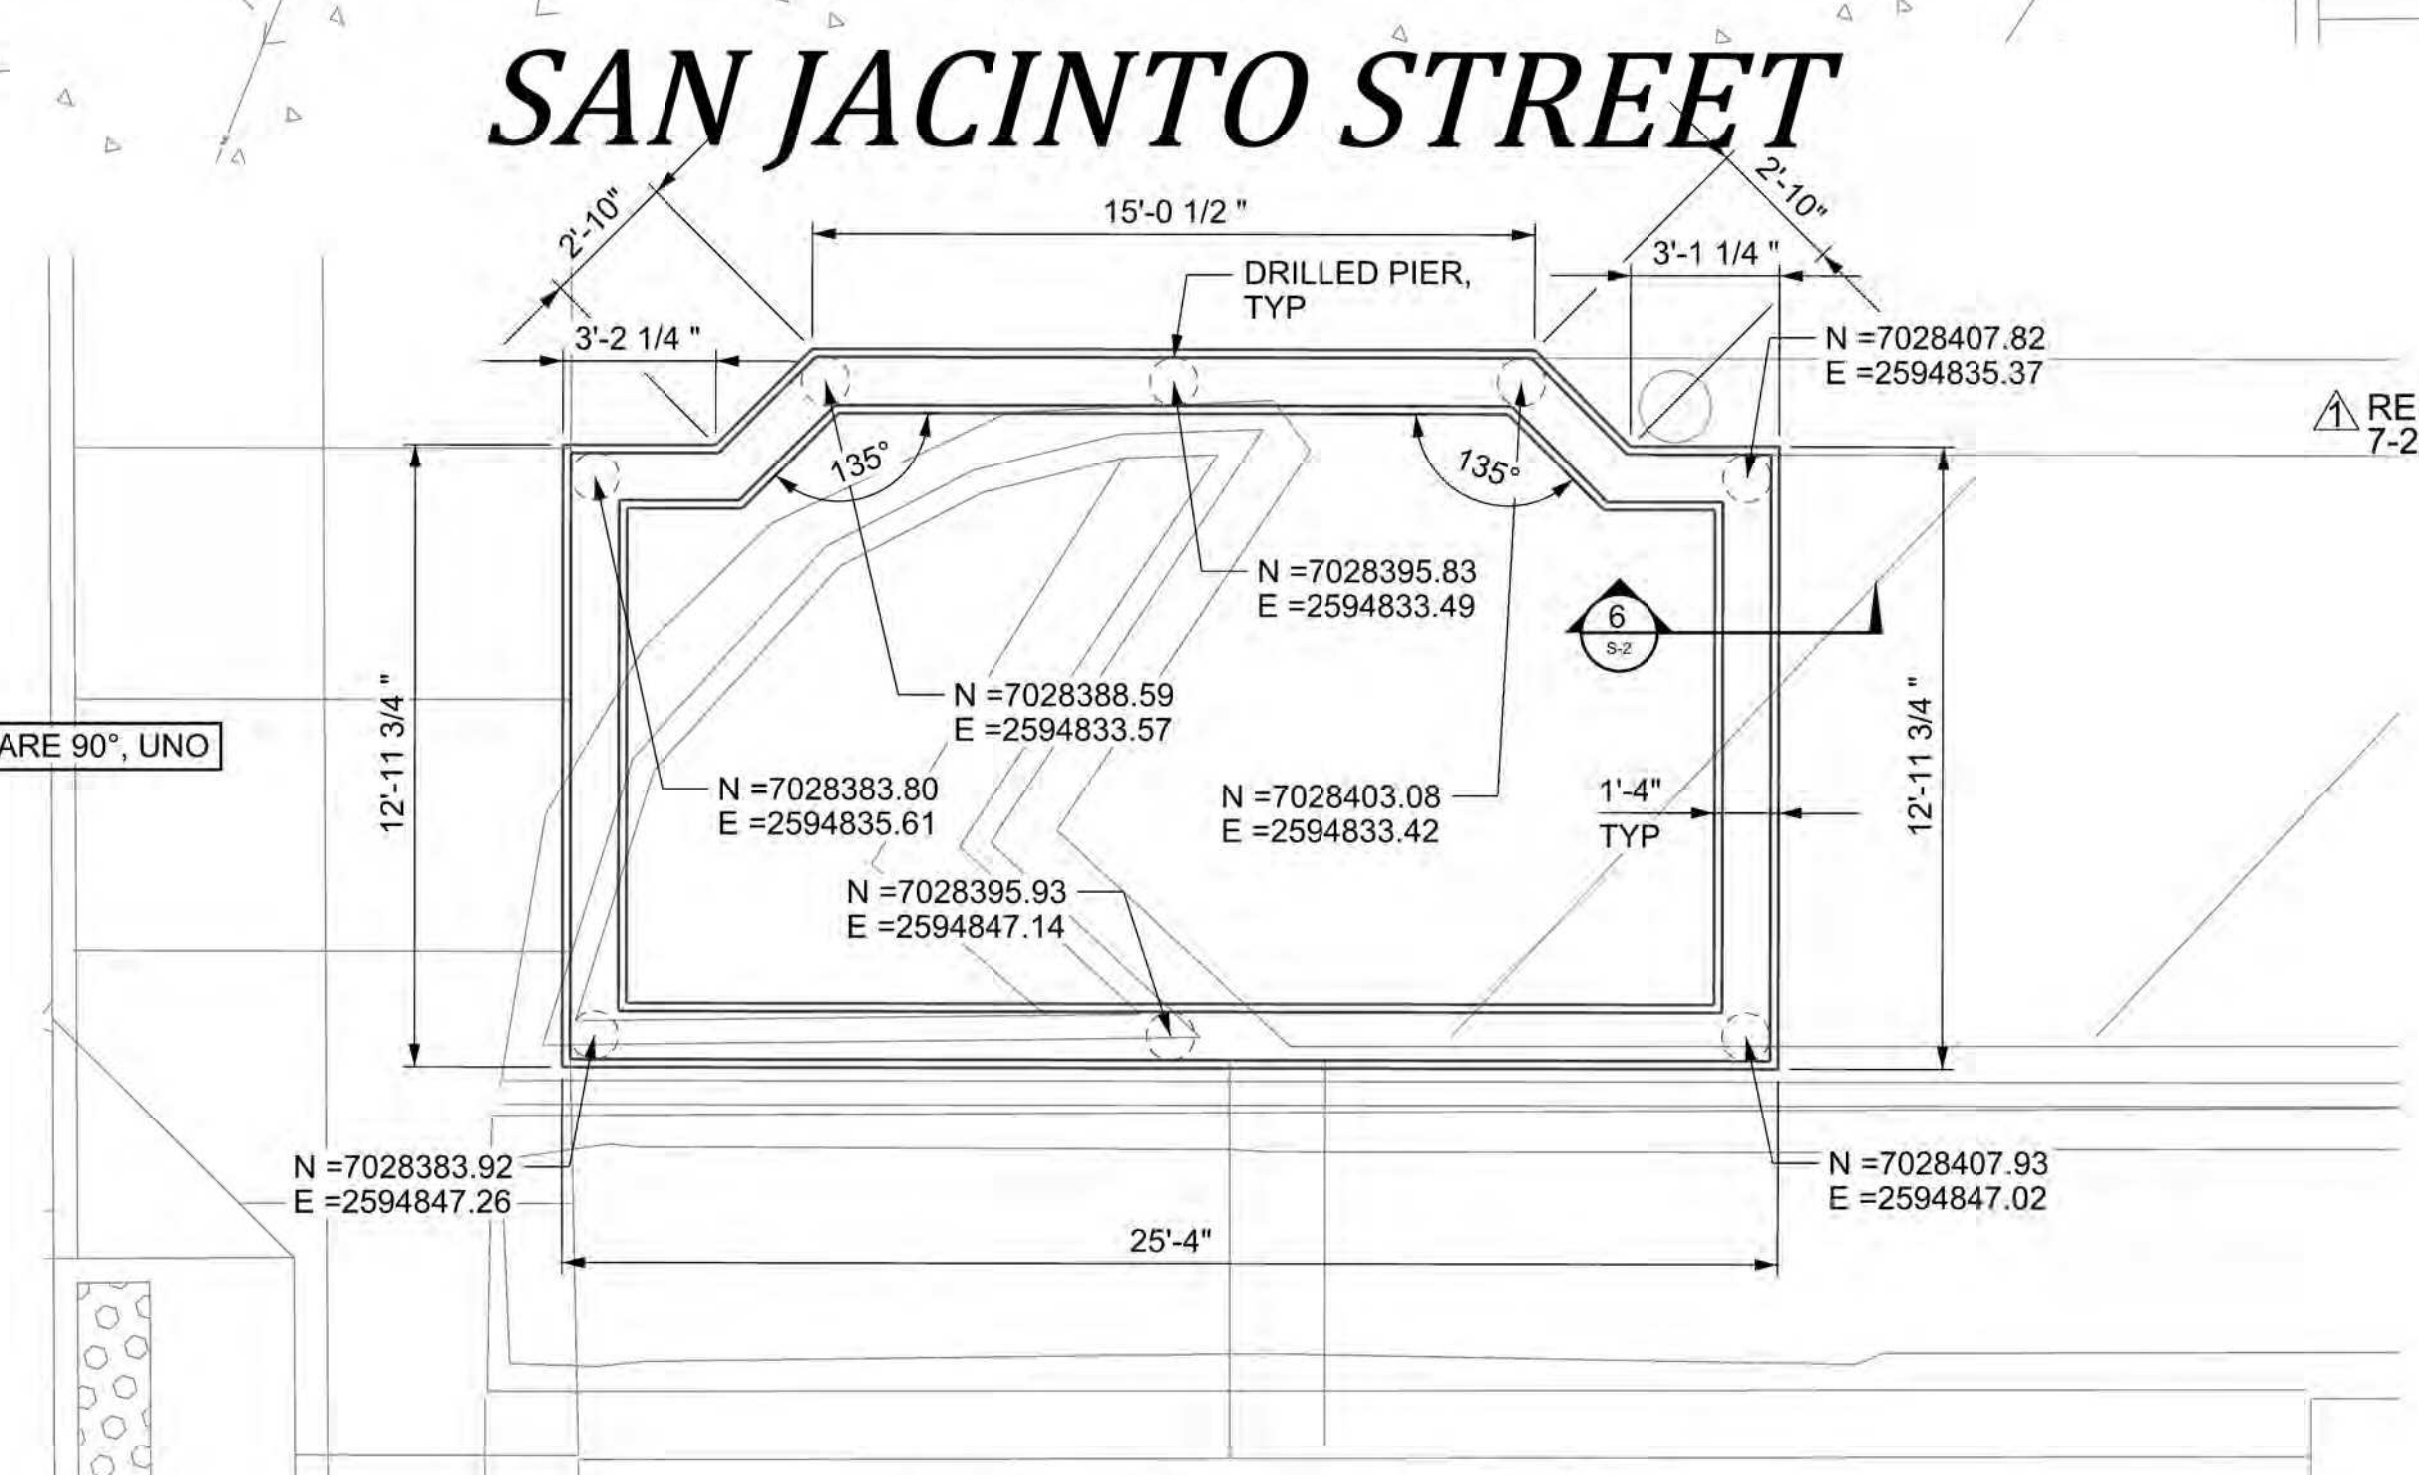

SAN JACINTO STREET

3 BRICK VENEER PLANTER SOUTHWEST
FP-3 SCALE: 1/4" = 1'-0"

PIERCE ENGINEERING
STRUCTURAL ENGINEERING

BUS.: (940) 937-8600 132 N. MAIN STREET
FIRM REG #: F-9186 CHILDRESS, TX 79201

submittals / revisions

no.	date	detail
1	7-22-14	RFI #109

REMOVED NOTE
7-22-14

la terra studio, inc.

12024
Its project number
4.15.2014
date
bgp
drawn by
bgp
checked by

registration



sheet title
RETAINING WALL PLAN
sheet number

FP-3