

PLANT AND MATERIALS LIST: NOTE: CONTRACTOR TO VERIFY QUANTITIES PER PLANS

CANOPY TREES

QNTY.	SYMBOL	COMMON NAME	BOTANIC NAME
	CP	CHINESE PISTACHE	PISTACHIA CHINENSIS

SHRUBS

QNTY.	SYMBOL	COMMON NAME	BOTANIC NAME
	MF	MEXICAN FEATHER GRASS	STIPA TENIOSSIMA
	RDR	RED DRIFT ROSE	ROSA 'MEIGALPIO'

GROUND COVER

QNTY.	SYMBOL	COMMON NAME	BOTANIC NAME
130	LIR MUS	LILY TURF	LIRIOPE MUSCARI


TURF

QNTY.	SYMBOL	COMMON NAME	BOTANIC NAME
	SSBG	SOLID SOD BERMUDA GRASS	Cynodon dactylon

EXISTING TREE

QNTY.	SYMBOL	NOTE
	PER PLAN	REFERENCE CIVIL DEMO PLANS FOR TREE PRESERVATION.

sheet location

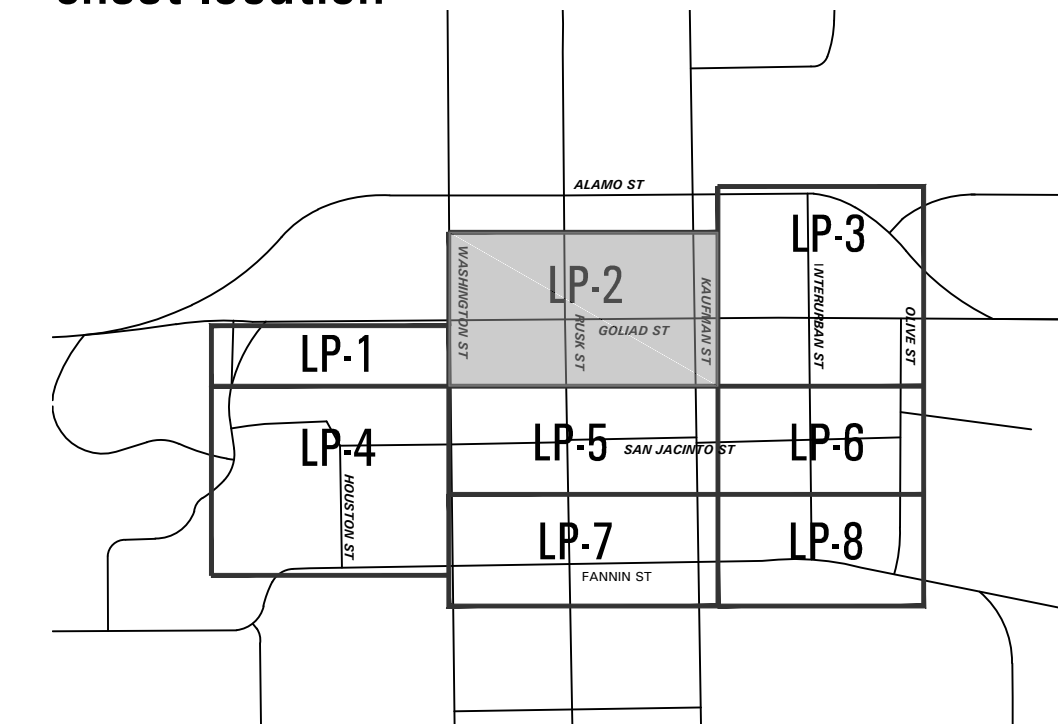

Downtown Rockwall
 la terra studio Project #12024
streetscape improvements
 PHASE 2
 rockwall, texas



submittals / revisions

no.	date	detail
▲	07/14/14	RFI #101
▲	07/29/14	RFI #114

la terra studio, inc.

12024
 Its project number
 02.26.2014
 date
 rac; bhm
 drawn by
 mtb
 checked by

registration



02.26.2014
 sheet title

Landscape Plan
 sheet number

LP-2