



LEGEND:

- PROJECT LIMIT LINE
- TYPICAL LIGHT FIXTURE

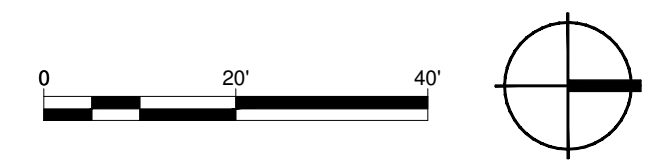

sheet location

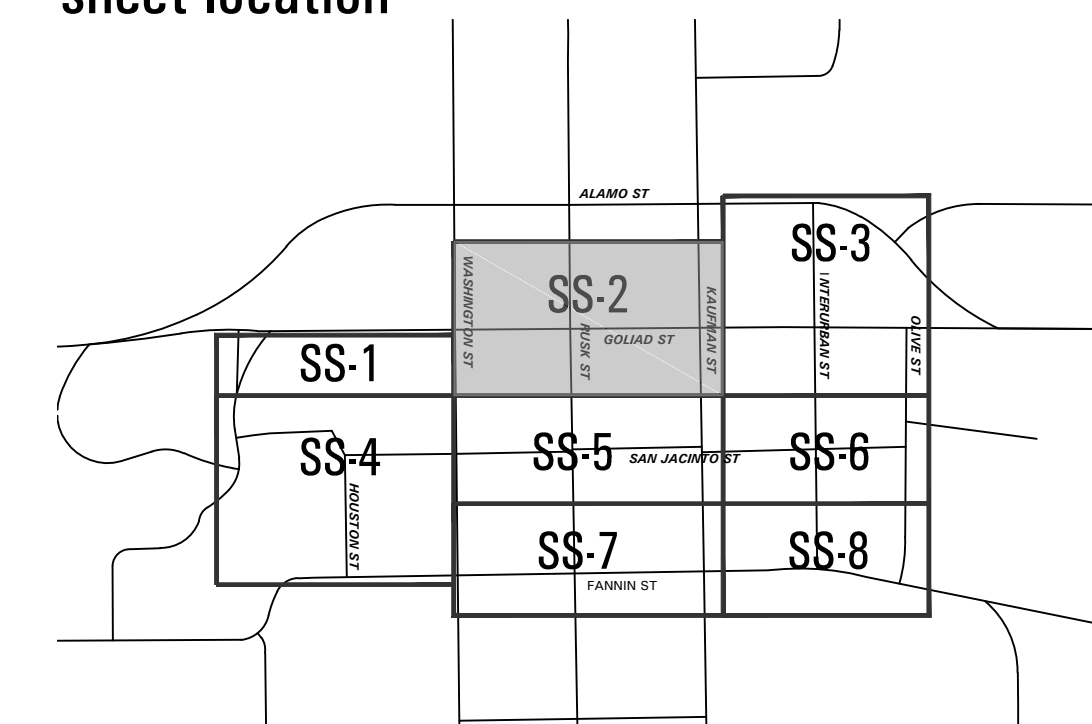


Downtown Rockwall
 la terra studio Project #12024
streetscape improvements
 PHASE 2
 rockwall, texas



submittals / revisions

no.	date	detail
▲	03/01/14	RFI #35
▲	09/23/14	RFI #115
▲	12/16/14	RFI #115

la terra studio, inc.
 12024
 its project number
 02.26.2014
 date
 rac; bhm
 drawn by
 mtb
 checked by

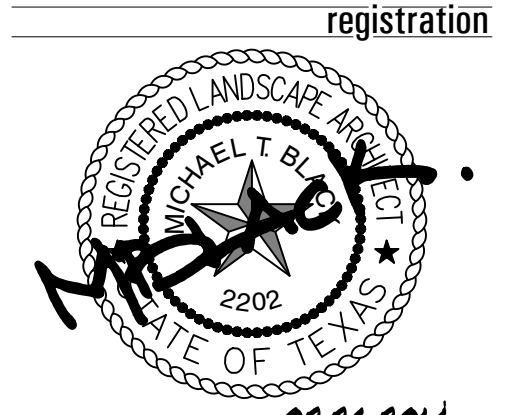

02.26.2014
 sheet title
Subsurface Drainage Plan
 sheet number
SS-2