



**LEGEND:**

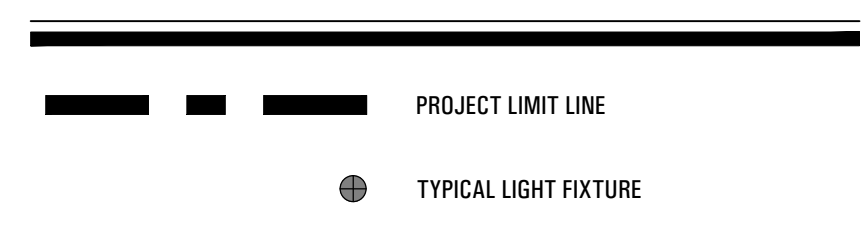

**sheet location**

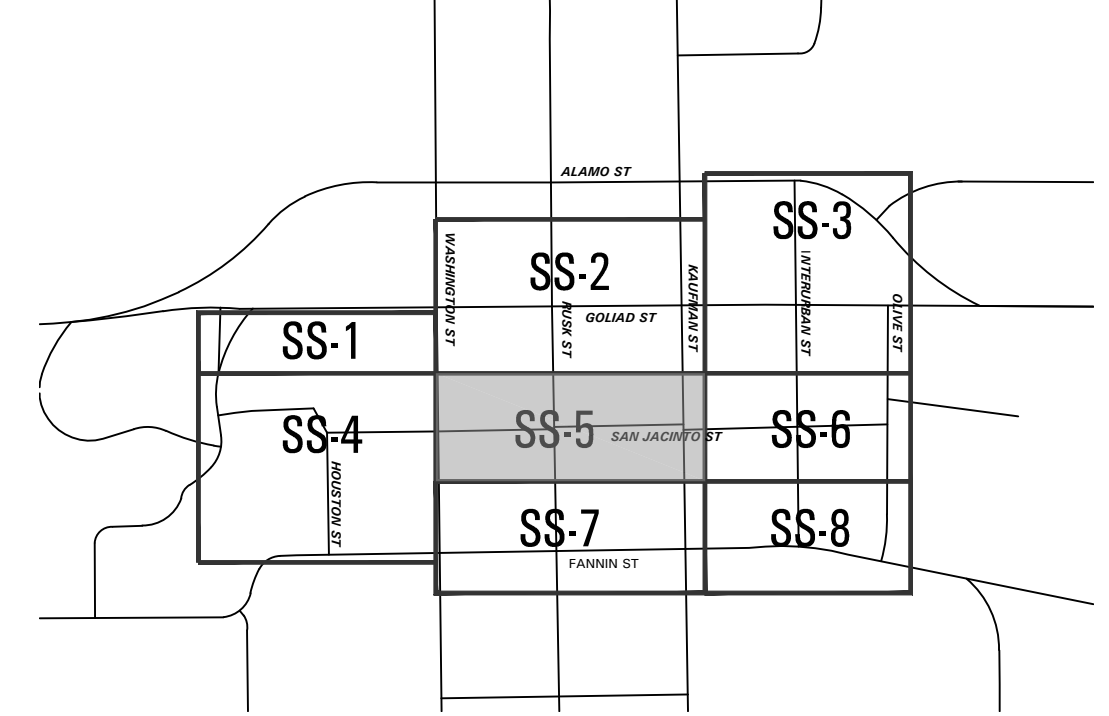

submittals / revisions

no.	date	detail
△	09/23/14	RFI #115
△	09/29/14	RFI #133
△	12/16/14	RFI #115

la terra studio, inc.  
 12024  
 lts project number  
 02.26.2014  
 date  
 rac; bhm  
 drawn by  
 mtb  
 checked by

registration

02.26.2014  
 sheet title  
**Subsurface Drainage Plan**  
 sheet number  
**SS-5**