


submittals / revisions

| no. | date | detail |
|-----|----------|----------|
| △ | 07/14/14 | RFI #101 |
| △ | 07/29/14 | RFI #112 |
| △ | 08/29/14 | RFI #120 |

la terra studio, inc.

12024
 Its project number
 02.26.2014
 date
 rac; bhm
 drawn by
 mtb
 checked by


registration

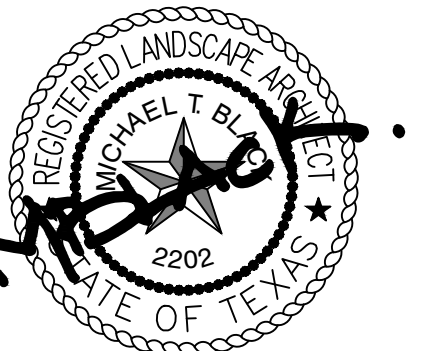

02.26.2014
 sheet title

Landscape Plan
 sheet number

LP-5

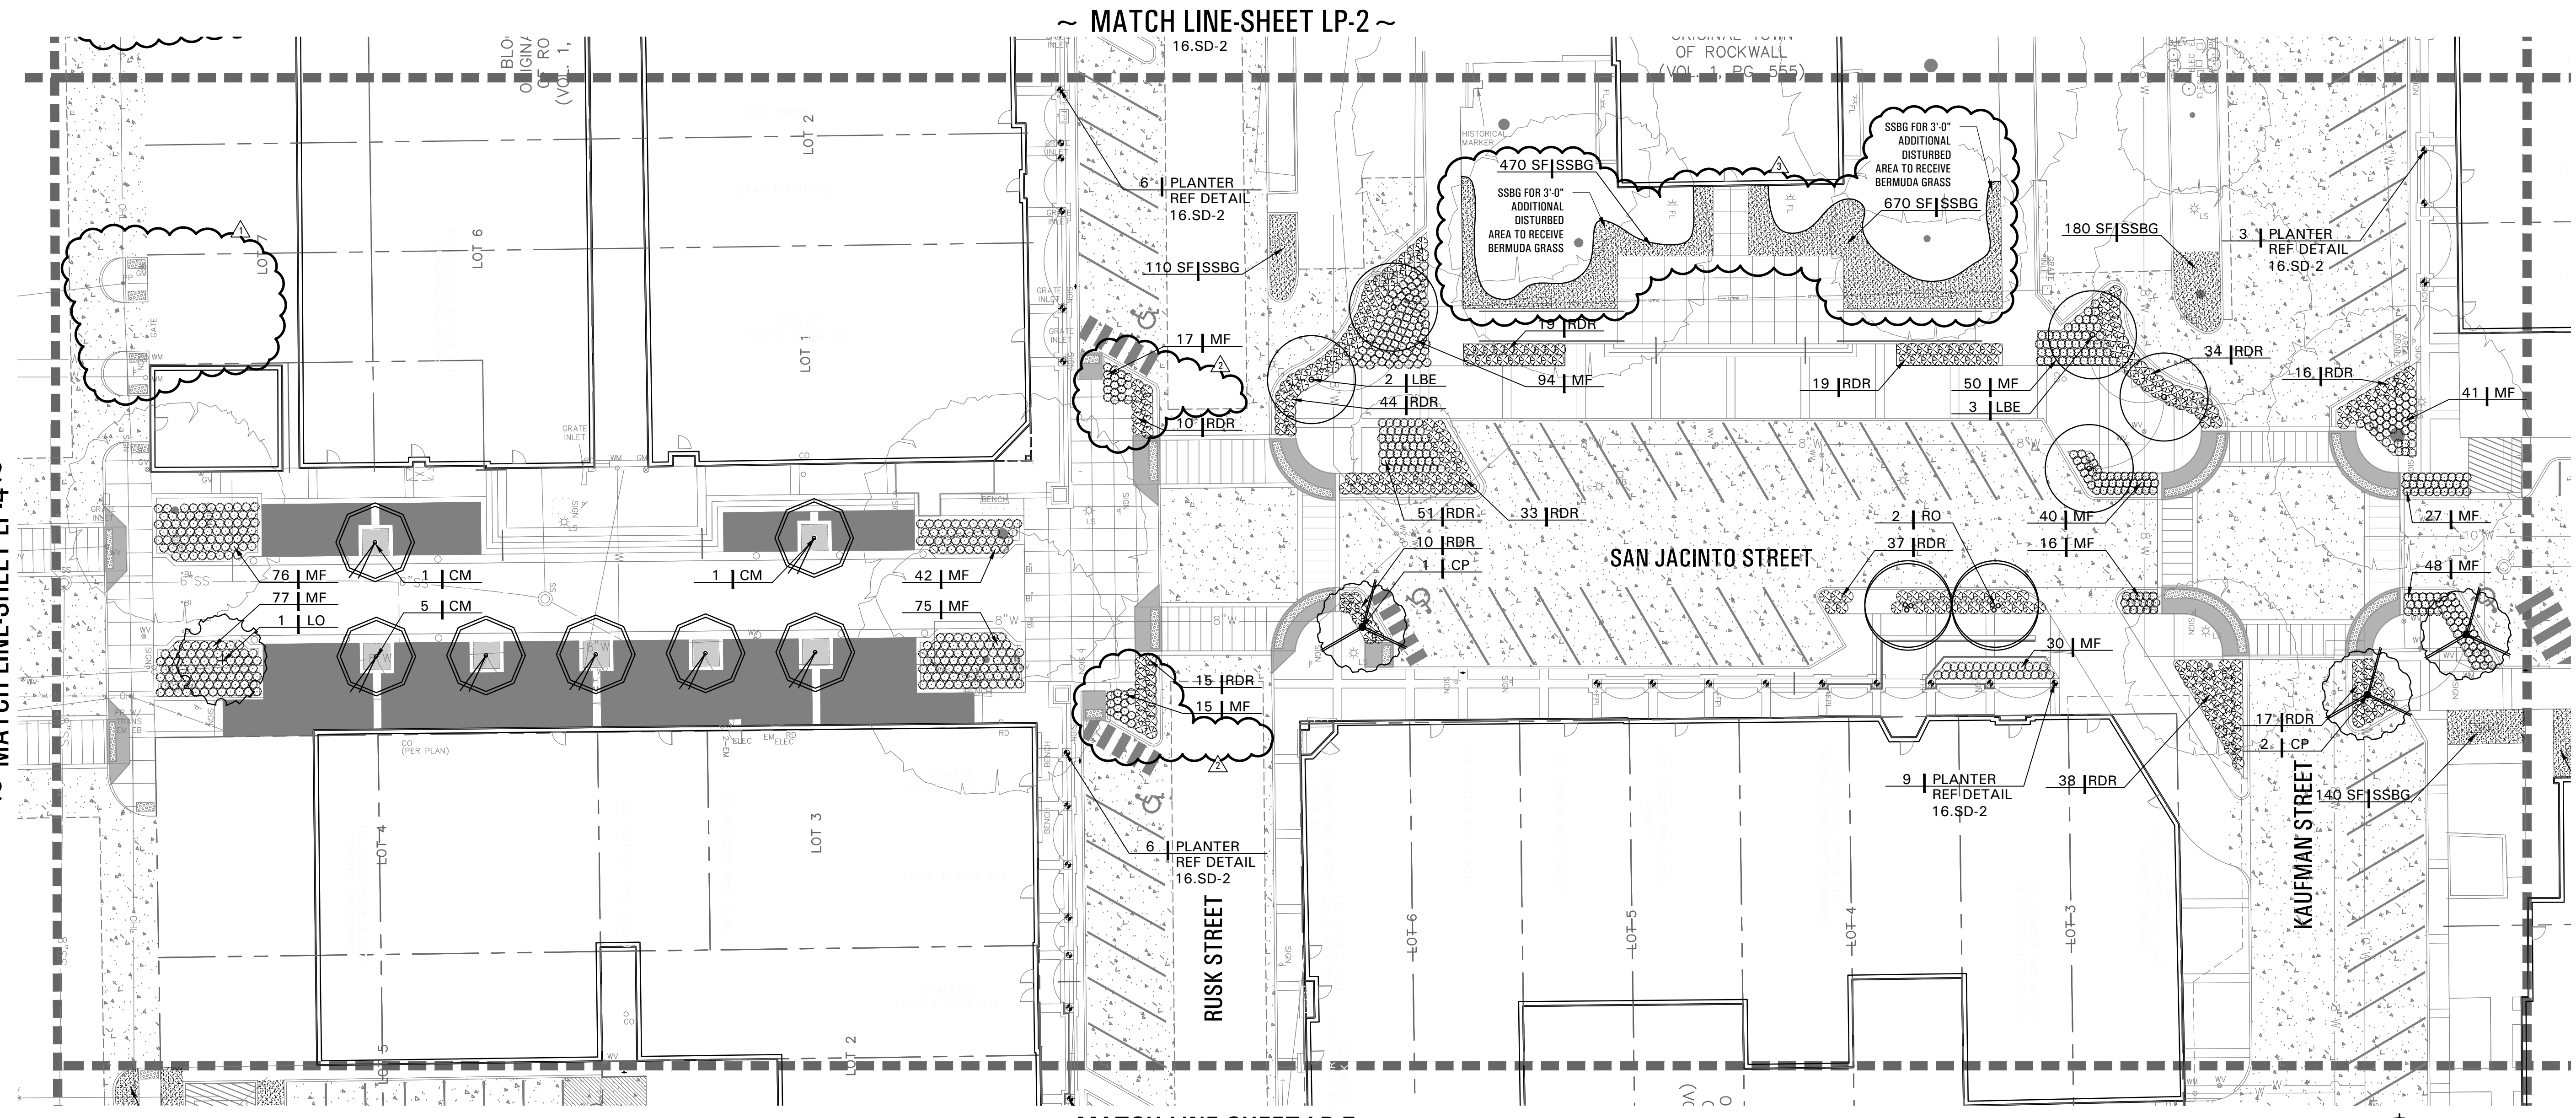

PLANT AND MATERIALS LIST: NOTE: CONTRACTOR TO VERIFY QUANTITIES PER PLANS

CANOPY TREES

| QNTY. | SYMBOL | COMMON NAME | BOTANIC NAME |
|-------|--------|------------------|------------------------|
| | CP | CHINESE PISTACHE | PISTACHIA CHINENSIS |
| | LO | LIVE OAK | QUERCUS VIRGINANA |
| | LBE | LACE BARK ELM | ULMUS PARVIFOLIA |
| | RO | RED OAK | QUERCUS SHUMARDI |
| | CM | CADDO MAPLE | ACER SACCHARUM 'CADDO' |

SHRUBS

| QNTY. | SYMBOL | COMMON NAME | BOTANIC NAME |
|-------|--------|-----------------------|------------------|
| | MF | MEXICAN FEATHER GRASS | STIPA TENIOSSIMA |
| | RDR | RED DRIFT ROSE | ROSA 'MEIGALPIO' |

TURF

| QNTY. | SYMBOL | COMMON NAME | BOTANIC NAME |
|-------|--------|-------------------------|------------------|
| | SSBG | SOLID SOD BERMUDA GRASS | Cynodon dactylon |

EXISTING TREE

| QNTY. | SYMBOL | NOTE |
|-------|--------|--|
| | | PER PLAN REFERENCE CIVIL DEMO PLANS FOR TREE PRESERVATION. |

sheet location

