


© 2013 la terra studio, inc. All Rights Reserved FILE:R:\12024-Downtown Rockwall PS&E - Rockwall\CAD\12024\_LP1-7.dwg



**PLANT AND MATERIALS LIST:** NOTE: CONTRACTOR TO VERIFY QUANTITIES PER PLANS

CANOPY TREES			
QNTY.	SYMBOL	COMMON NAME	BOTANIC NAME
	CP	CHINESE PISTACHE	PISTACHIA CHINENSIS
	LO	LIVE OAK	QUERCUS VIRGINANA
	LBE	LACE BARK ELM	ULMUS PARVIFOLIA
	RO	RED OAK	QUERCUS SHUMARDI
	CM	CADDO MAPLE	ACER SACCHARUM 'CADD0'


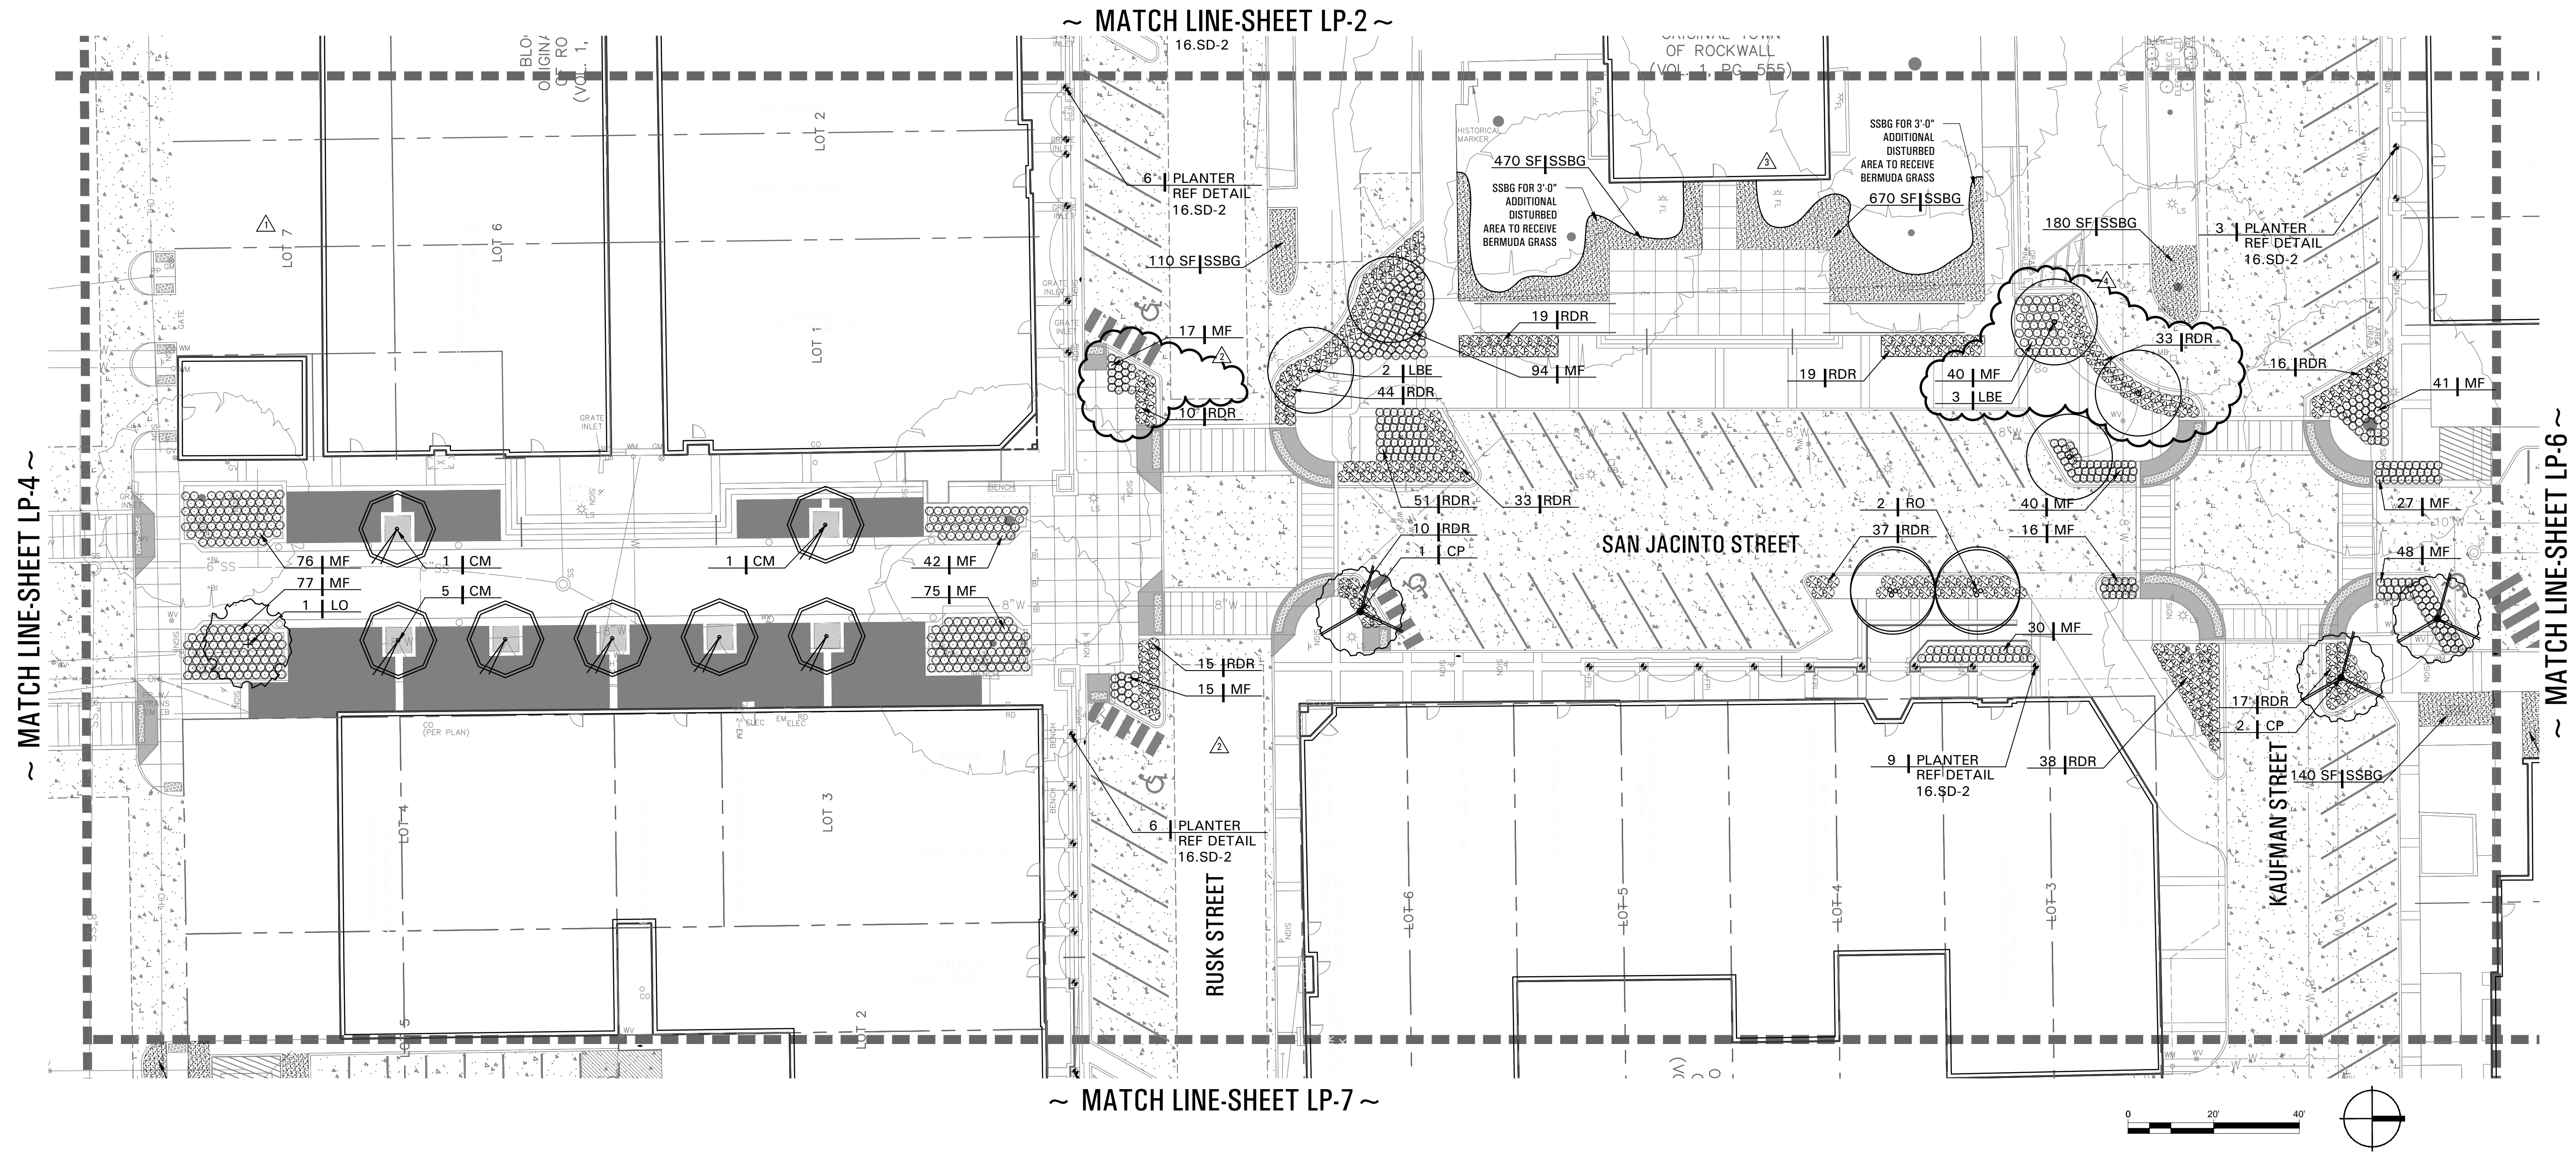
  

SHRUBS			
QNTY.	SYMBOL	COMMON NAME	BOTANIC NAME
	MF	MEXICAN FEATHER GRASS	STIPA TENIOSSIMA
	RDR	RED DRIFT ROSE	ROSA 'MEIGALPIO'

TURF			
QNTY.	SYMBOL	COMMON NAME	BOTANIC NAME
	SSBG	SOLID SOD BERMUDA GRASS	Cynodon dactylon

EXISTING TREE		
QNTY.	SYMBOL	NOTE
		PER PLAN REFERENCE CIVIL DEMO PLANS FOR TREE PRESERVATION.

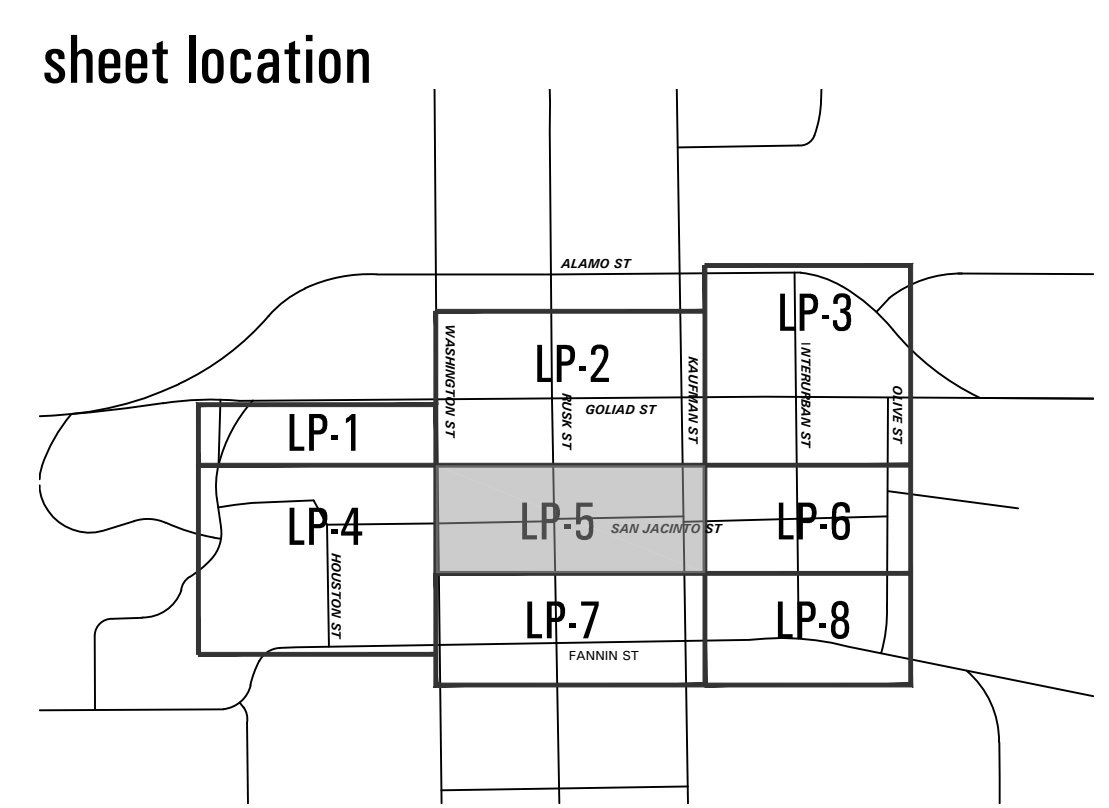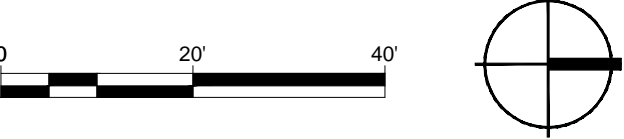

submittals / revisions

no.	date	detail
△	07/14/14	RFI #101
△	07/29/14	RFI #112
△	08/29/14	RFI #120
△	09/16/14	RFI #121, #125

la terra studio, inc.  
 12024  
 Its project number  
 02.26.2014  
 date  
 rac; bhm  
 drawn by  
 mtb  
 checked by  
 registration