



DEMOLITION LEGEND:

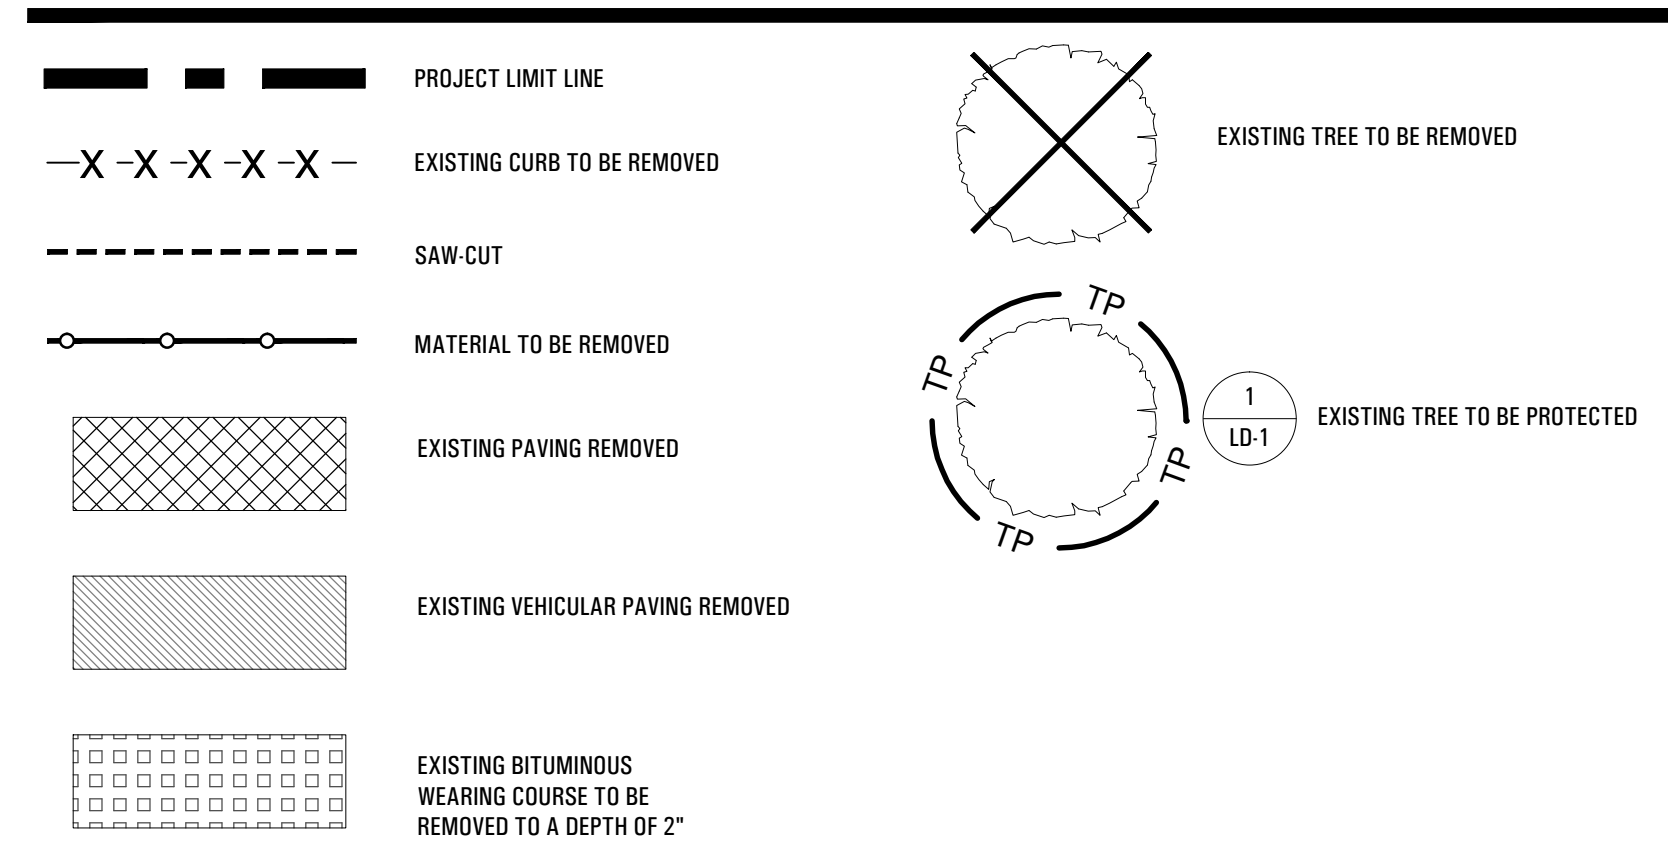

sheet location

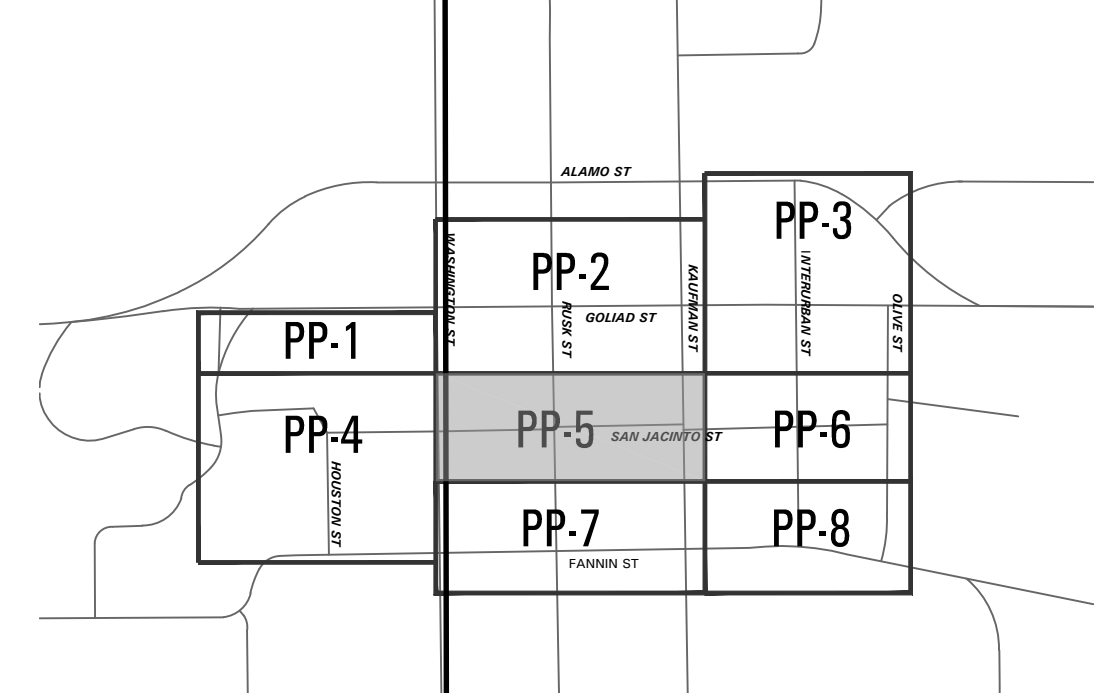

Call 1.800.DIG-TESS 2 Working Days BEFORE You Dig!
 www.digess.org **Dig Safely**
 SHEET NOTES



submittals / revisions

no.	date	detail
△	06/25/14	RFI #99
△	09/16/14	RFI #121

la terra studio, inc.
 12024
 Its project number
 02.26.2014
 date
 rac; bhm
 drawn by
 mtb
 checked by

