


**GRADING PLAN LEGEND:**

	PHASE 1 PROJECT LIMIT LINE
	EXISTING GRADE CONTOUR
	FINISH GRADE CONTOUR
	FINISH SPOT GRADE
	SEE CIVIL FOR CROSS REFERENCE OF PROPOSED ELEVATION
	TOP STEP
	BOTTOM STEP
	TOP OF WALL
	BOTTOM OF WALL
	TOP OF CURB
	GUTTER
	FINISH FLOOR
	TOP OF COLUMN

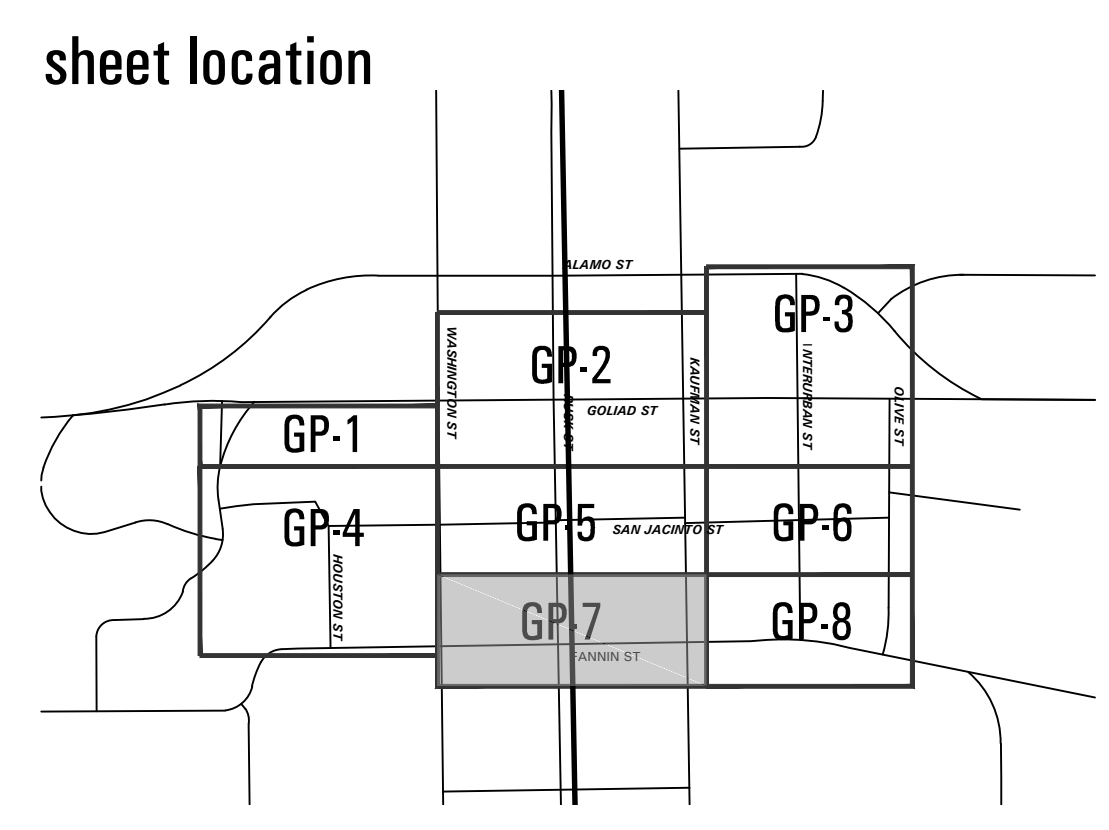

**Downtown Rockwall**  
 la terra studio Project #12024  
**streetscape improvements**  
 PHASE 2  
 rockwall, texas

submittals / revisions

no.	date	detail
△	05/08/14	RFI #20, #42, #43, #54
△	05/16/14	RFI #37
△	07/15/14	RFI #108
△	09/09/14	RFI #123

la terra studio, inc.

12024  
 its project number  
 02.26.2014  
 date  
 rac; bhm  
 drawn by  
 mtb  
 checked by

registration

02.26.2014  
 sheet title