

Pacheco Koch

DALLAS & FORT WORTH & HOUSTON




00

22

improvements

streetscape PHASE 2

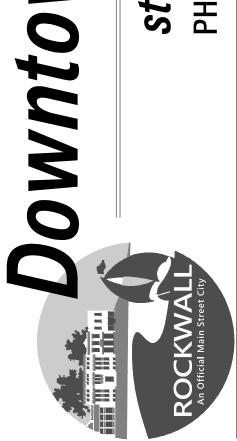

no. date detail

<u>1</u> 06/17/14 RFI #97 2 09/30/14 RFI #123

la terra studio, inc.

12024 Its project number 02.26.2014

rac; bhm drawn by

mtb checked by

registration



Site Details