


© 2013 la terra studio, inc. All Rights Reserved FILE:P:\12024-Downtown Rockwall PSS&E - Rockwall\CAD\SSHEETS\12024_Enlargement_Plan_key.dwg

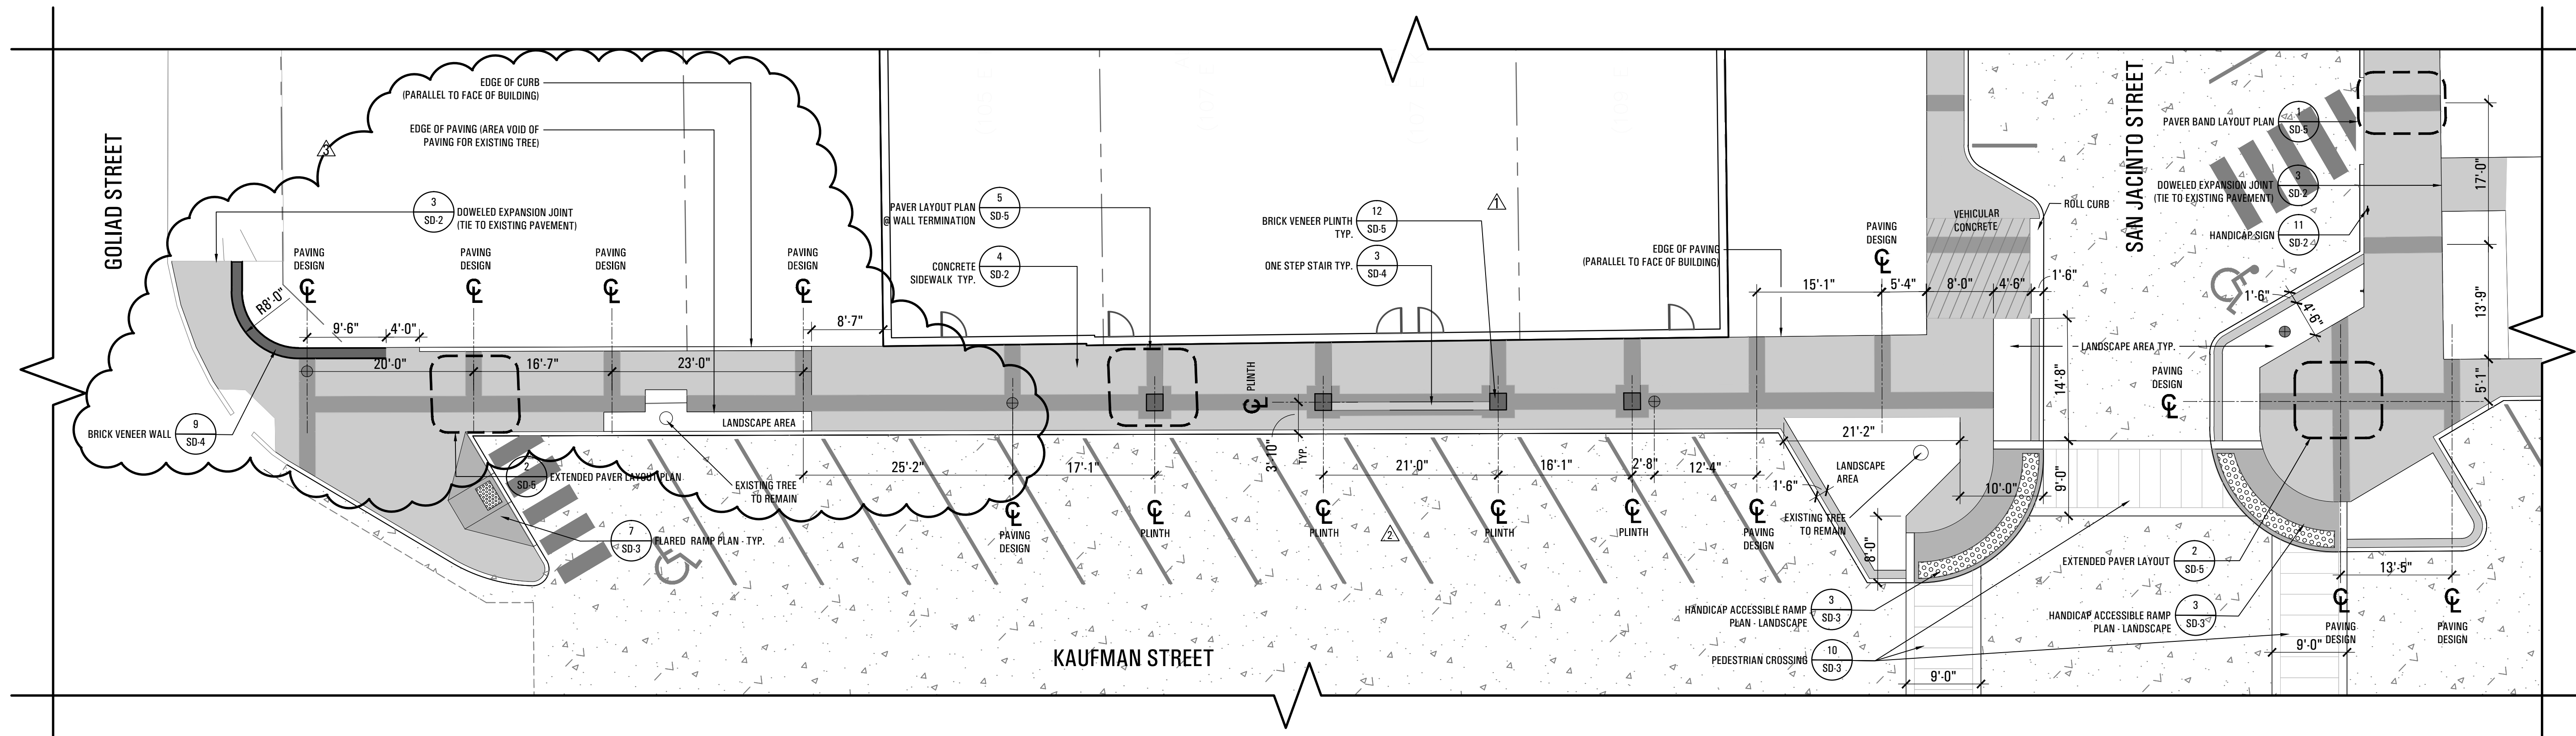

1 ENLARGEMENT PLAN
SCALE: 1" = 10'-0"

SITE PLAN LEGEND:

	EDGE OF PAVEMENT
	CONCRETE SIDEWALK PAVEMENT
	CONCRETE VEHICULAR PAVEMENT
	TYPICAL LIGHT FIXTURE



submittals / revisions

no.	date	detail
△	07/25/14	RFI #104
△	07/25/14	RFI #104
△	09/10/14	RFI #124

la terra studio, inc.
12024
its project number
02.26.2014
date
rac; bhm
drawn by
mtb
checked by

