


**GRADING PLAN LEGEND:**

- 580 ——— EXISTING GRADE CONTOUR
- 581 ——— FINISH GRADE CONTOUR
- 587.25 ● FINISH SPOT GRADE
- 580.00 ——— SEE CIVIL FOR CROSS REFERENCE OF PROPOSED ELEVATION
- TS TOP STEP
- BS BOTTOM STEP
- TW TOP OF WALL
- BW BOTTOM OF WALL
- TC TOP OF CURB
- G GUTTER
- FF FINISH FLOOR
- TCOL TOP OF COLUMN

**sheet location**

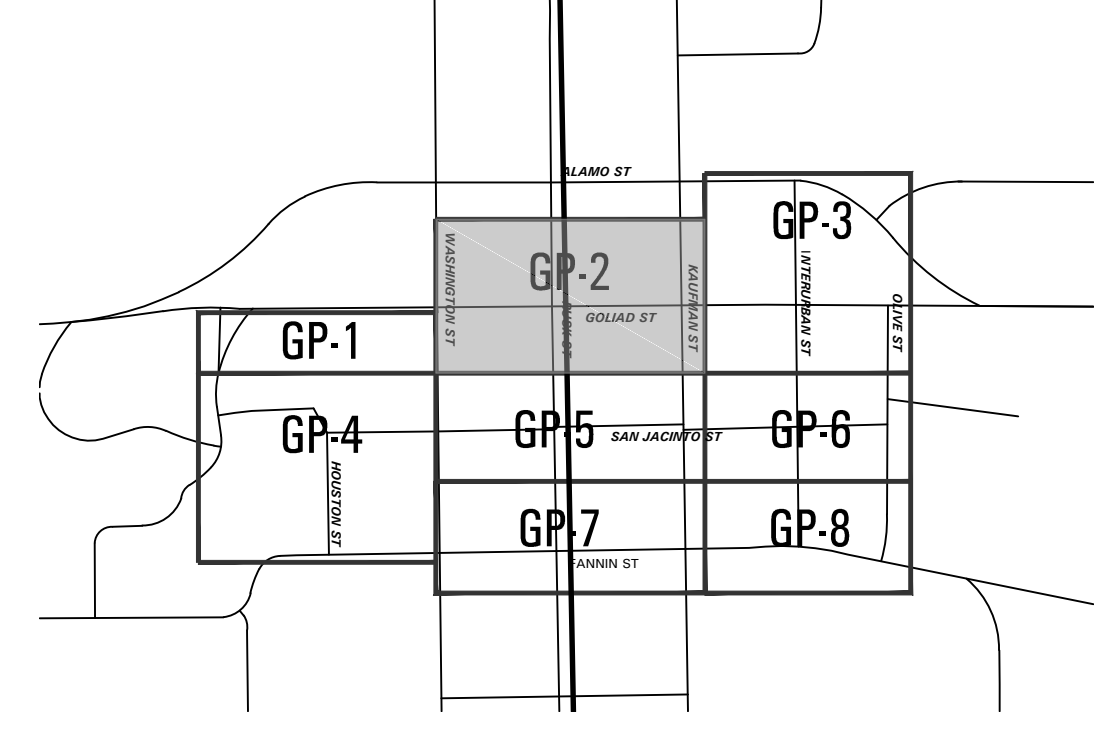

**Downtown Rockwall**  
 la terra studio Project #12024  
**streetscape improvements**  
 PHASE 2  
 rockwall, texas



submittals / revisions

no.	date	detail
▲	04/11/14	RFI #39,56
▲	05/02/14	RFI #77 WEST RUSK GRADING
▲	06/17/14	RFI #93
▲	07/11/14	LASI #7
▲	07/25/14	RFI #104
▲	09/10/14	RFI #124

la terra studio, inc.

12024  
 Its project number  
 02.26.2014  
 date  
 rac; bhm  
 drawn by  
 mtb  
 checked by



**Grading Plan**  
 sheet number  
**GP-2**