



la terra studio™

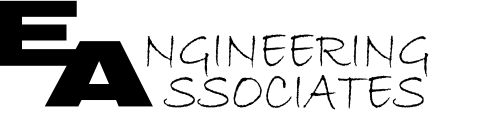

Downtown Rockwall
 la terra studio Project #12024
streetscape improvements
 PHASE 2
 rockwall, texas

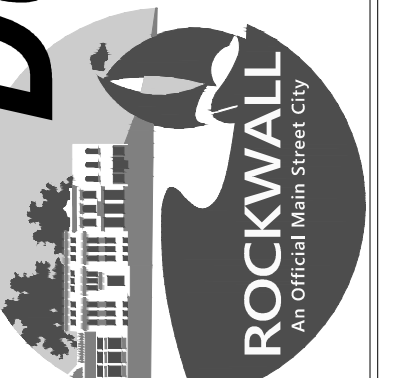

submittals / revisions

no.	date	detail
▲	10/09/14	RFI #130

la terra studio, inc.

12024
 its project number
 02.26.2014
 date
 rac; bhm
 drawn by
 mtb
 checked by


registration



Landscape Plan
 sheet number

LP-4

~ MATCH LINE-SHEET LP-1 ~

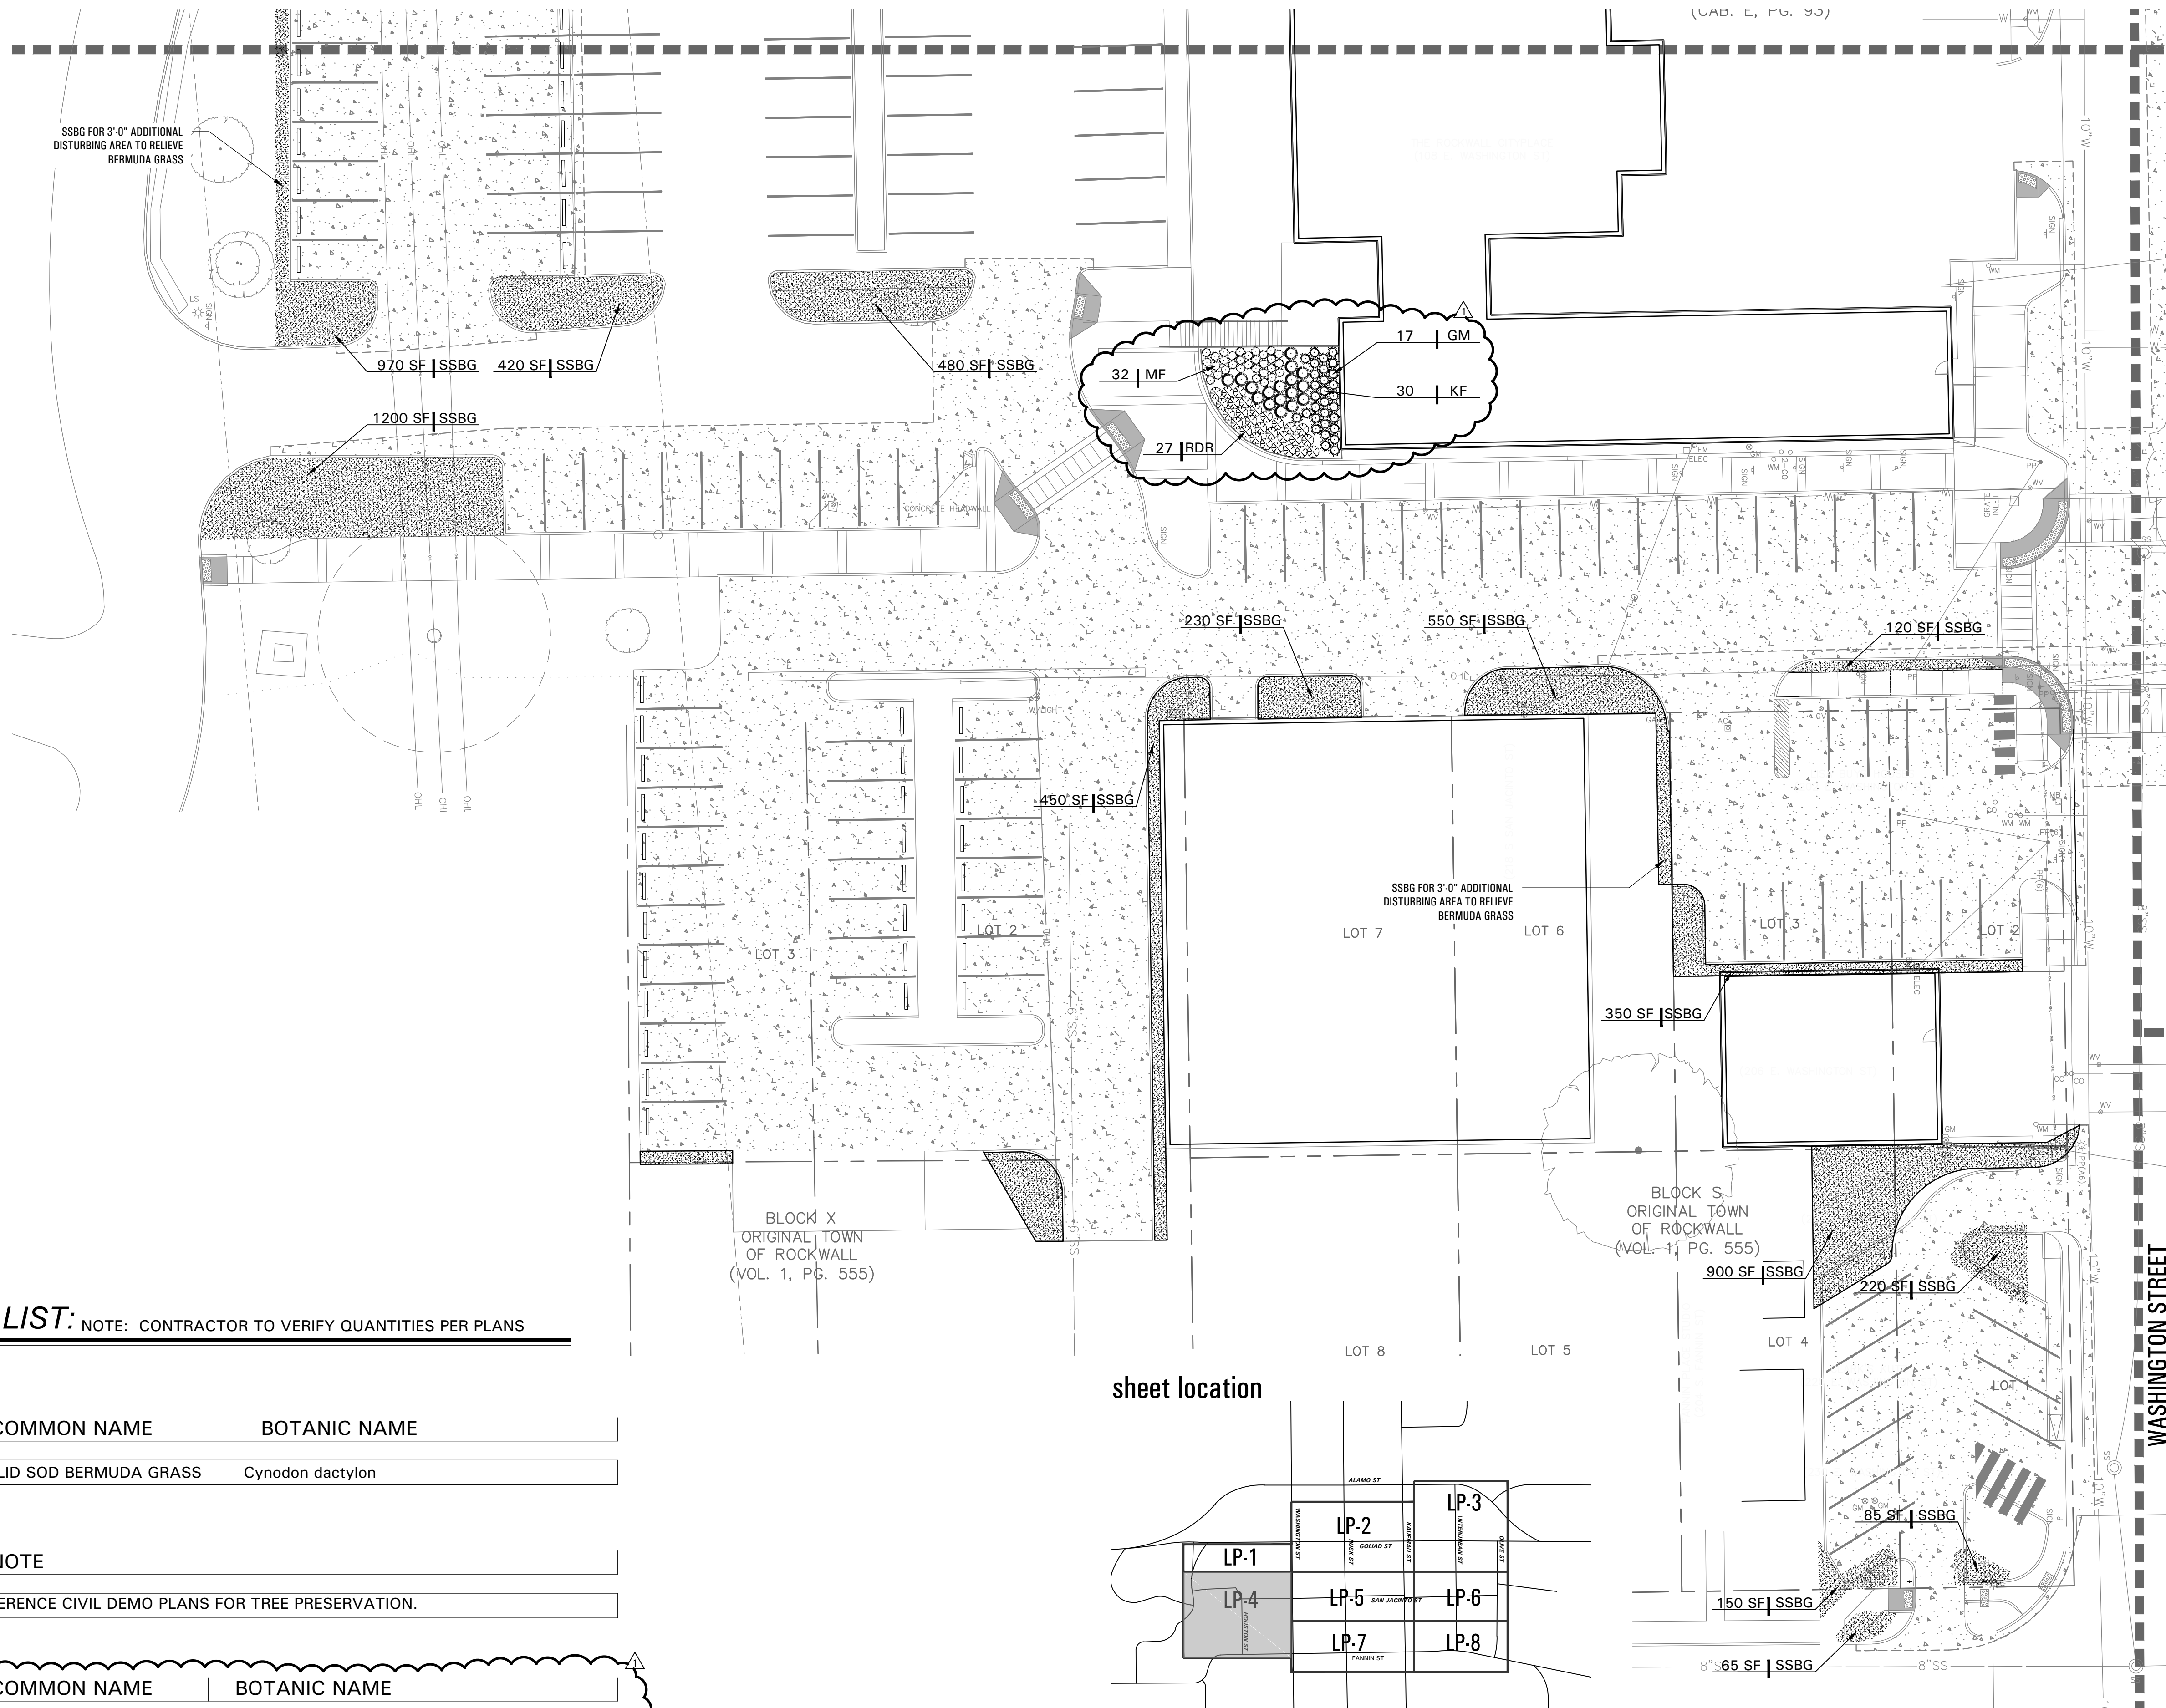

~ MATCH LINE-SHEET LP-5 ~

~ MATCH LINE-SHEET LP-7 ~

PLANT AND MATERIALS LIST: NOTE: CONTRACTOR TO VERIFY QUANTITIES PER PLANS

TURF

QNTY.	SYMBOL	COMMON NAME	BOTANIC NAME
	SSBG	SOLID SOD BERMUDA GRASS	Cynodon dactylon

EXISTING TREE

QNTY.	SYMBOL	NOTE
	PER PLAN	REFERENCE CIVIL DEMO PLANS FOR TREE PRESERVATION.

SHRUBS

QNTY.	SYMBOL	COMMON NAME	BOTANIC NAME
	GM	GULF MUHLY	MUHLENBERGIA CAPILLARIS
	KF	KARL FOERSTER REED GRASS	CALAMAGROSTIS x ACUTIFORA 'KARL FOERSTER'
	MF	MEXICAN FEATHER GRASS	STIPA TENIOSSIMA
	RDR	RED DRIFT ROSE	ROSA 'MEIGALPIO'

sheet location

