

~ MATCH LINE-SHEET SP-1 ~


~ MATCH LINE-SHEET SP-5 ~

~ MATCH LINE-SHEET SP-7 ~

SITE PLAN LEGEND:

- PHASE 1 PROJECT LIMIT LINE
- EDGE OF PAVEMENT
- CONCRETE SIDEWALK PAVEMENT
- CONCRETE VEHICULAR PAVEMENT
- TYPICAL LIGHT FIXTURE

sheet location

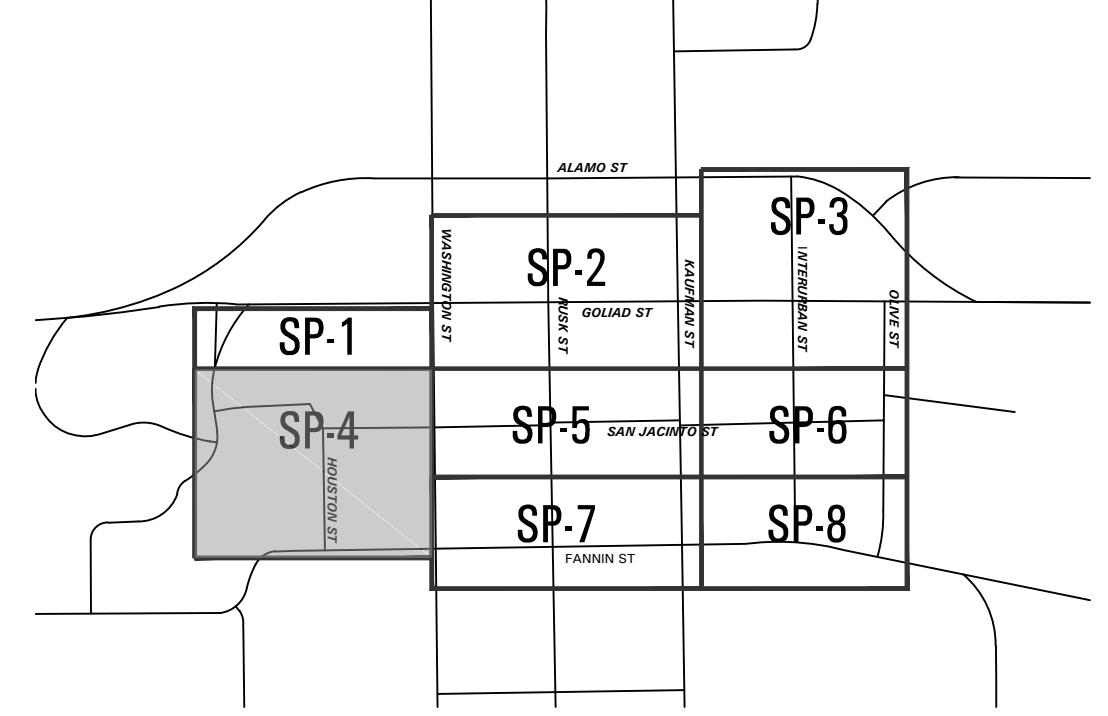

Downtown Rockwall
 la terra studio Project #12024
streetscape improvements
 PHASE 2
 rockwall, texas



submittals / revisions

no.	date	detail
1	03/25/14	RF# 25 (FOR CITY APPROVAL)
2	04/11/14	RF# 72
3	10/09/14	RF# 130

la terra studio, inc.
 12024
 Its project number
 02.26.2014
 date
 rac; bhm
 drawn by
 mtb
 checked by

