




© 2013 la terra studio, inc. All Rights Reserved FILE:R:\12024-Downtown Rockwall PS&E - Rockwall\CAD\Sheet\12024_Enlargement_Plan_key.dwg

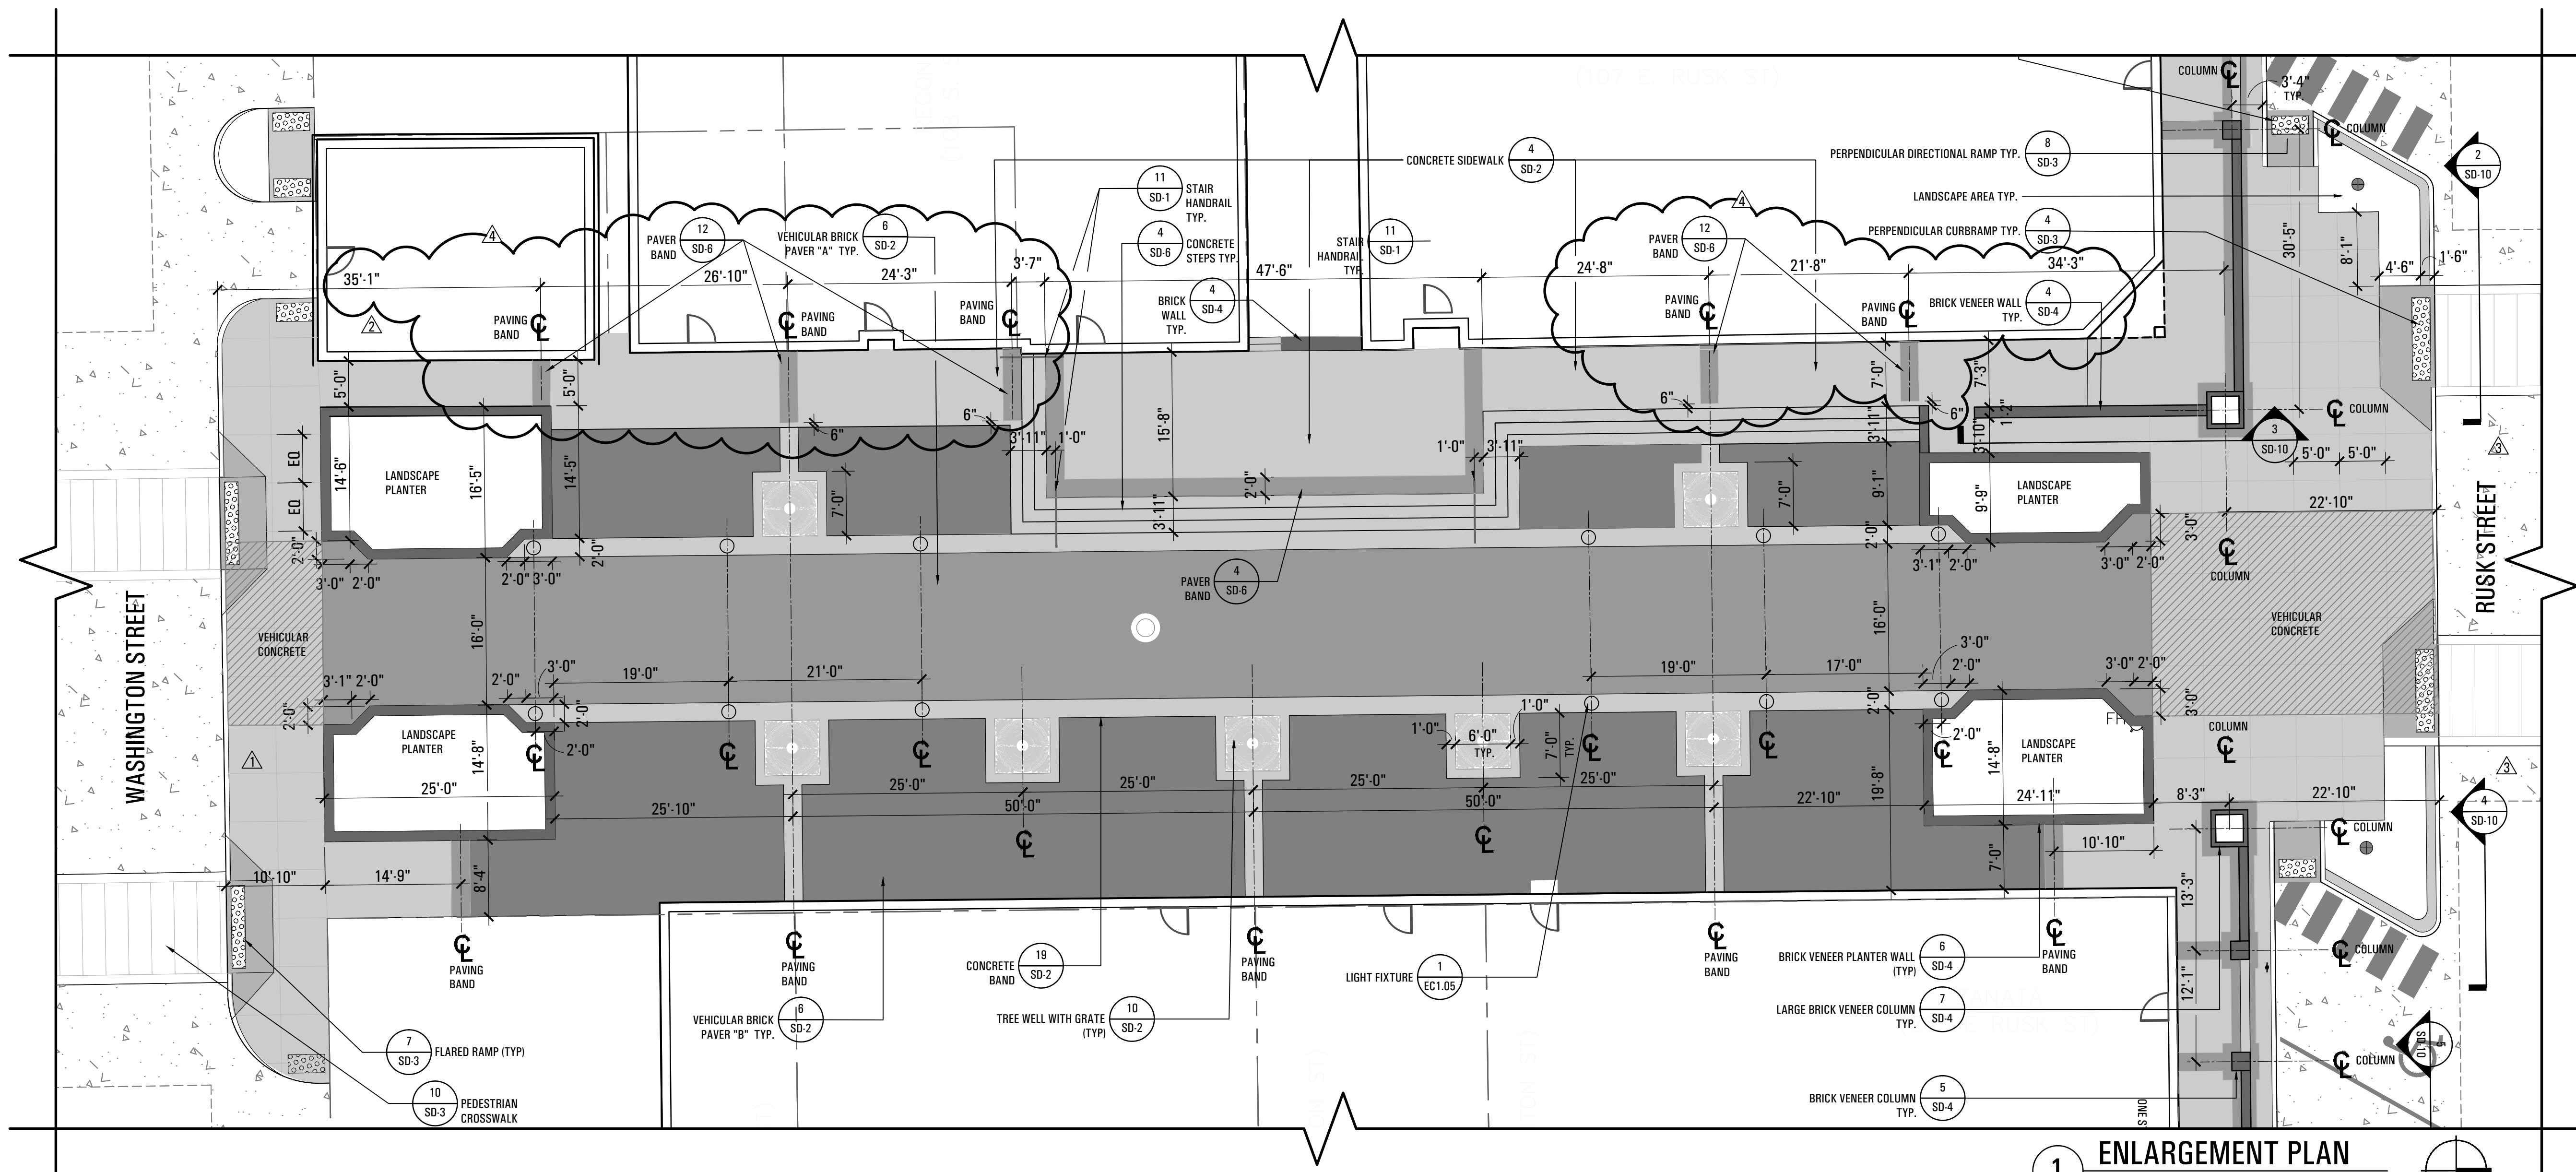

1 ENLARGEMENT PLAN
SCALE: 1" = 10'-0"

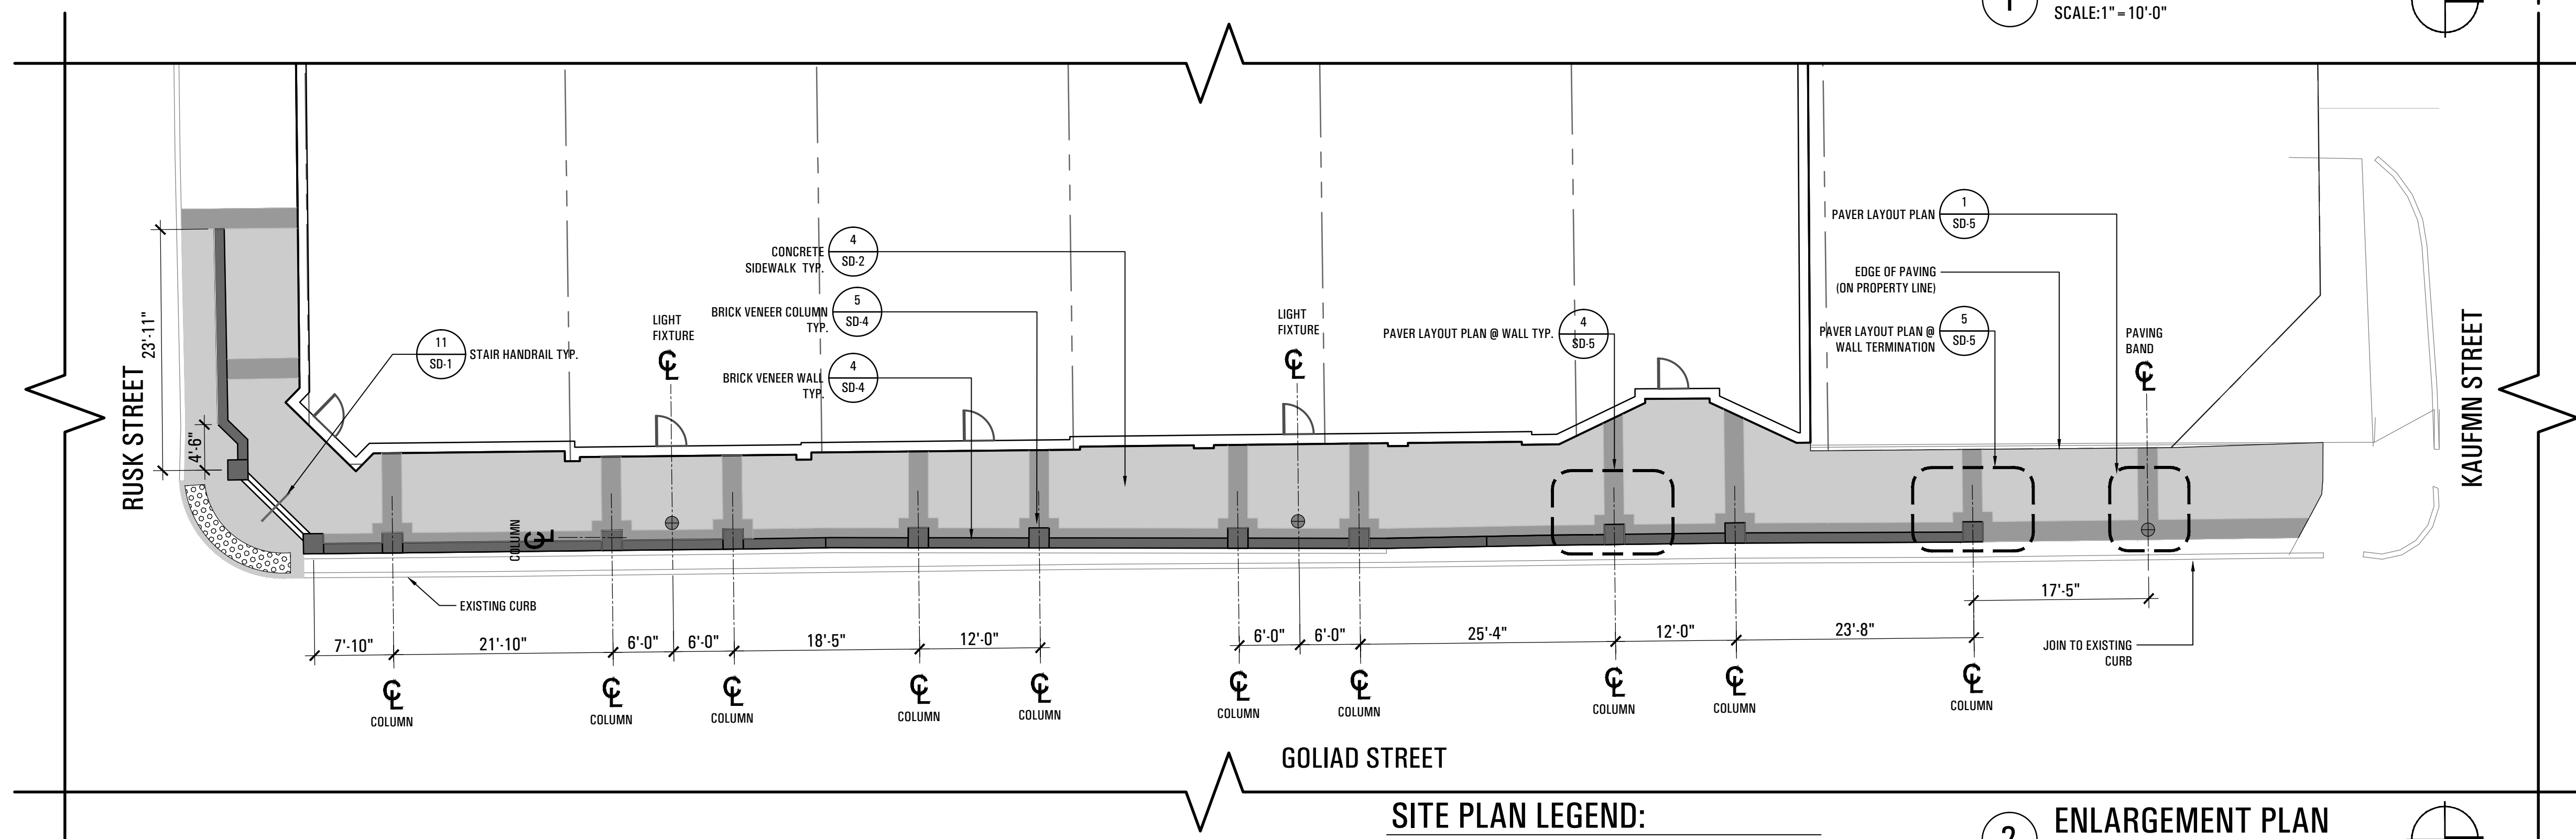

2 ENLARGEMENT PLAN
SCALE: 1" = 10'-0"

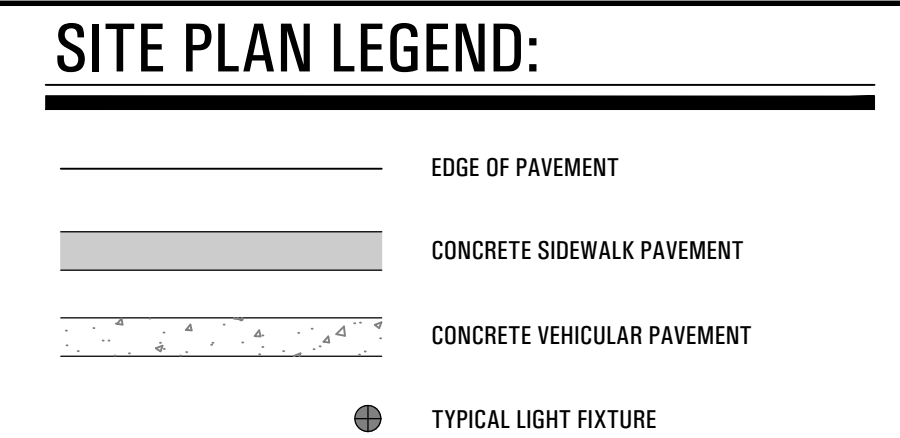

Downtown Rockwall
 la terra studio Project #12024
streetscape improvements
 PHASE 2
 rockwall, texas



submittals / revisions

no.	date	detail
▲	05/13/14	RFI #71
▲	08/14/14	LASI #9
▲	07/31/14	LASI #10
▲	09/26/14	RFI #131

la terra studio, inc.
 12024
 its project number
 02.26.2014
 date
 rac; bhm
 drawn by
 mtb
 checked by

