



submittals / revisions












no.	date	detail
△	04/24/14	RFI #79
△	05/08/14	RFI #38
△	07/18/14	RFI #105
△	08/12/14	RFI #117
△	08/12/14	LASI #11
△	09/16/14	LASI #121, #125
△	09/26/14	LASI #131

la terra studio, inc.

12024
 its project number
 02.26.2014
 date
 rac; bhm
 drawn by
 mtb
 checked by



Site Details
 sheet number
SD-6

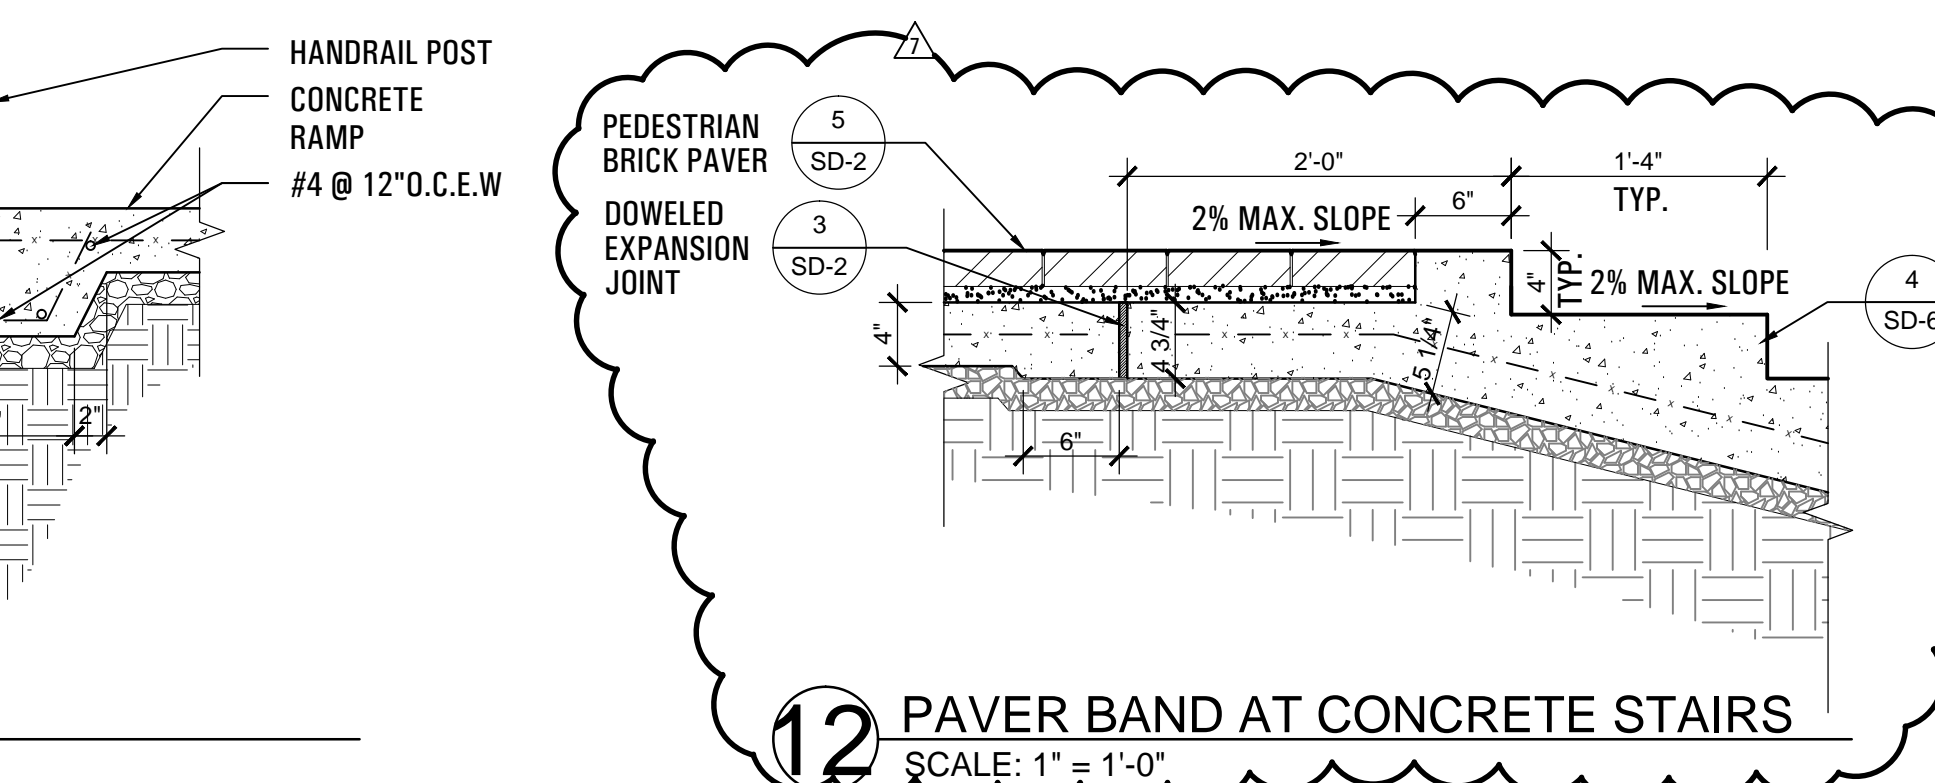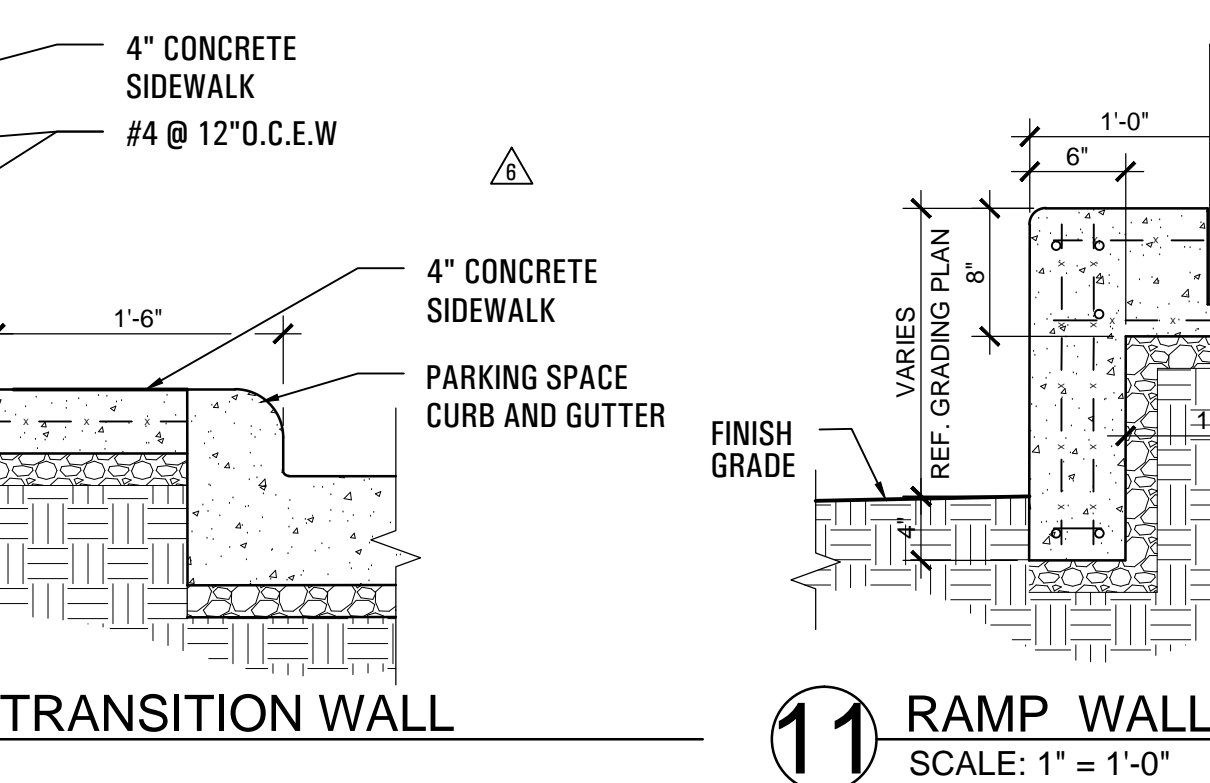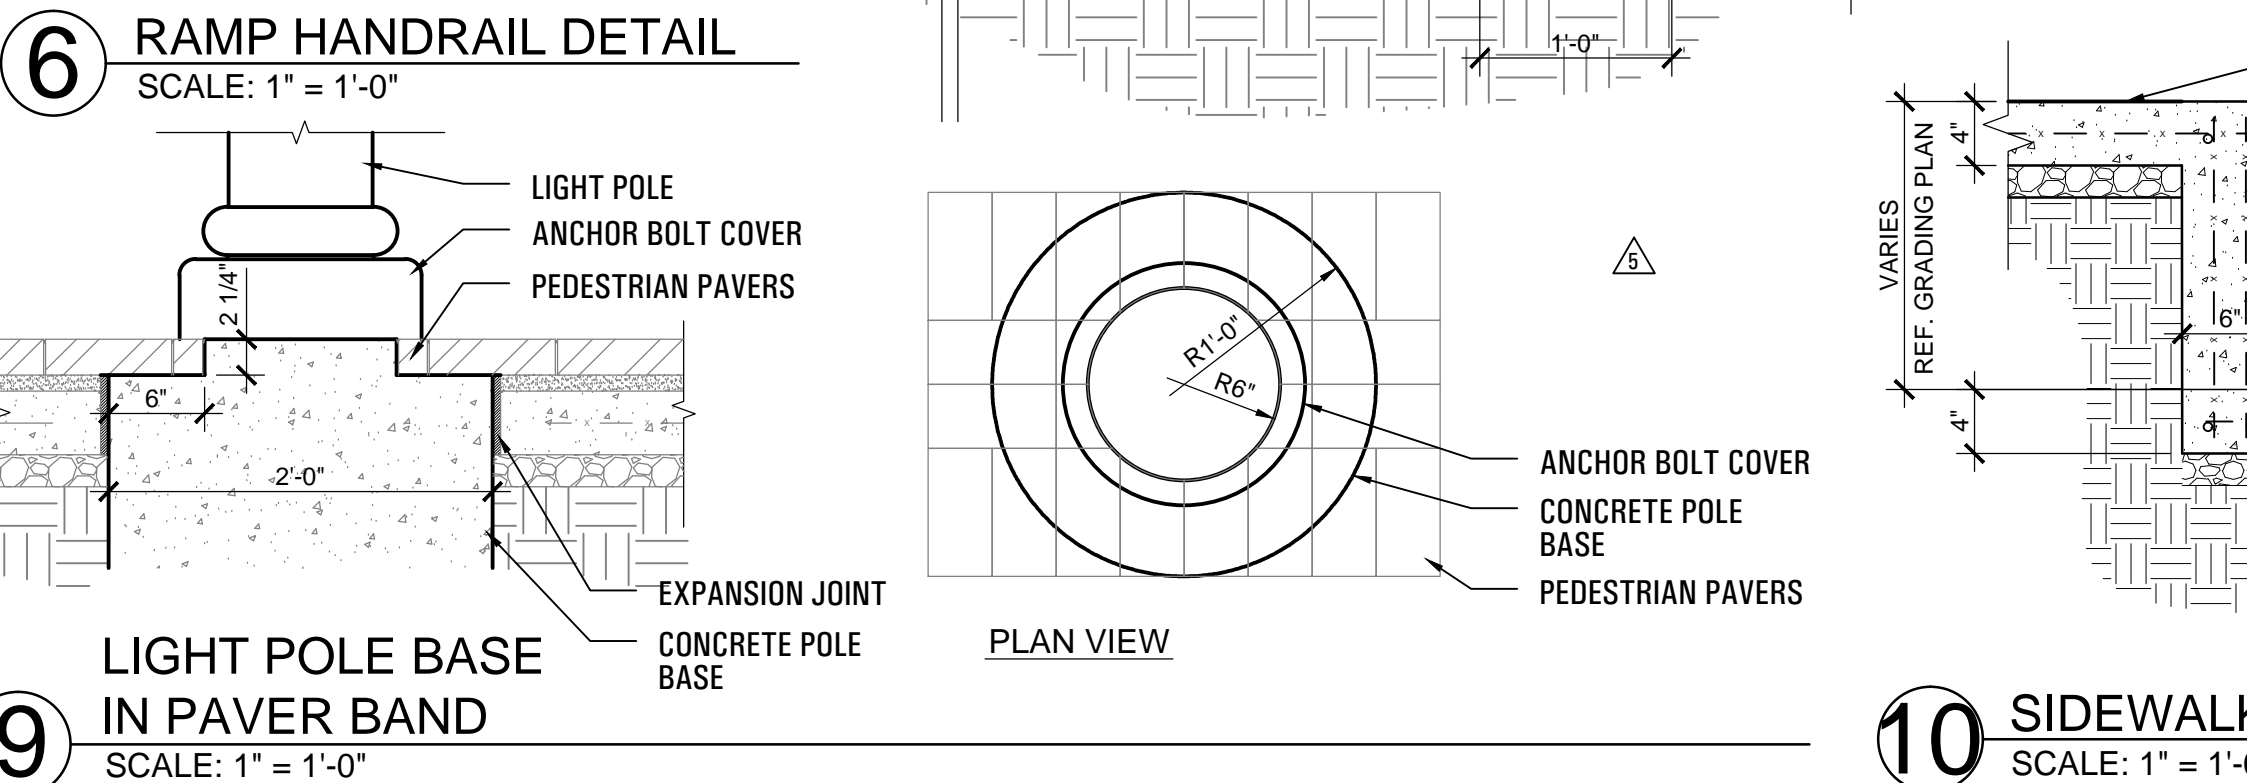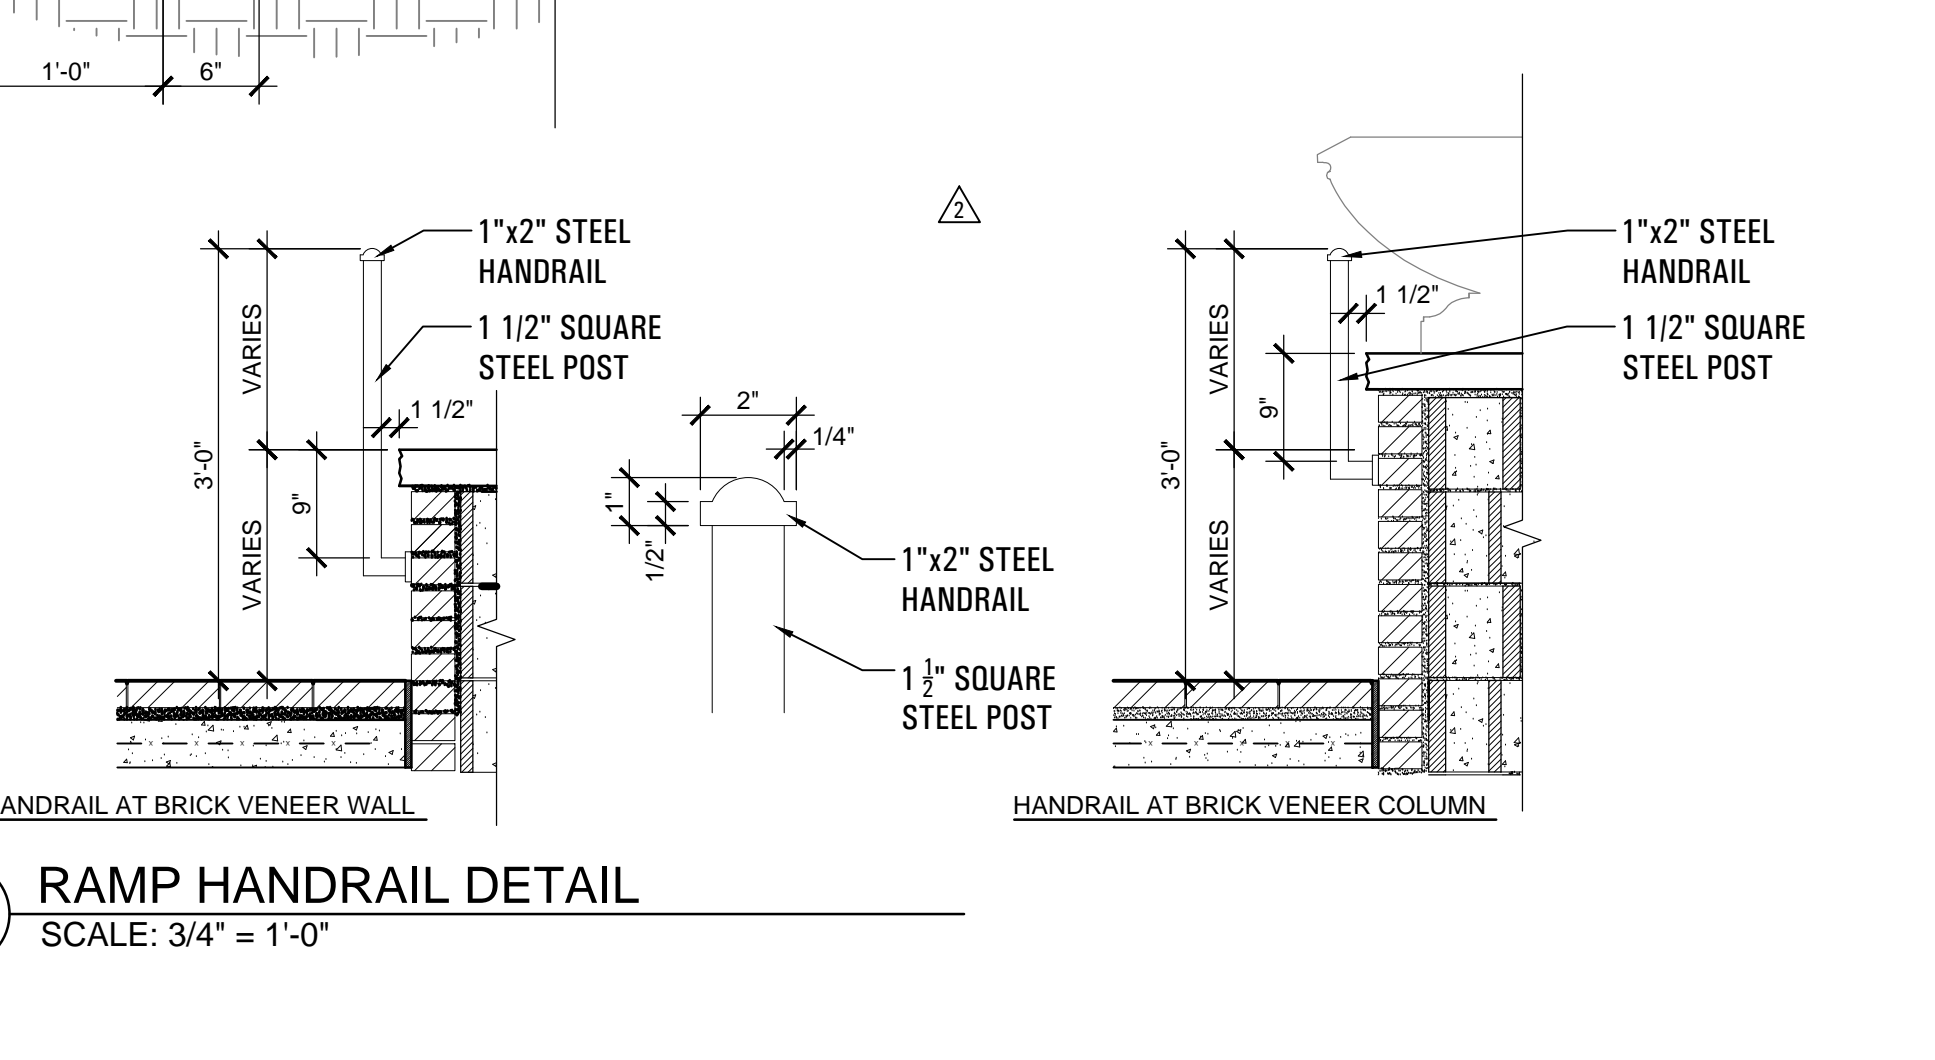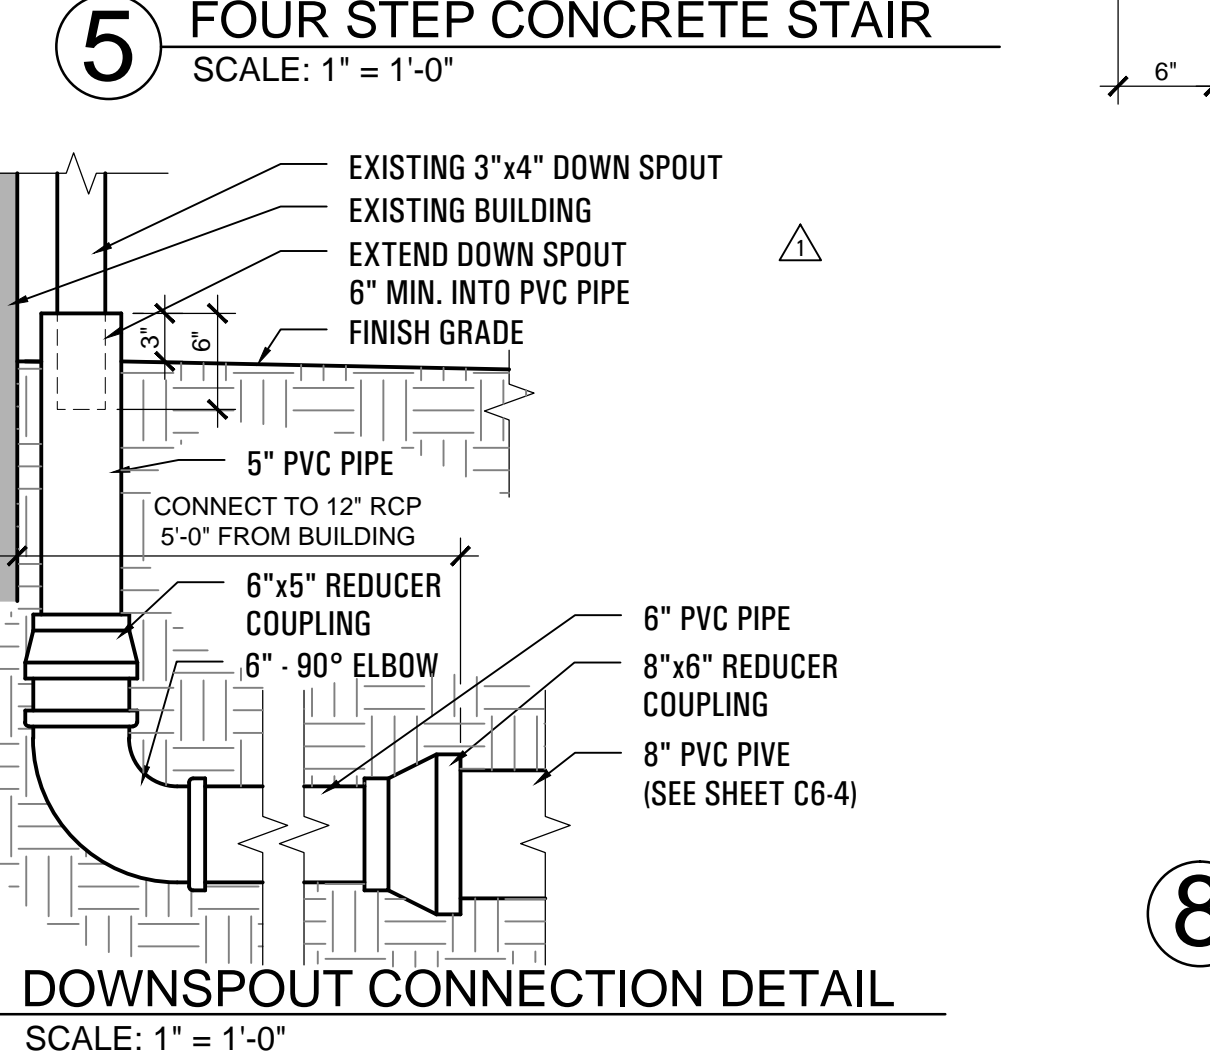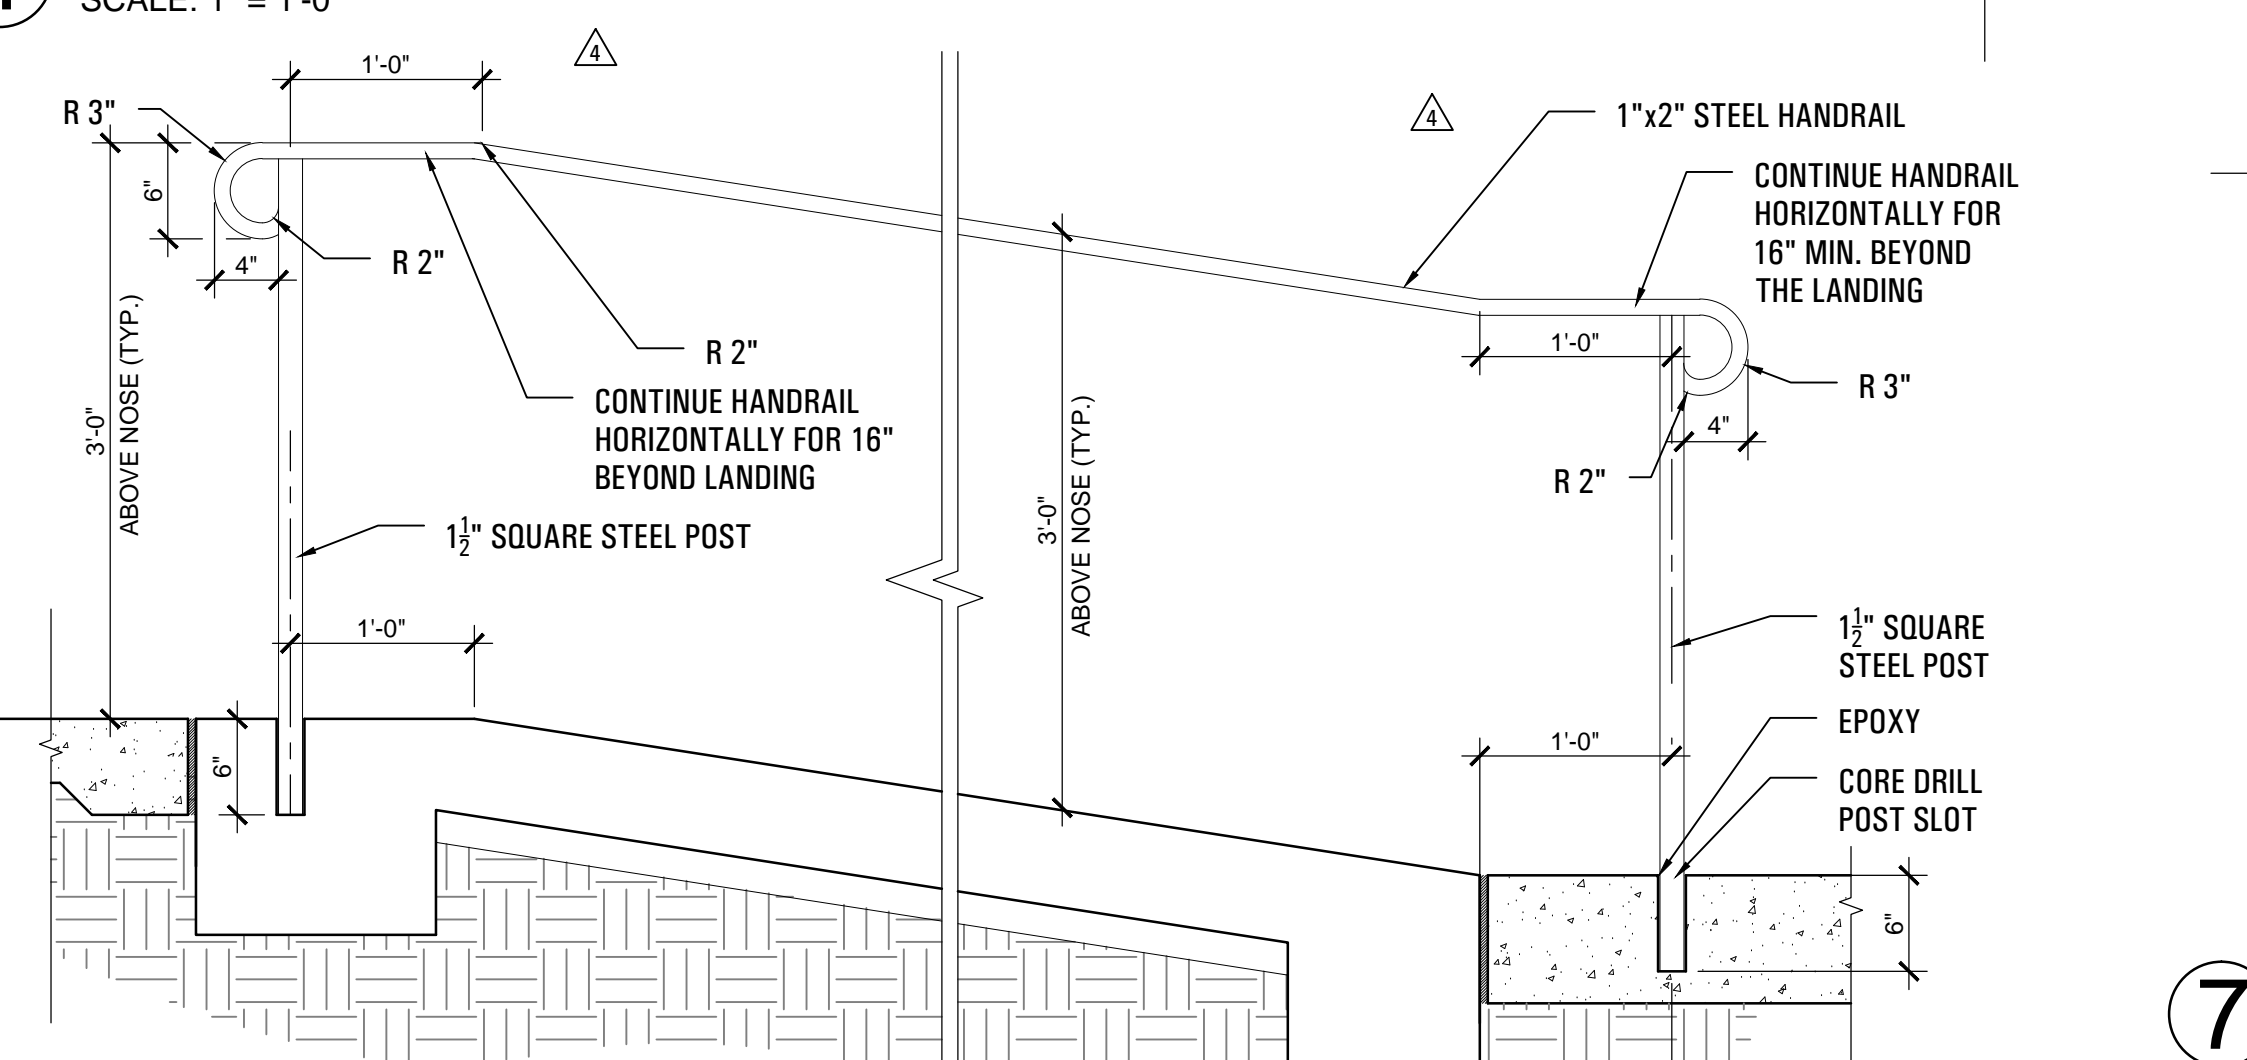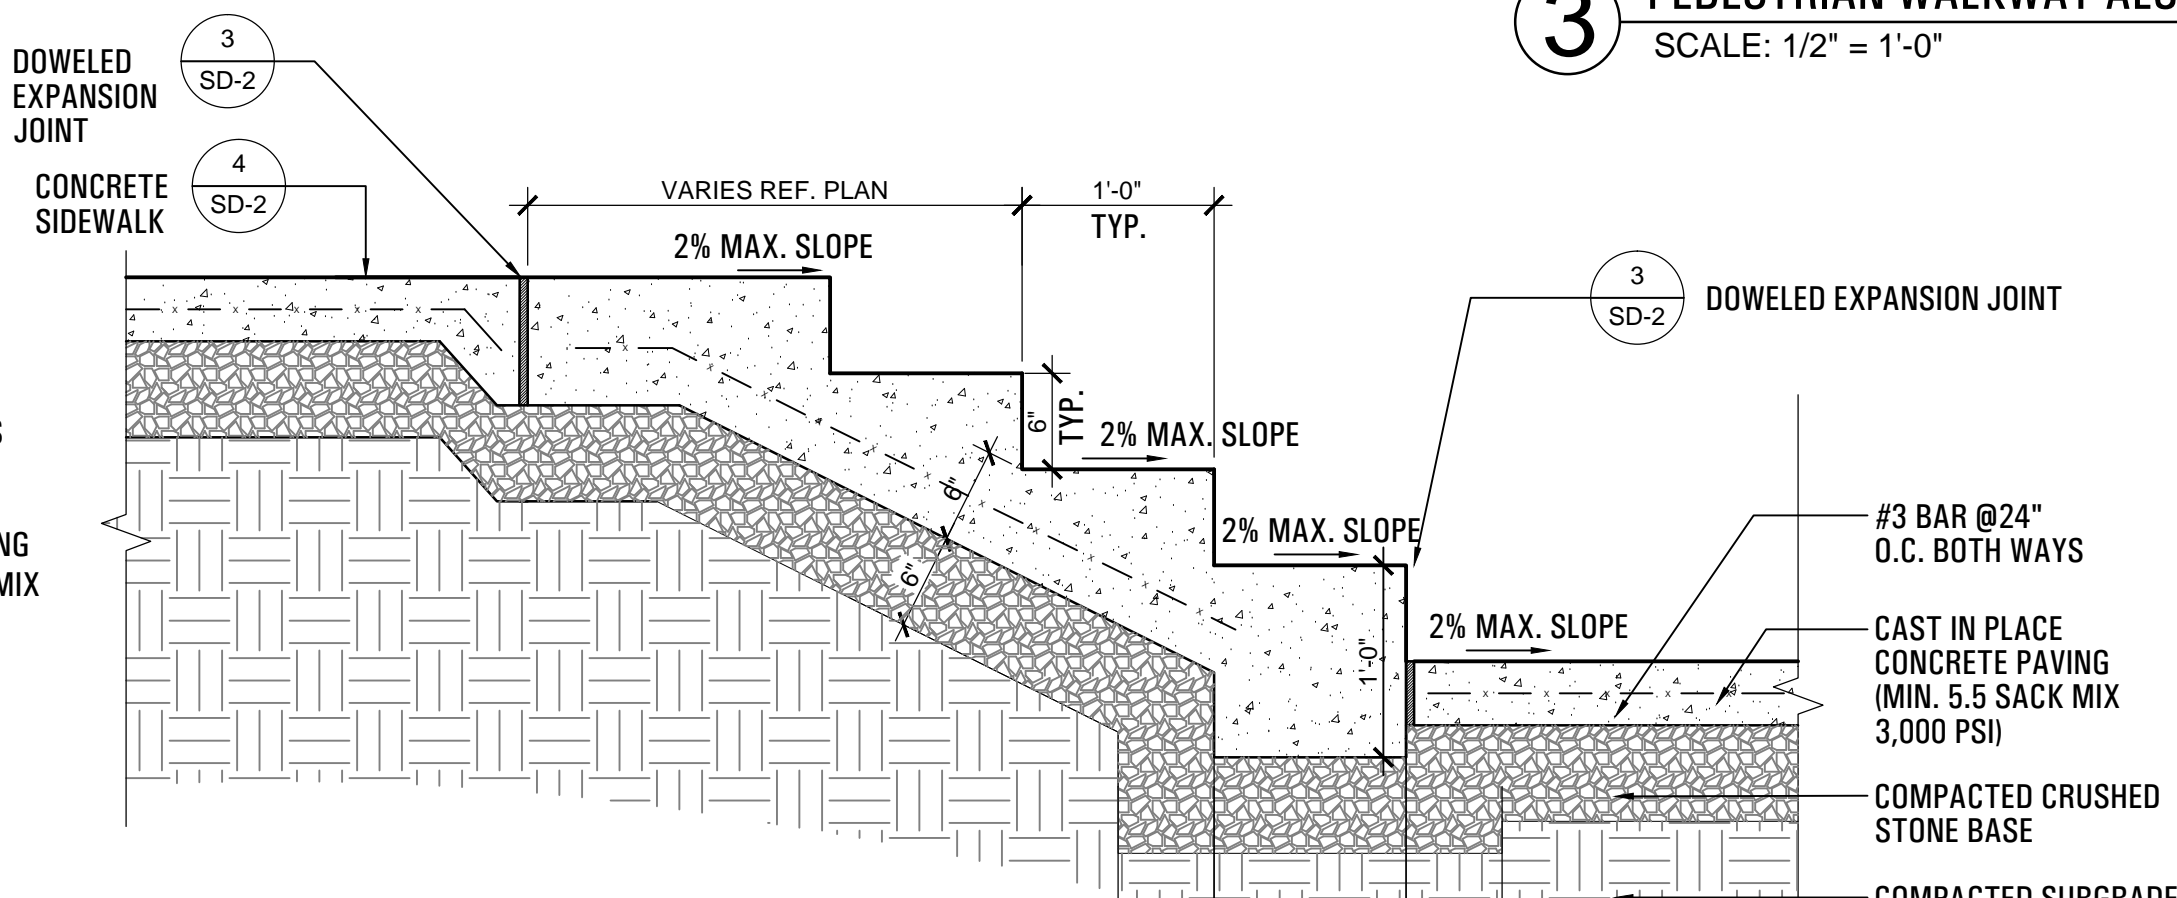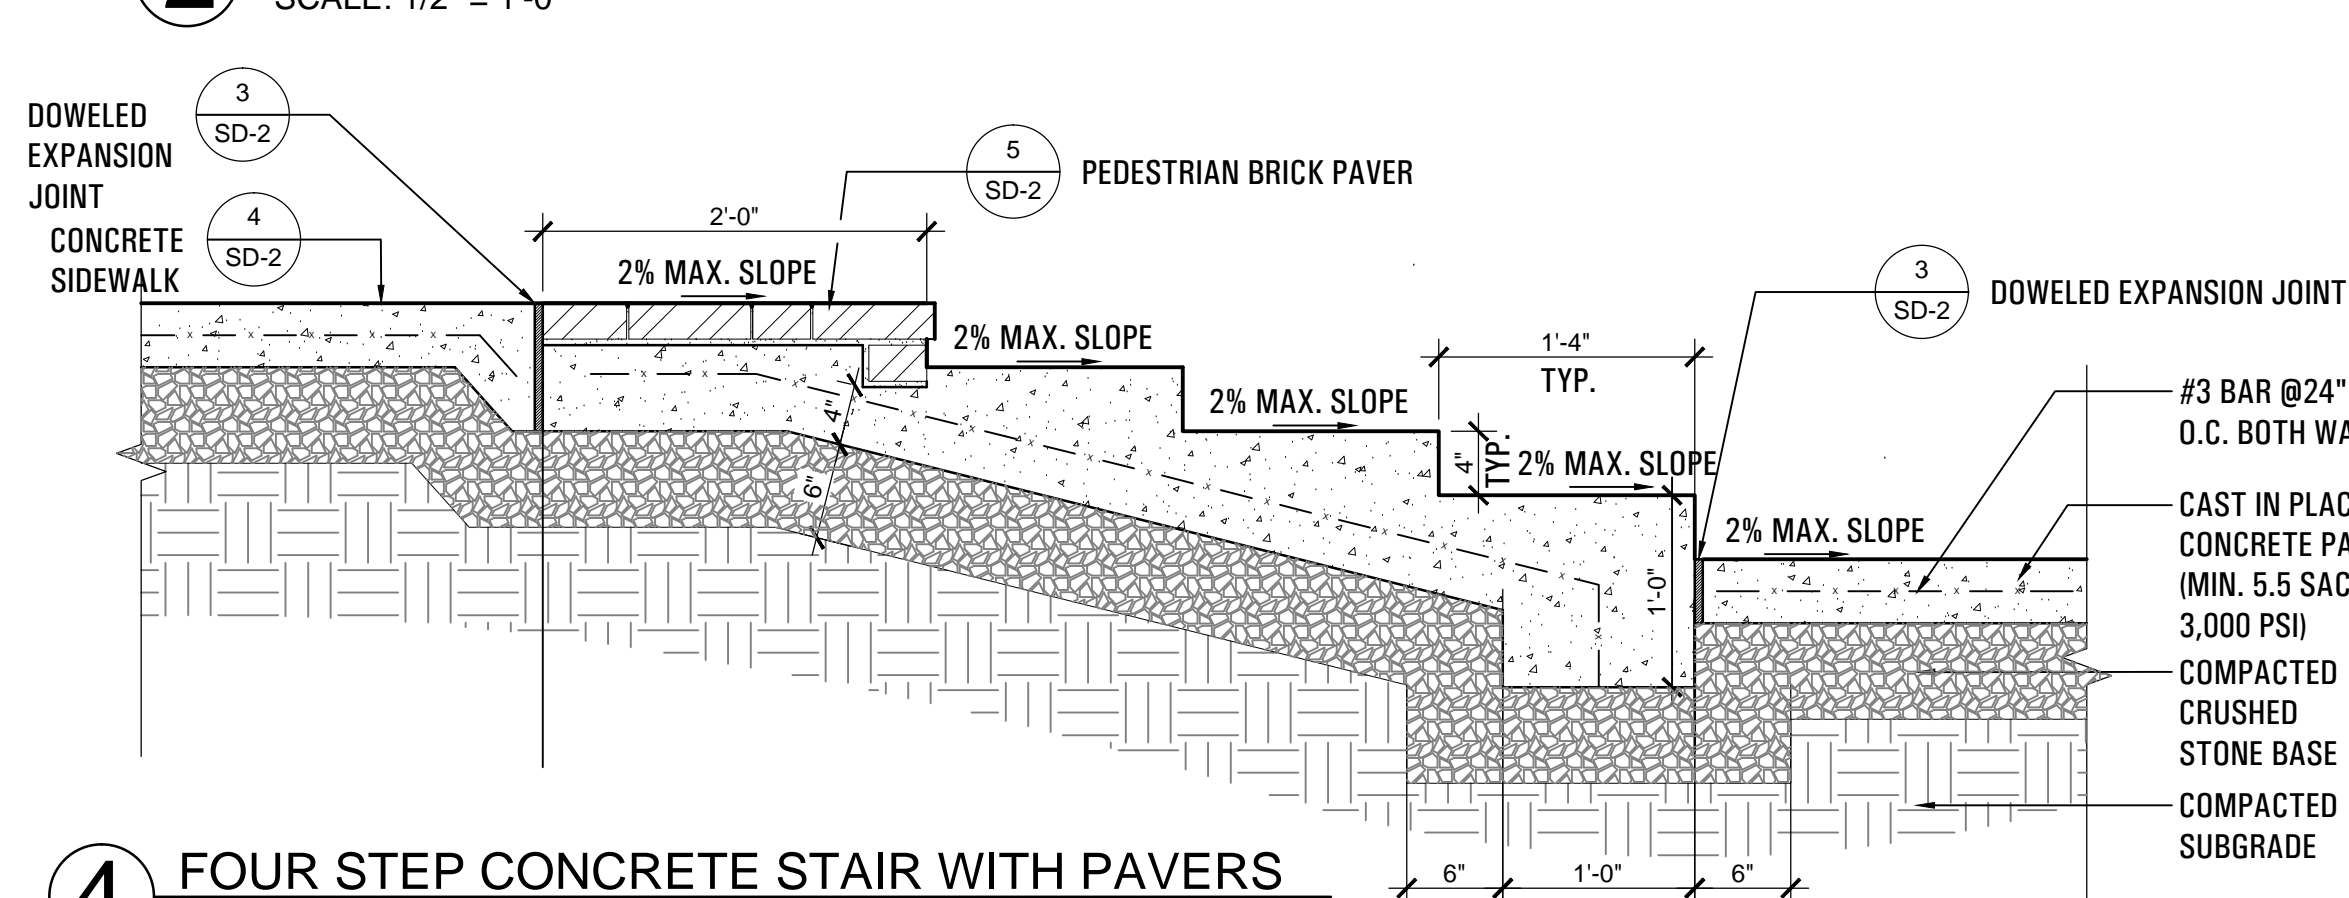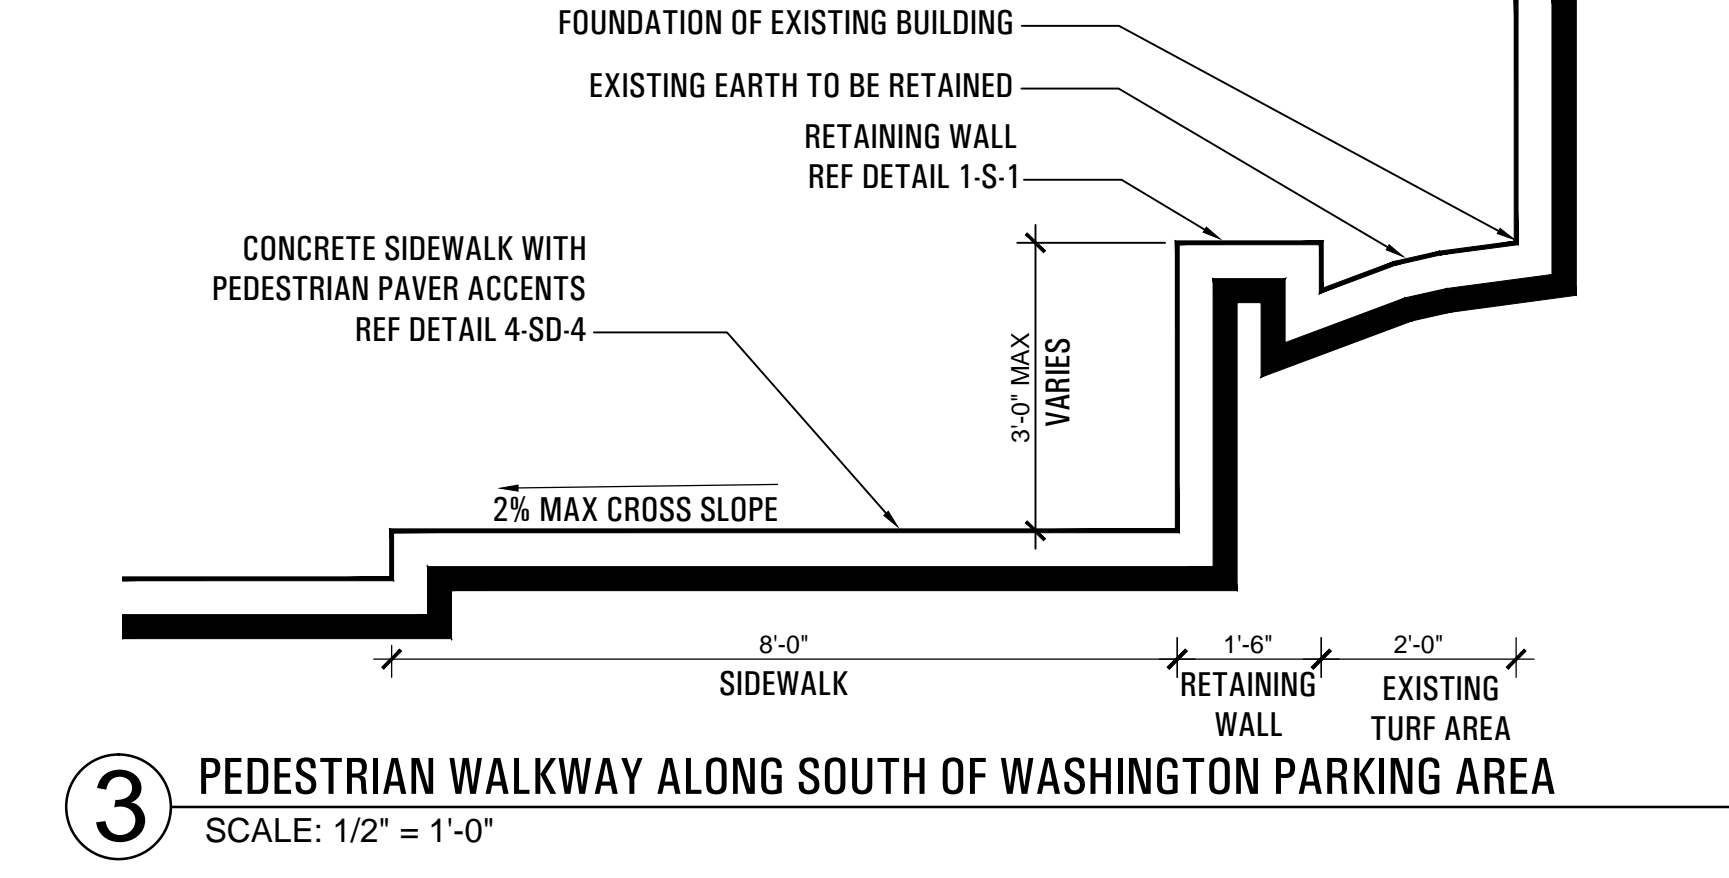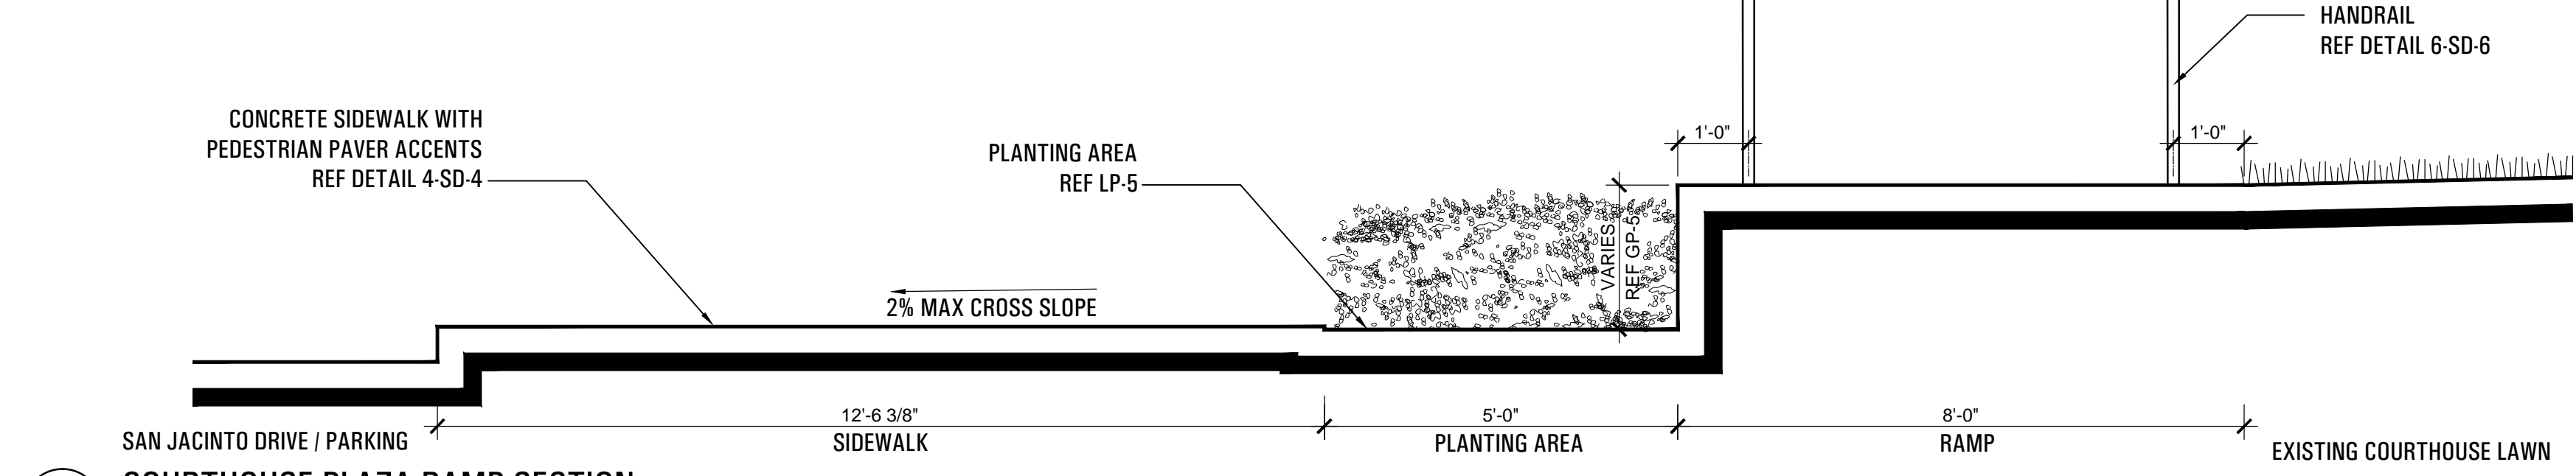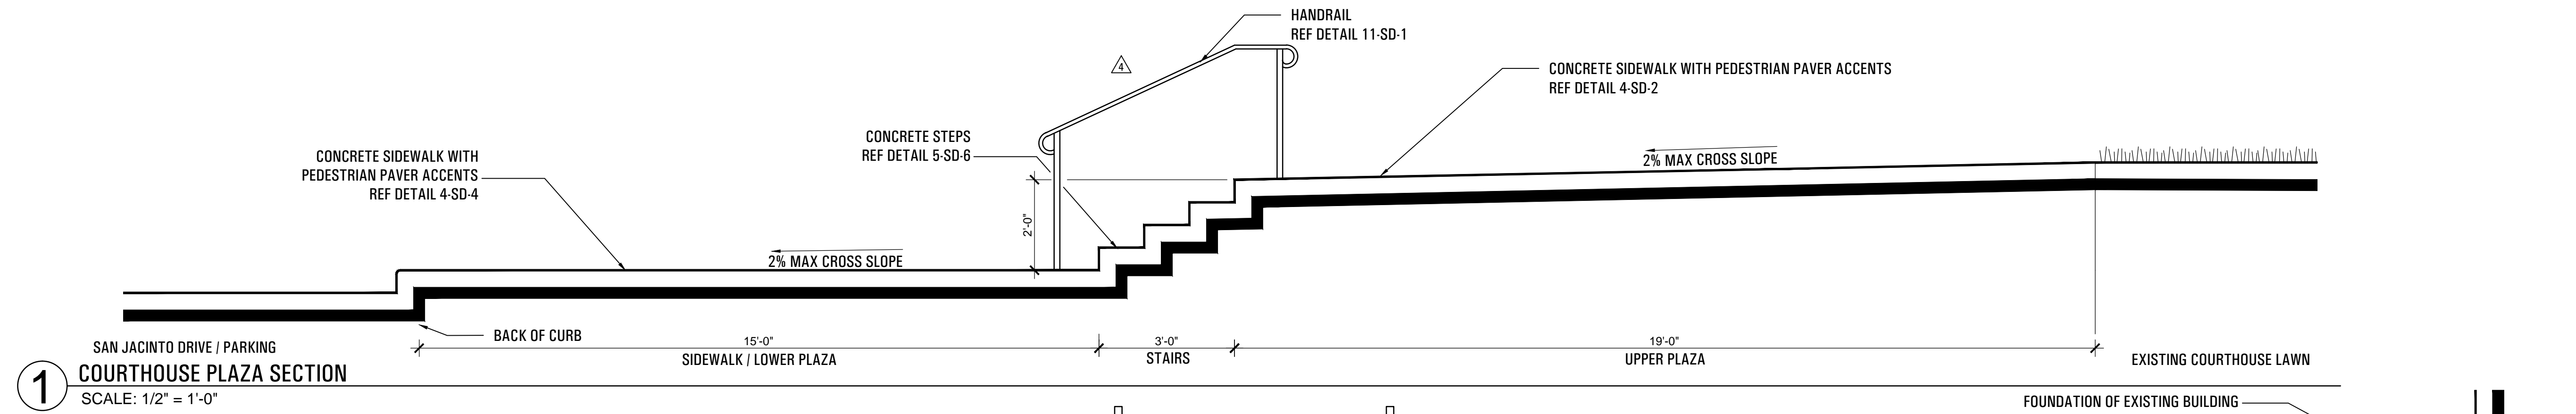

© 2013 la terra studio, inc. All Rights Reserved FILE: P:\12024-Downtown Rockwall PS&E - Rockwall\CAD\ISHEET\12024-Site Details_6.dwg