




1 TWO STEP STAIR
SCALE: 1" = 1'-0"

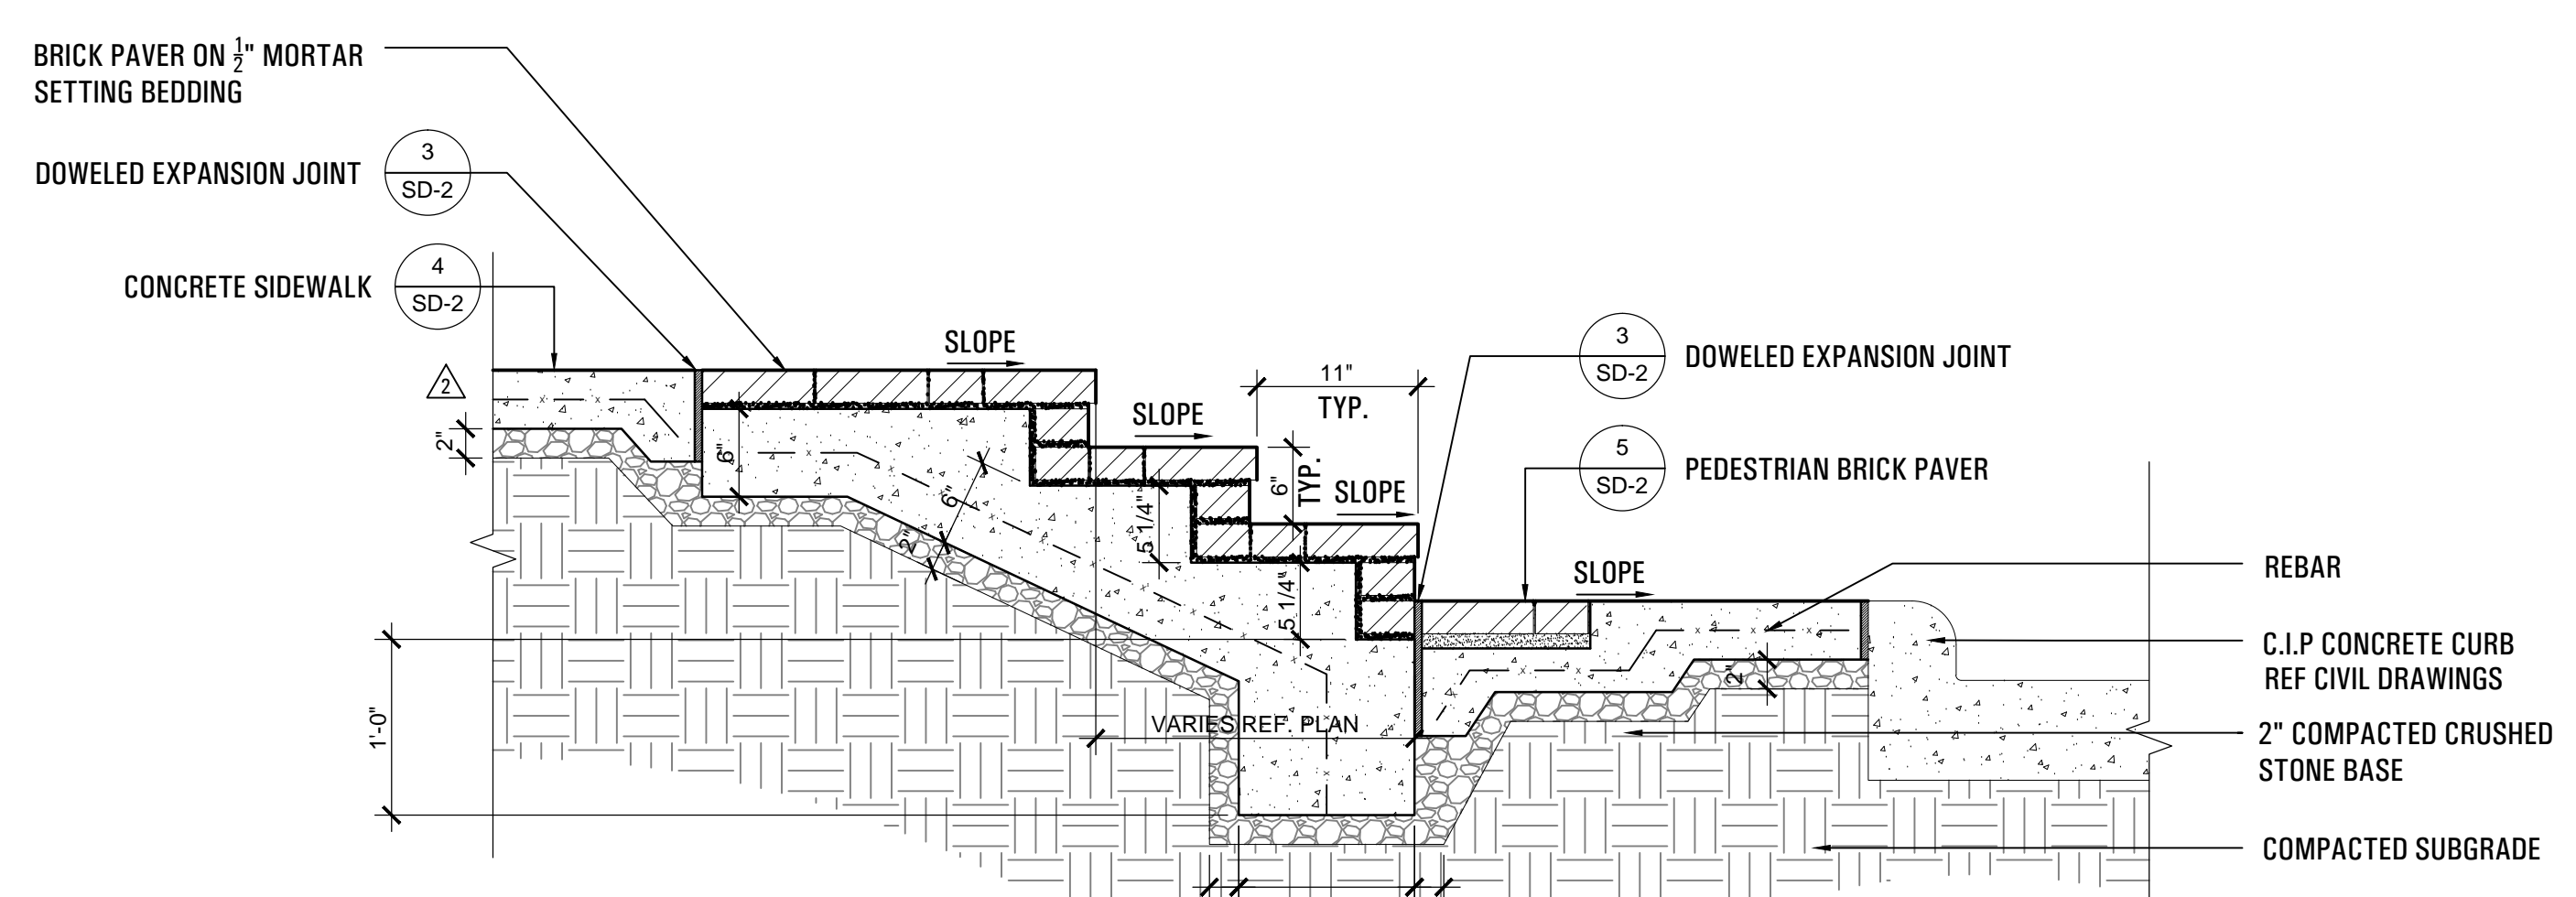


2 THREE STEP STAIR
SCALE: 1" = 1'-0"

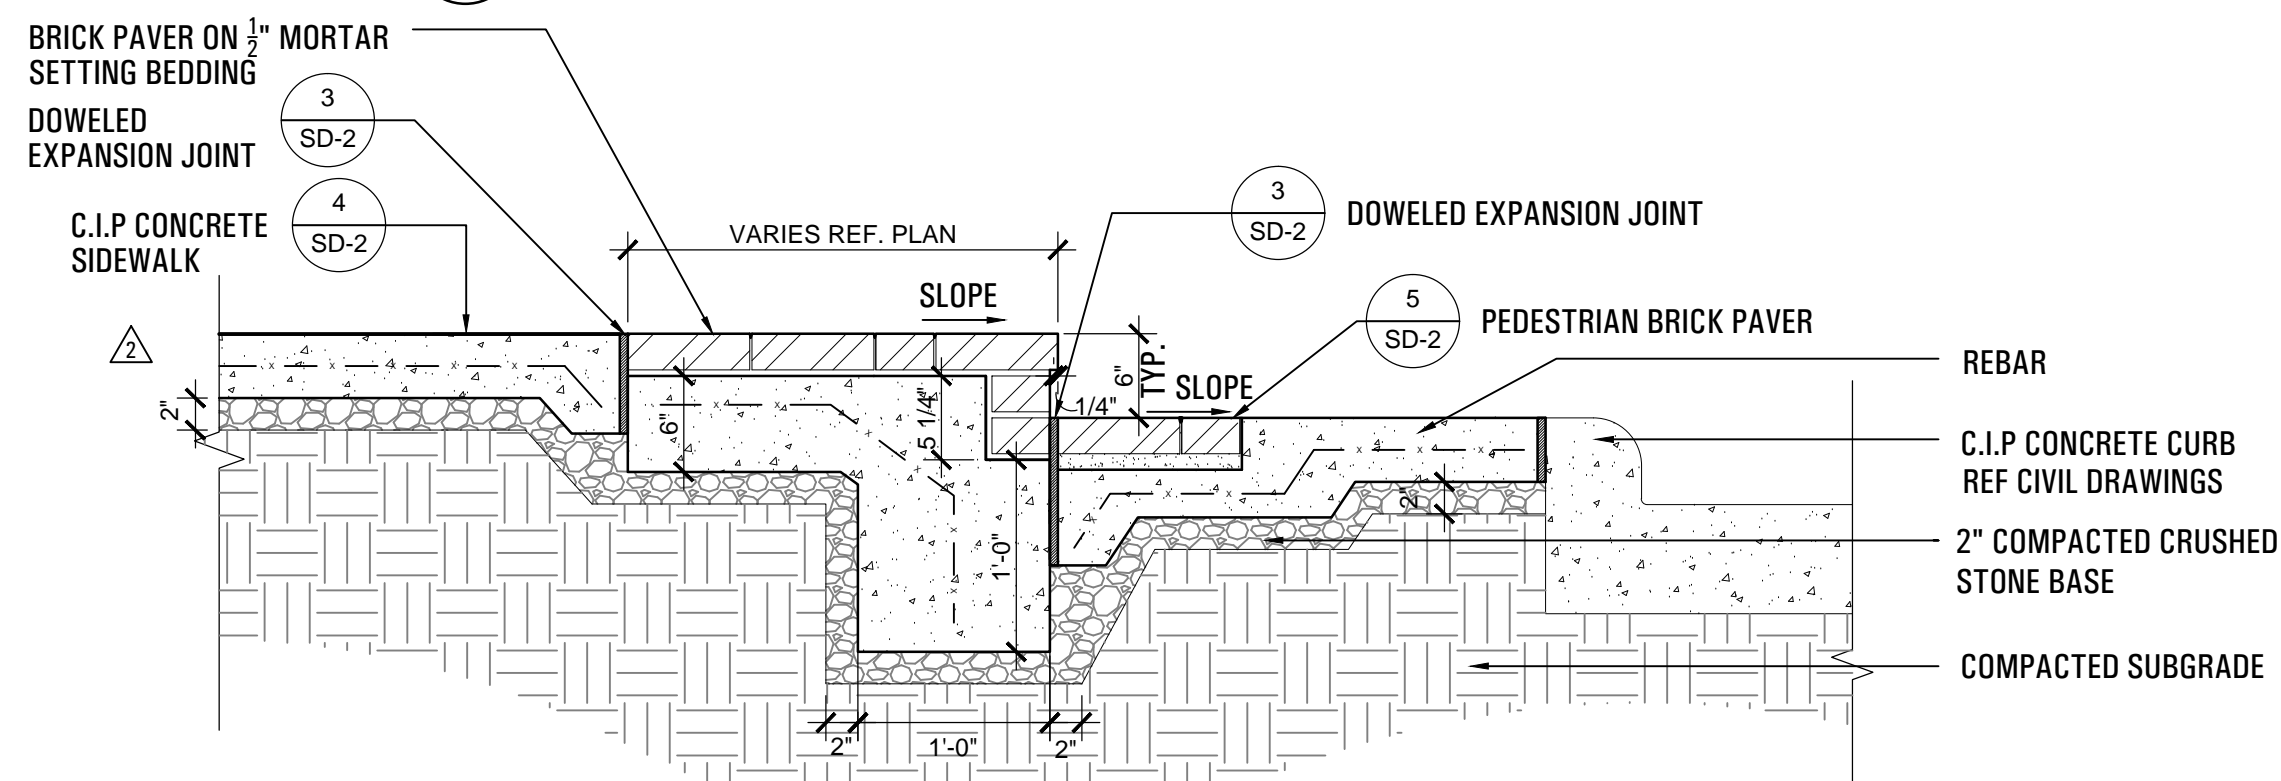


3 ONE STEP STAIR
SCALE: 1" = 1'-0"

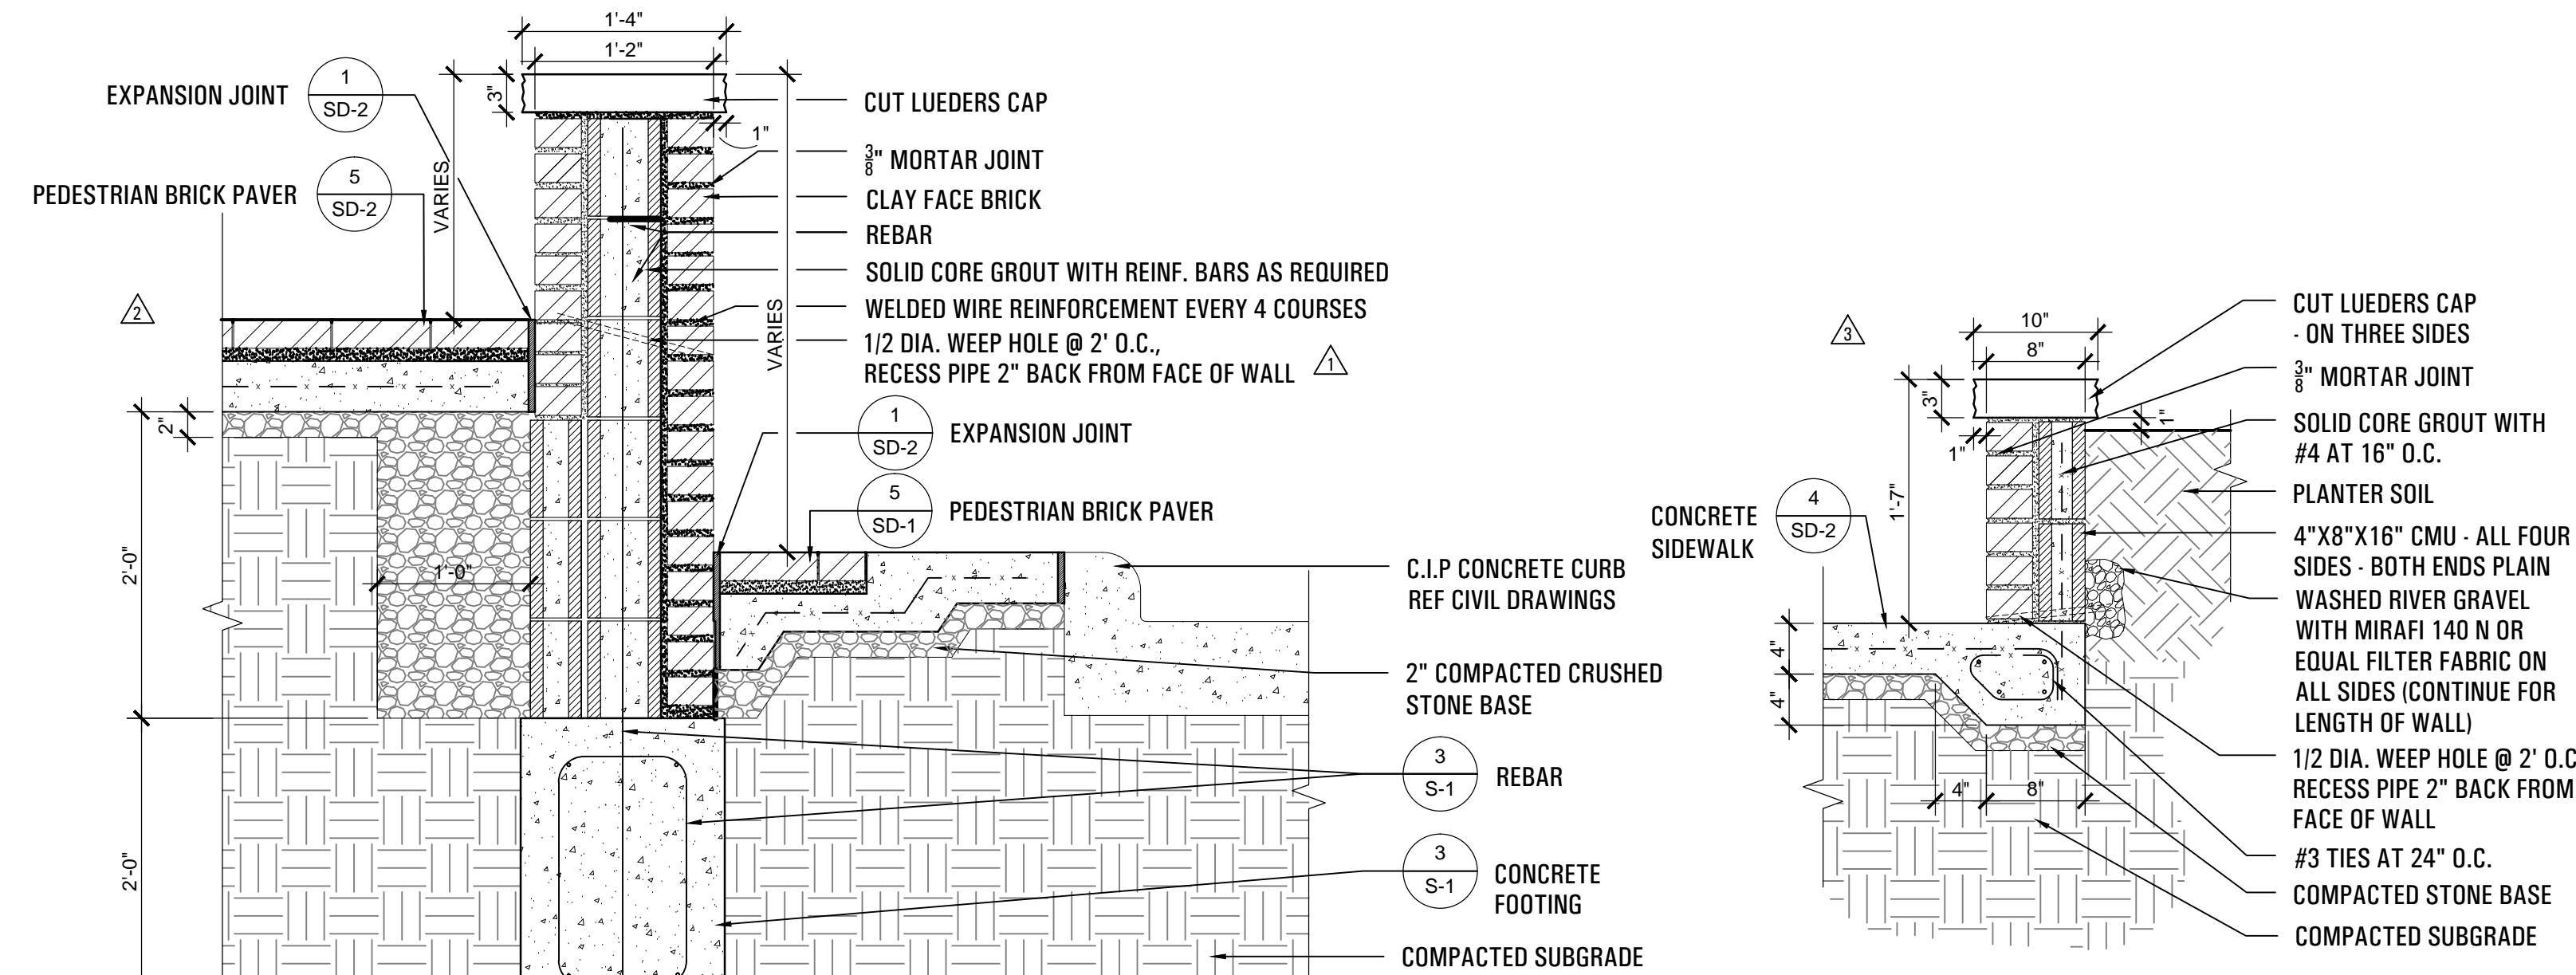


4 BRICK VENEER WALL
SCALE: 1" = 1'-0"

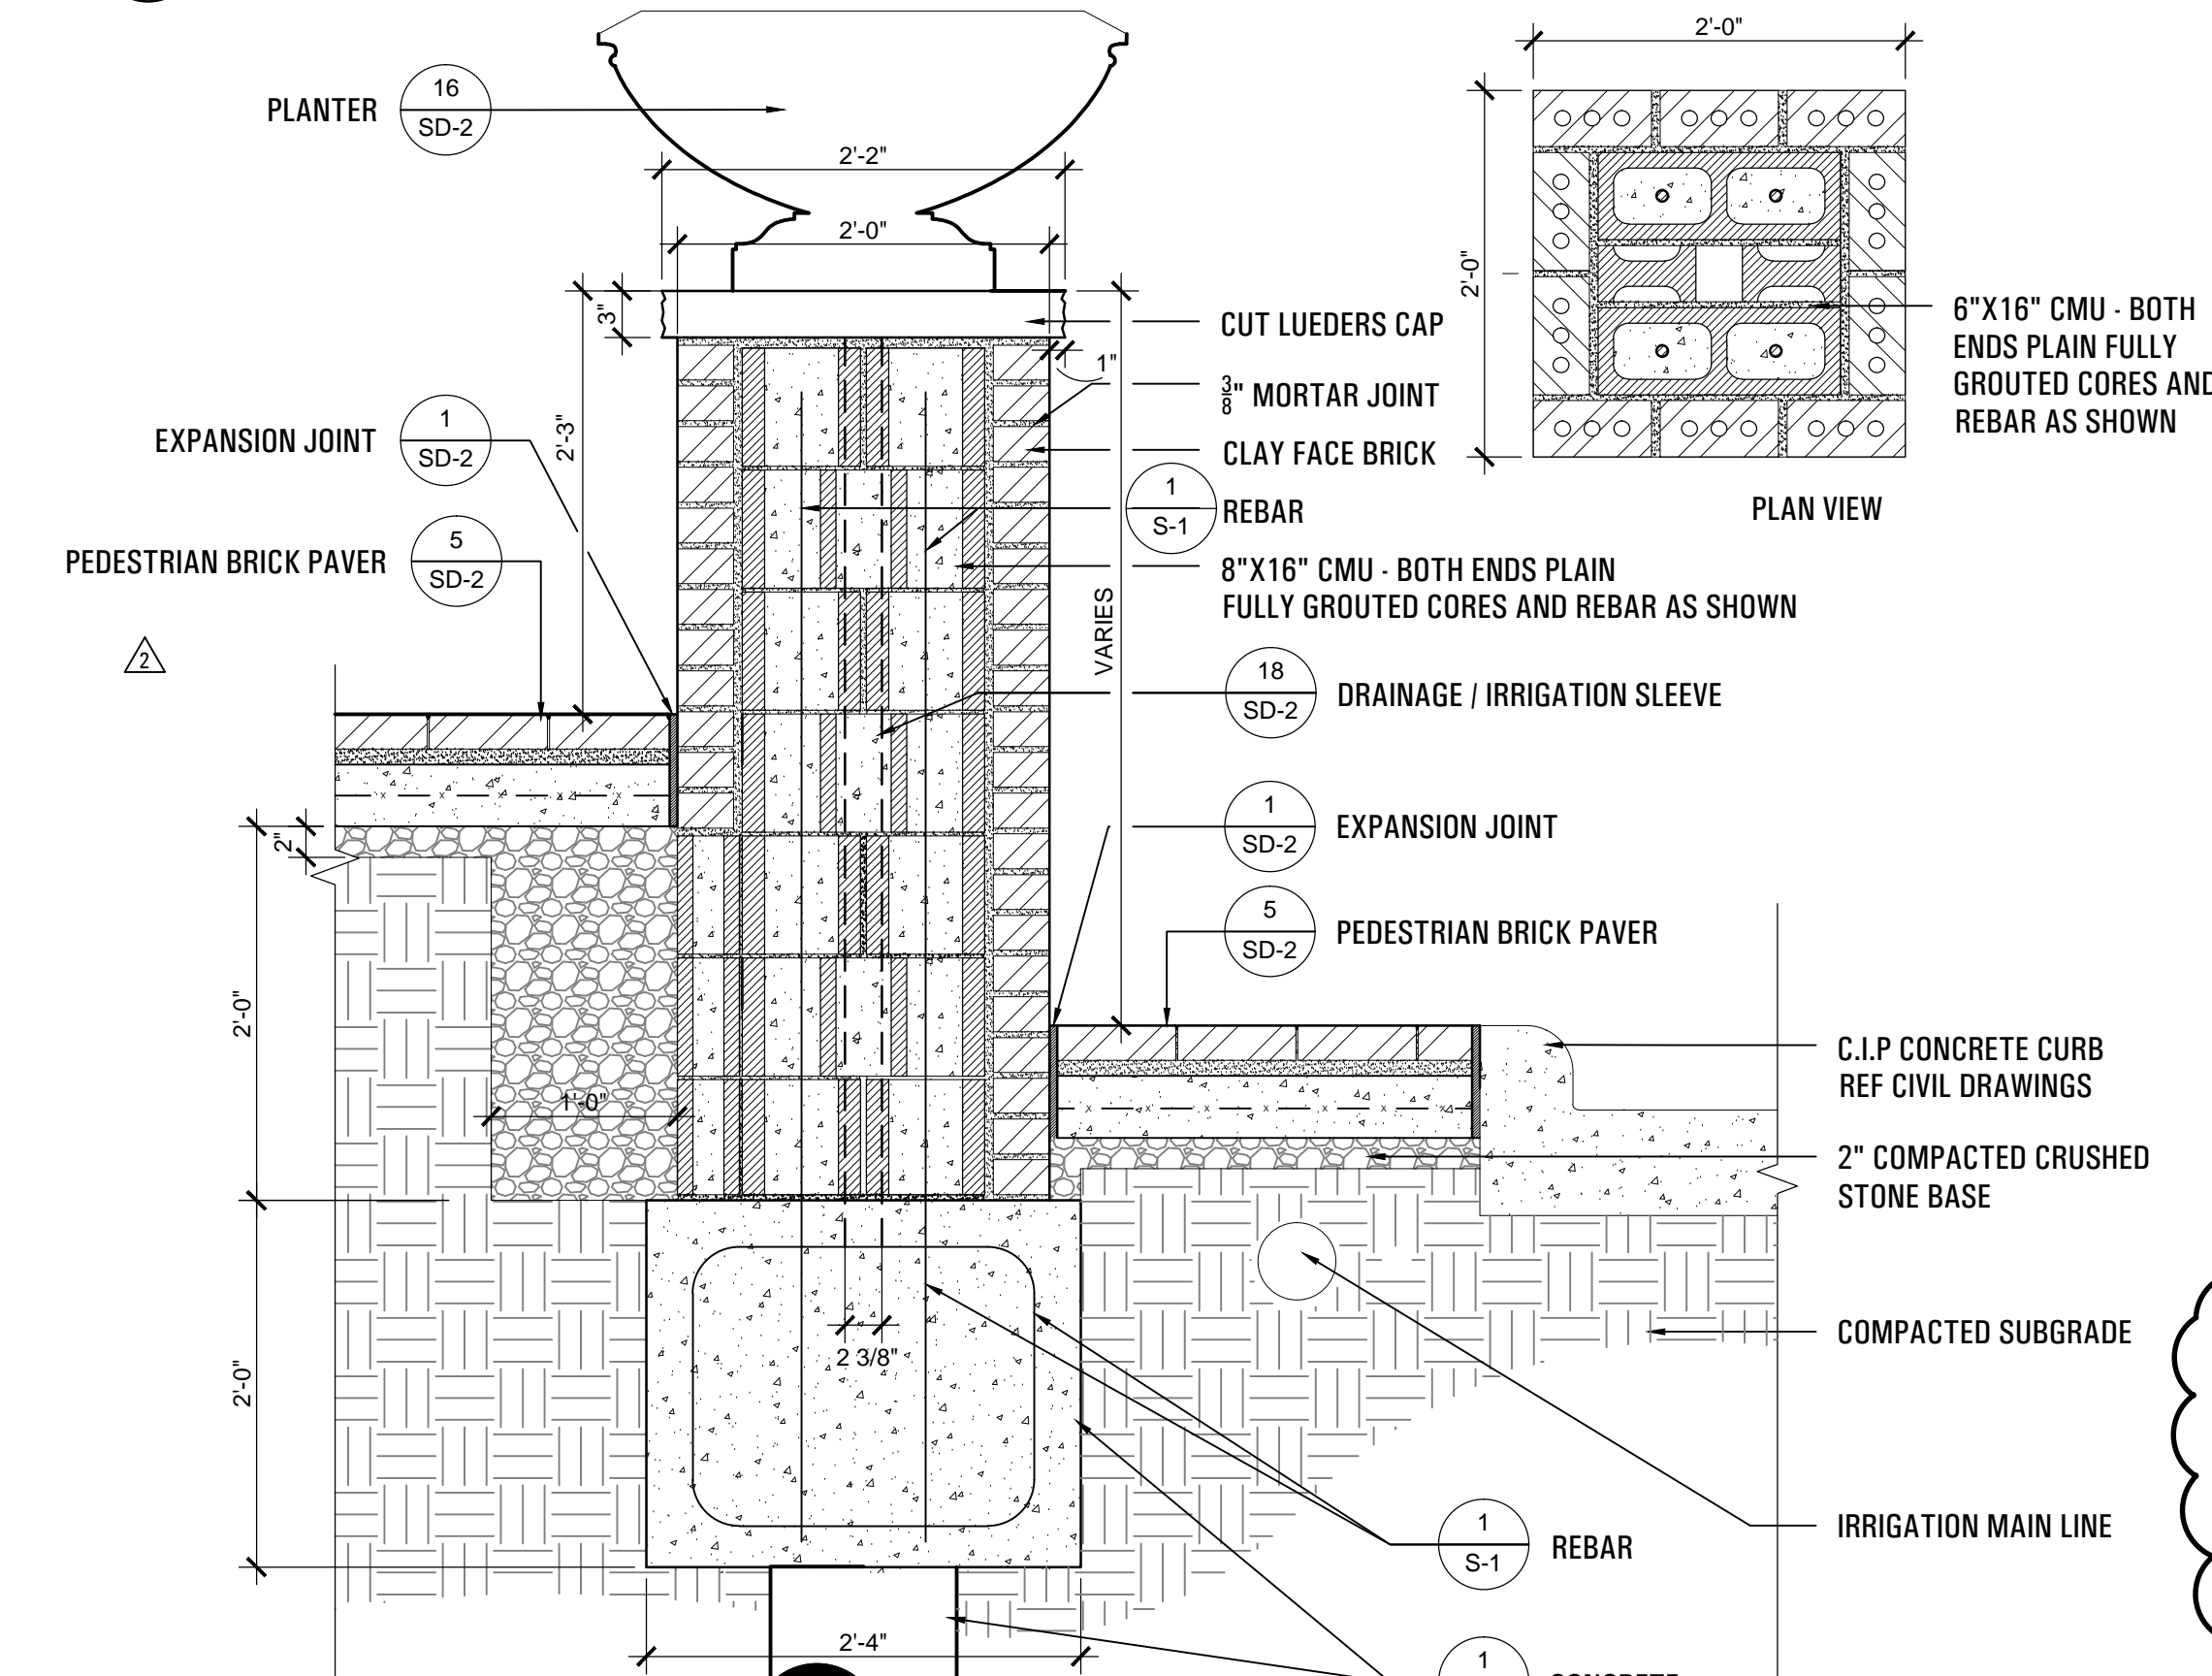


5 BRICK VENEER COLUMN
SCALE: 1" = 1'-0"

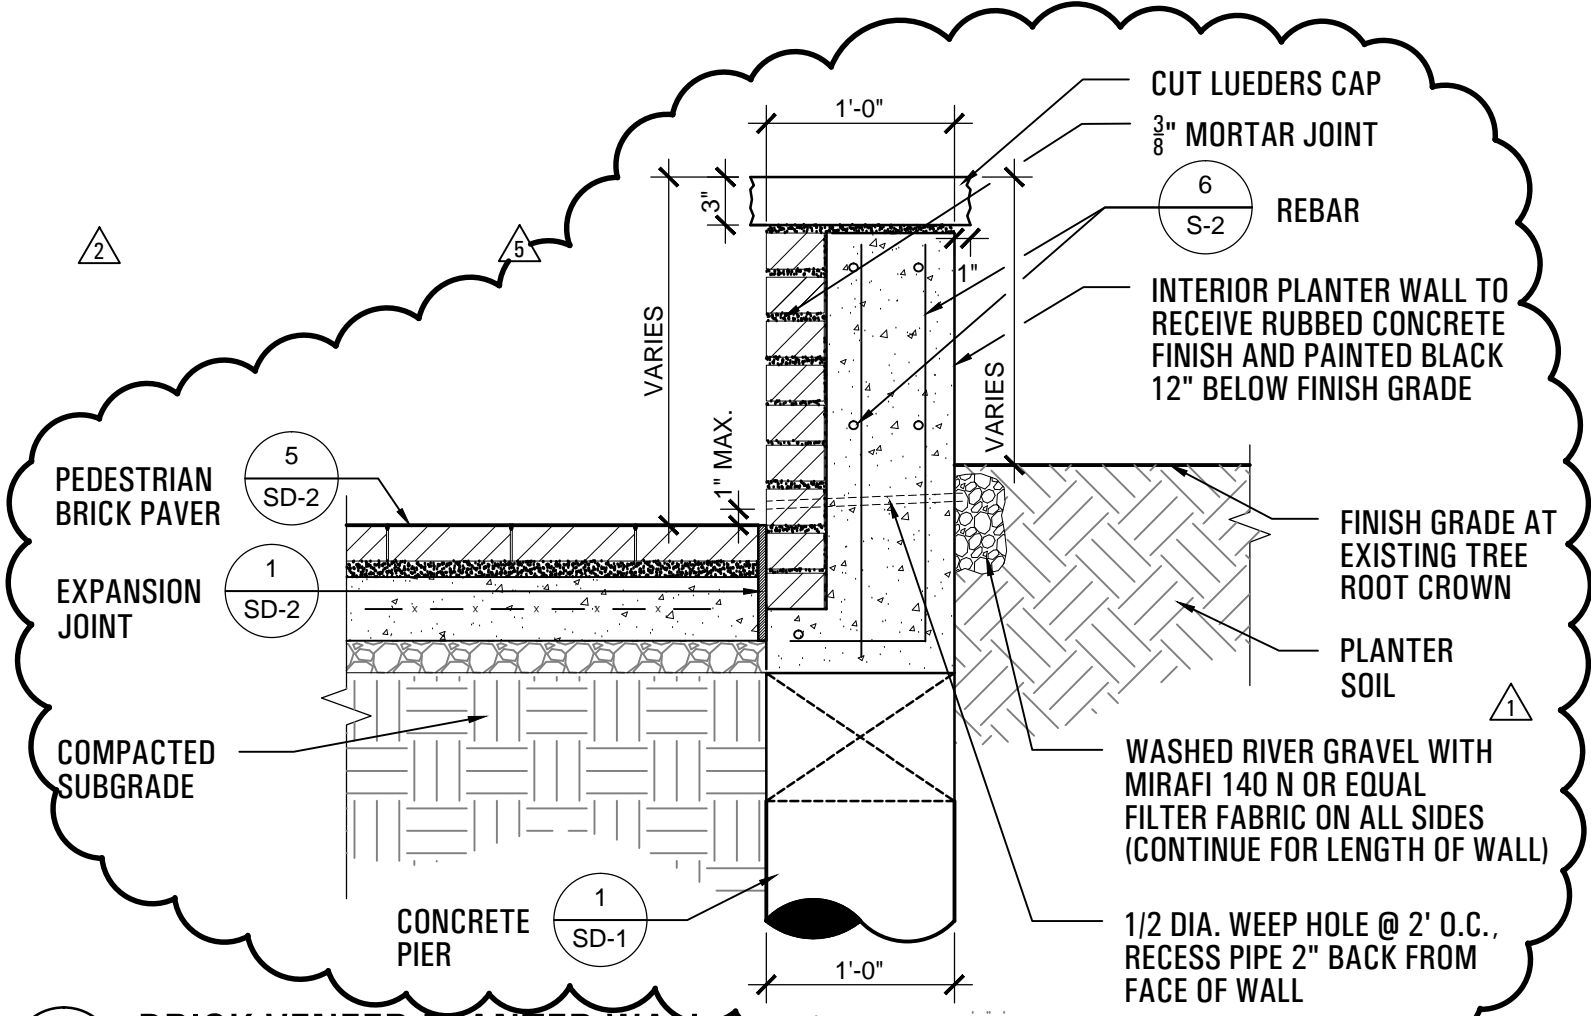

6 BRICK VENEER PLANTER WALL
SCALE: 1" = 1'-0"

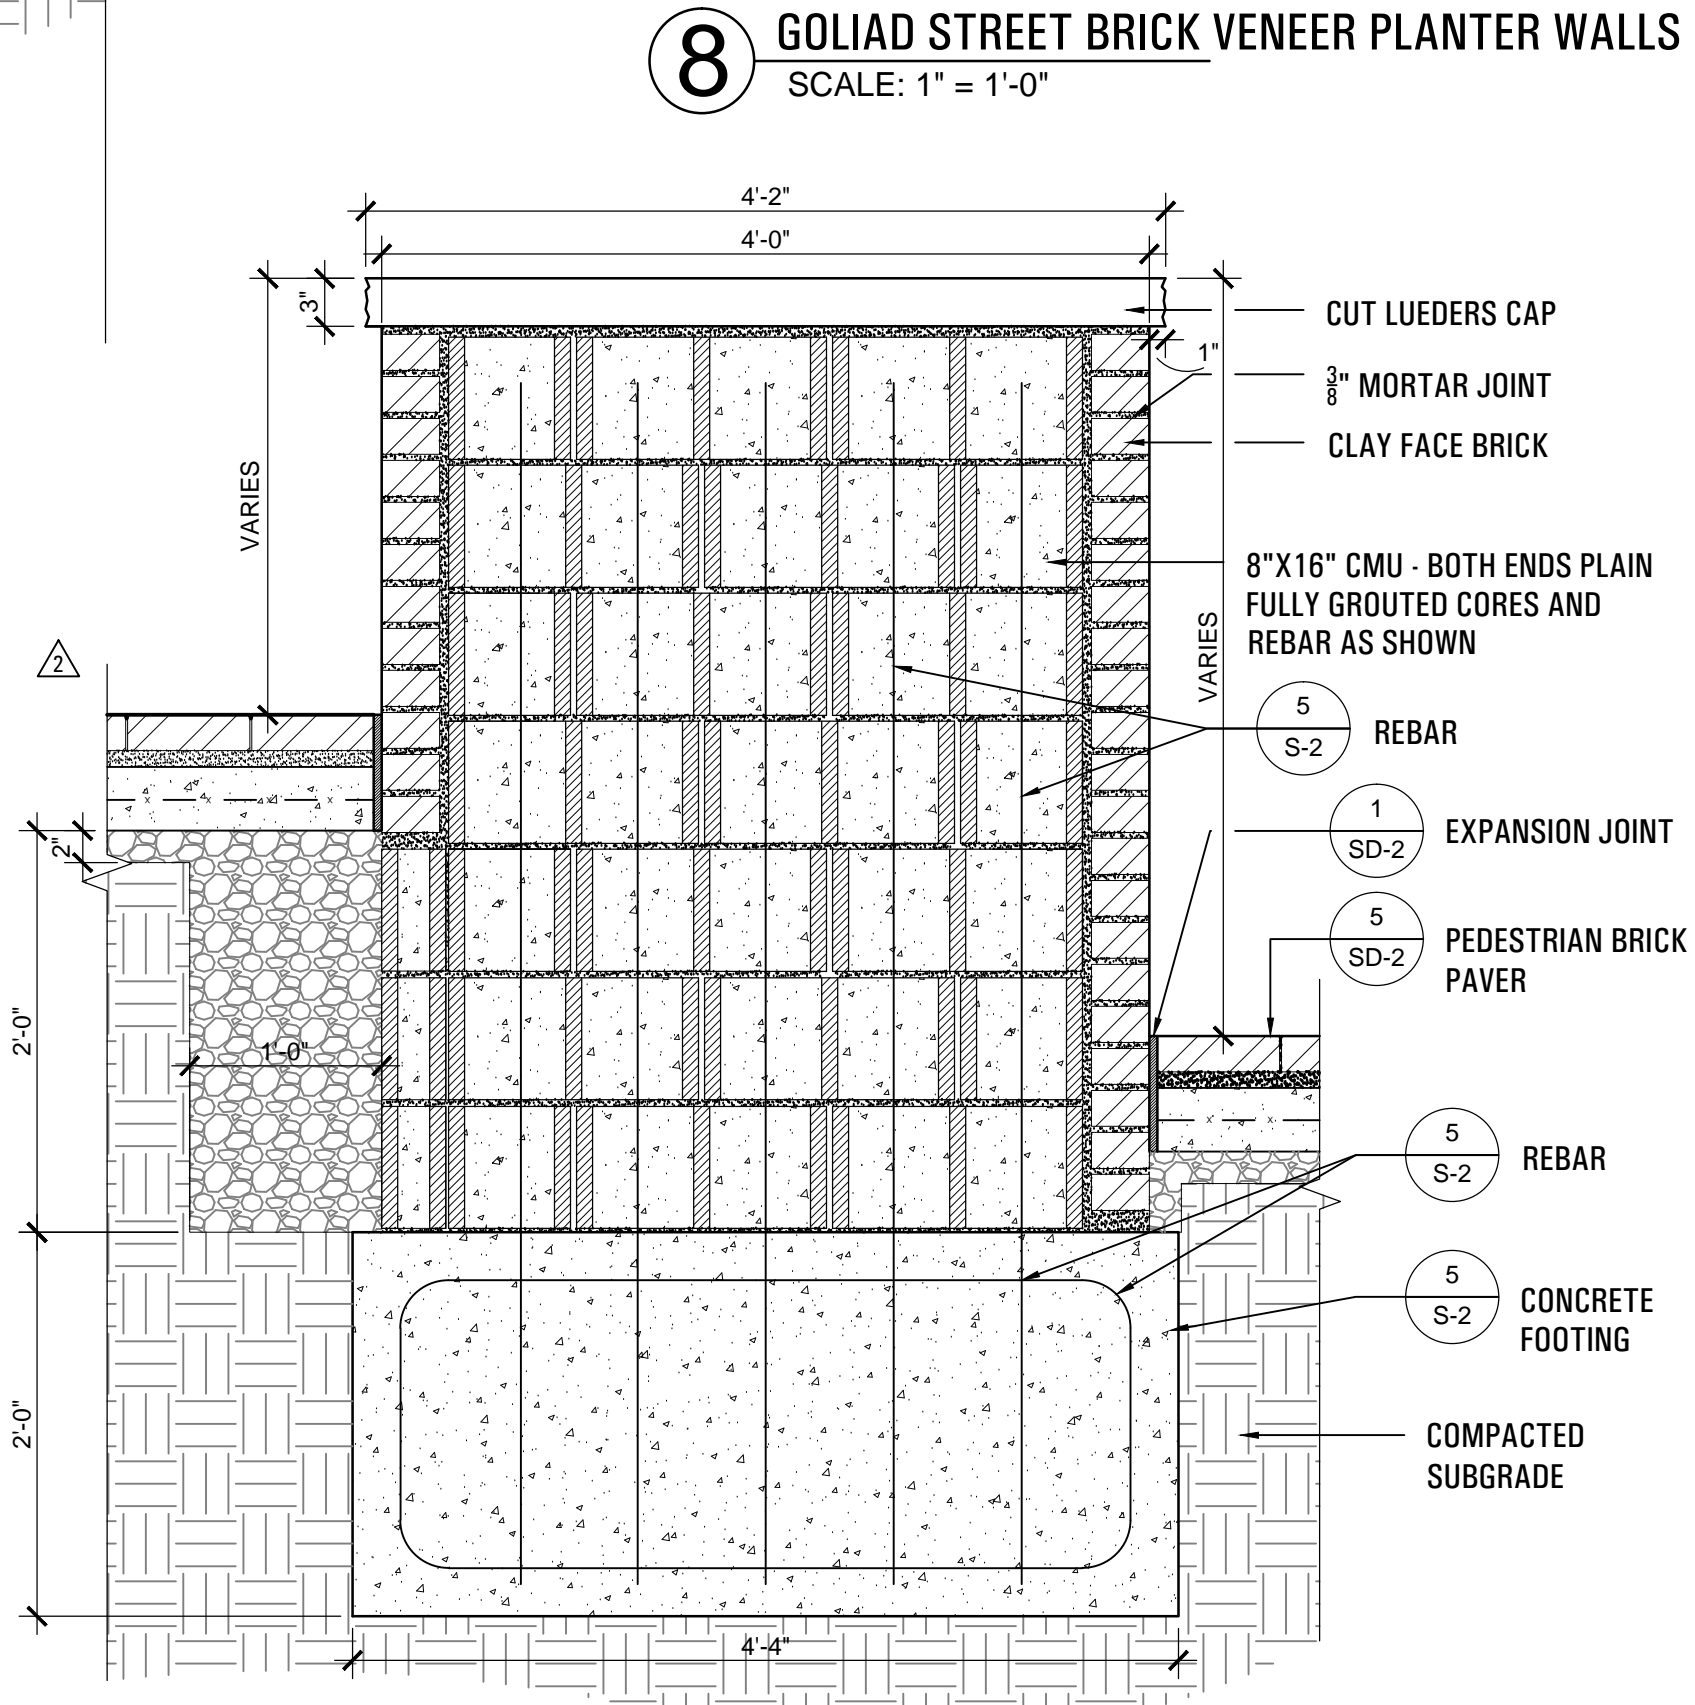

7 LARGE BRICK VENEER COLUMN
SCALE: 1" = 1'-0"

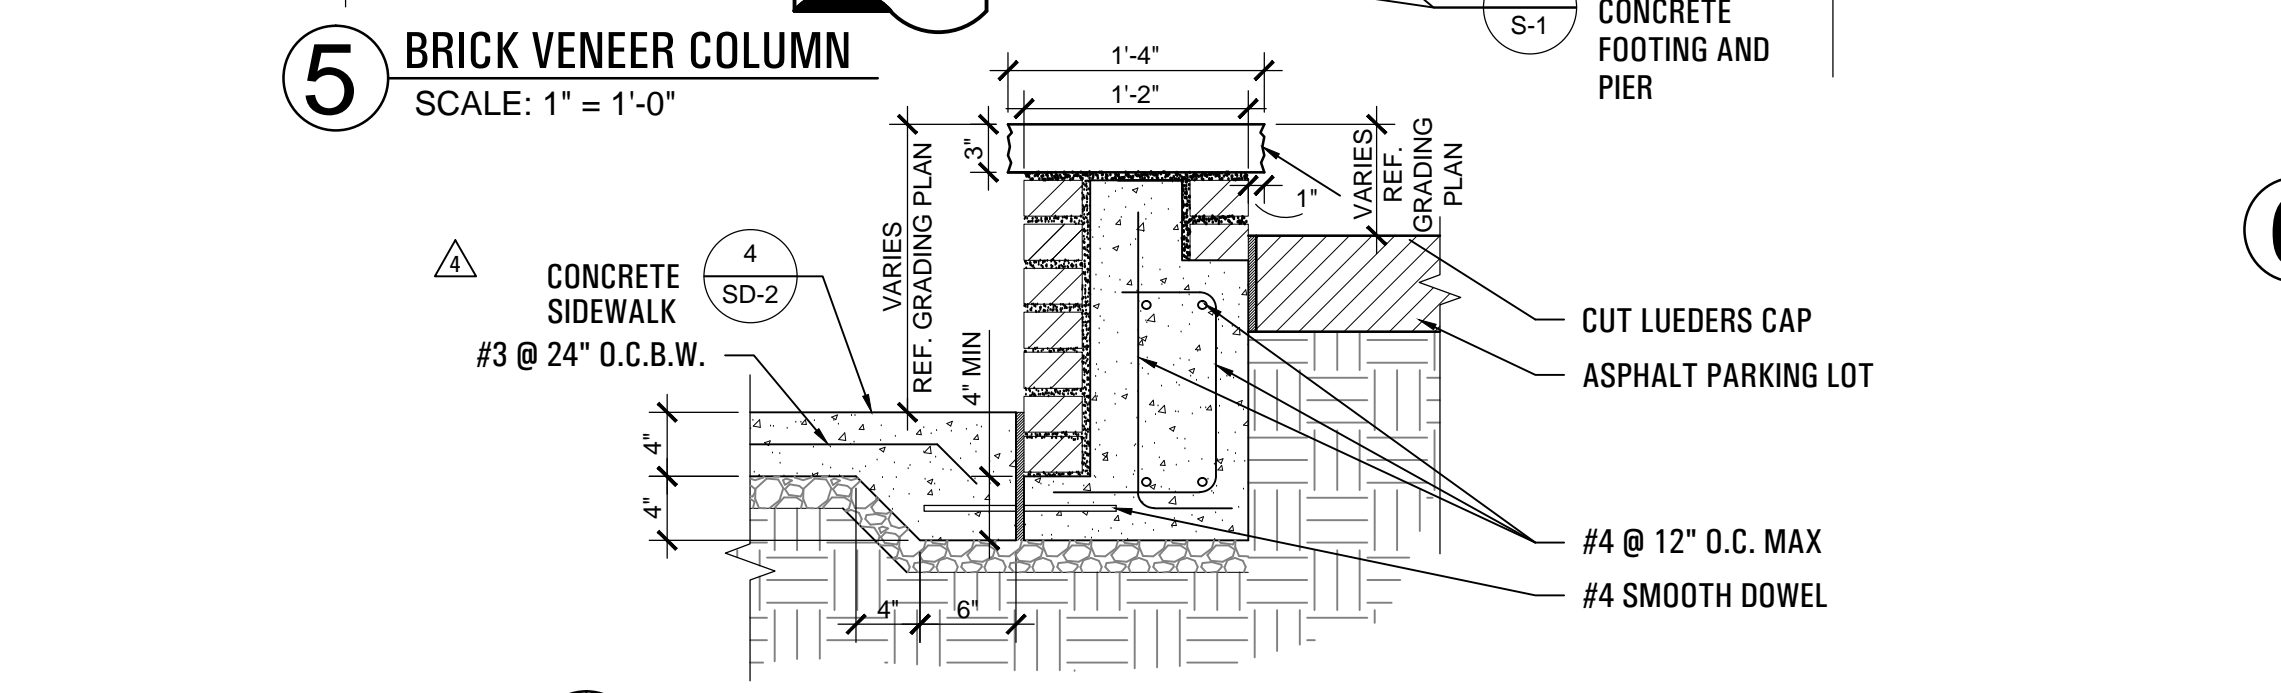

9 KAUFMAN STREET BRICK VENEER WALL
SCALE: 1" = 1'-0"

submittals / revisions

| no. | date | detail |
|-----|----------|----------|
| △ | 03/20/14 | RFI #4 |
| △ | 04/10/14 | RFI #53 |
| △ | 07/14/14 | RFI #100 |
| △ | 09/10/14 | RFI #124 |
| △ | 09/19/14 | RFI #133 |

la terra studio, inc.
12024
its project number
02.26.2014
date
rac; bhm
drawn by
mtb
checked by

