



submittals / revisions

| no. | date     | detail   |
|-----|----------|----------|
| 1   | 4-15-14  | RFI #39  |
| 2   | 7-03-14  | RFI #39  |
| 3   | 7-22-14  | RFI #109 |
| 4   | 12-30-14 | RFI #139 |

la terra studio, inc.

12024  
Its project number  
4.15.2014  
date  
bgp  
drawn by  
bgp  
checked by

registration




sheet title  
**FOUNDATION PLAN**  
sheet number

**FP-2**

**PIERCE ENGINEERING**  
STRUCTURAL ENGINEERING


BUS.: (940) 937-8600 132 N. MAIN STREET  
FIRM REG #: F-9186 CHILDRESS, TX 79201

# RUSK STREET

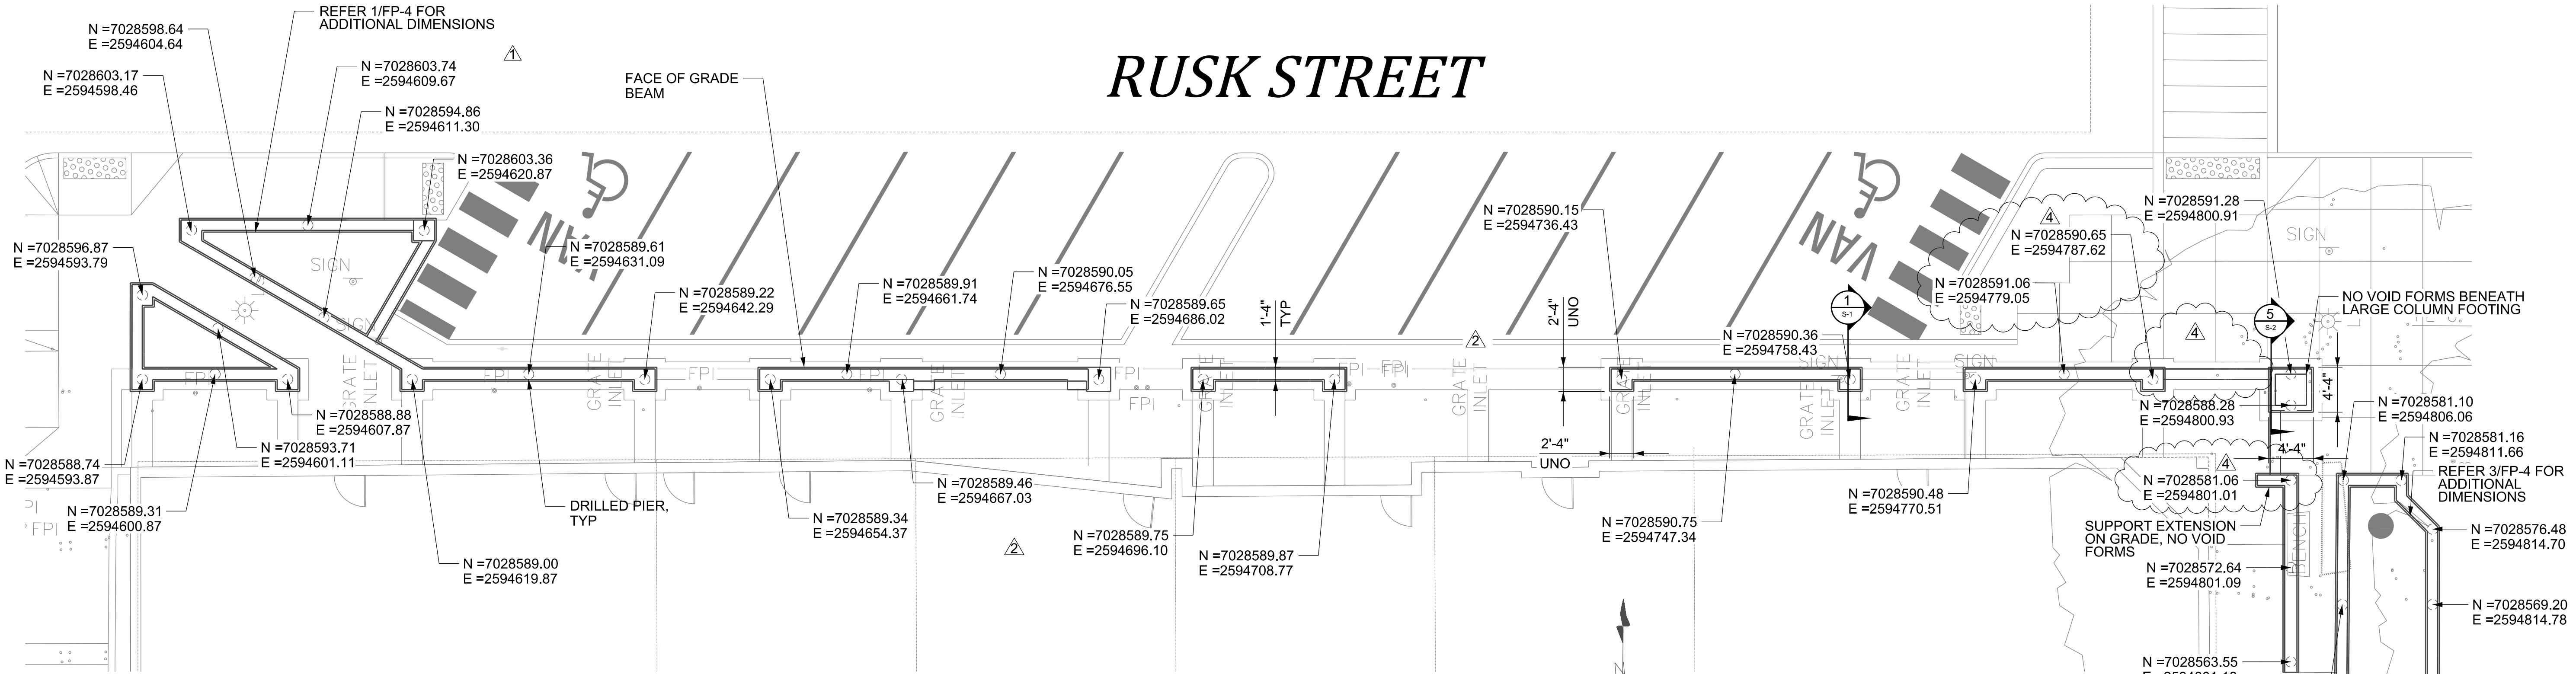

1 SOUTH RUSK WALL PLAN  
SCALE: 1/8" = 1'-0"

# RUSK STREET

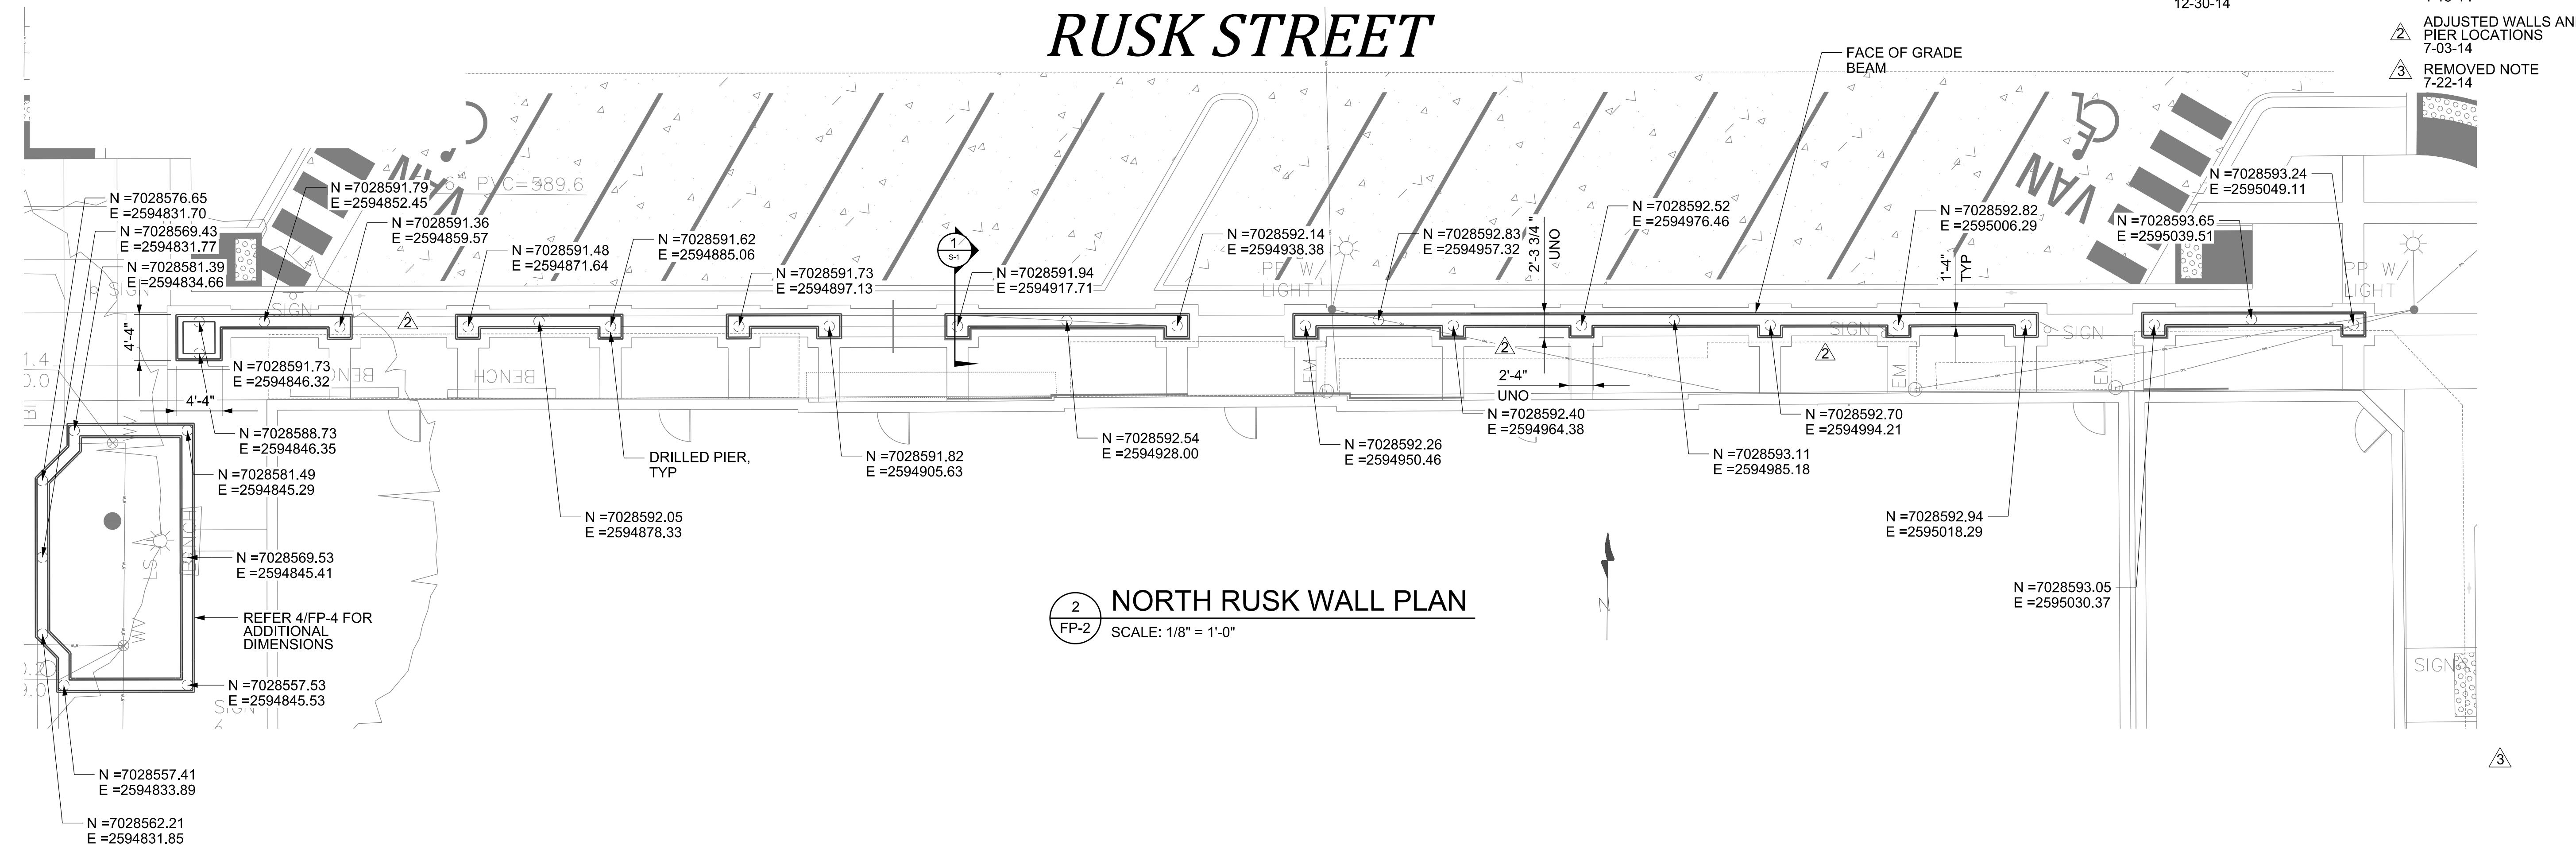

2 NORTH RUSK WALL PLAN  
SCALE: 1/8" = 1'-0"