


**GRADING PLAN LEGEND:**

- 580 ——— EXISTING GRADE CONTOUR
- 581 ——— FINISH GRADE CONTOUR
- 587.25 ——— FINISH SPOT GRADE
- 580.00 ——— SEE CIVIL FOR CROSS REFERENCE OF PROPOSED ELEVATION
- TS ——— TOP STEP
- BS ——— BOTTOM STEP
- TW ——— TOP OF WALL
- BW ——— BOTTOM OF WALL
- TC ——— TOP OF CURB
- G ——— GUTTER
- FF ——— FINISH FLOOR
- TCOL ——— TOP OF COLUMN

**sheet location**

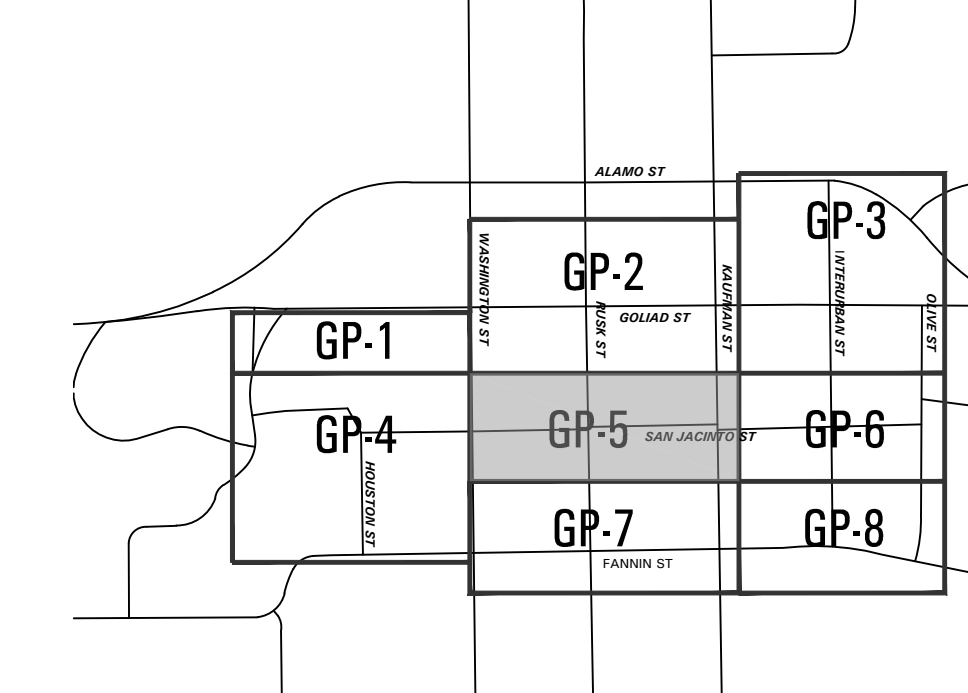

Symbol	Date	RFI #
△	08/29/14	RFI #120
△	09/03/14	RFI #122
△	09/16/14	RFI #121, #125
△	10/16/14	RFI #137
△	11/26/14	LASI #12
△	12/02/14	RFI #63
△	12/09/14	RFI #152
△	12/30/14	RFI #139

**Downtown Rockwall**  
 la terra studio Project #12024  
**streetscape improvements**  
 PHASE 2  
 rockwall, texas



submittals / revisions

no.	date	detail
△	04/02/14	RFI #29
△	05/02/14	RFI #77 WEST RUSK GRADING
△	05/08/14	RFI #20, #42, #43, #54
△	05/12/14	LASI #5
△	05/13/14	RFI #52
△	05/30/14	RFI #40
△	07/25/14	RFI #104
△	08/14/14	LASI #9
△	07/31/14	LASI #10

la terra studio, inc.

12024  
 its project number  
 02.26.2014  
 date  
 rac; bhm  
 drawn by  
 mth  
 checked by



**Grading Plan**  
 sheet number  
**GP-5**